
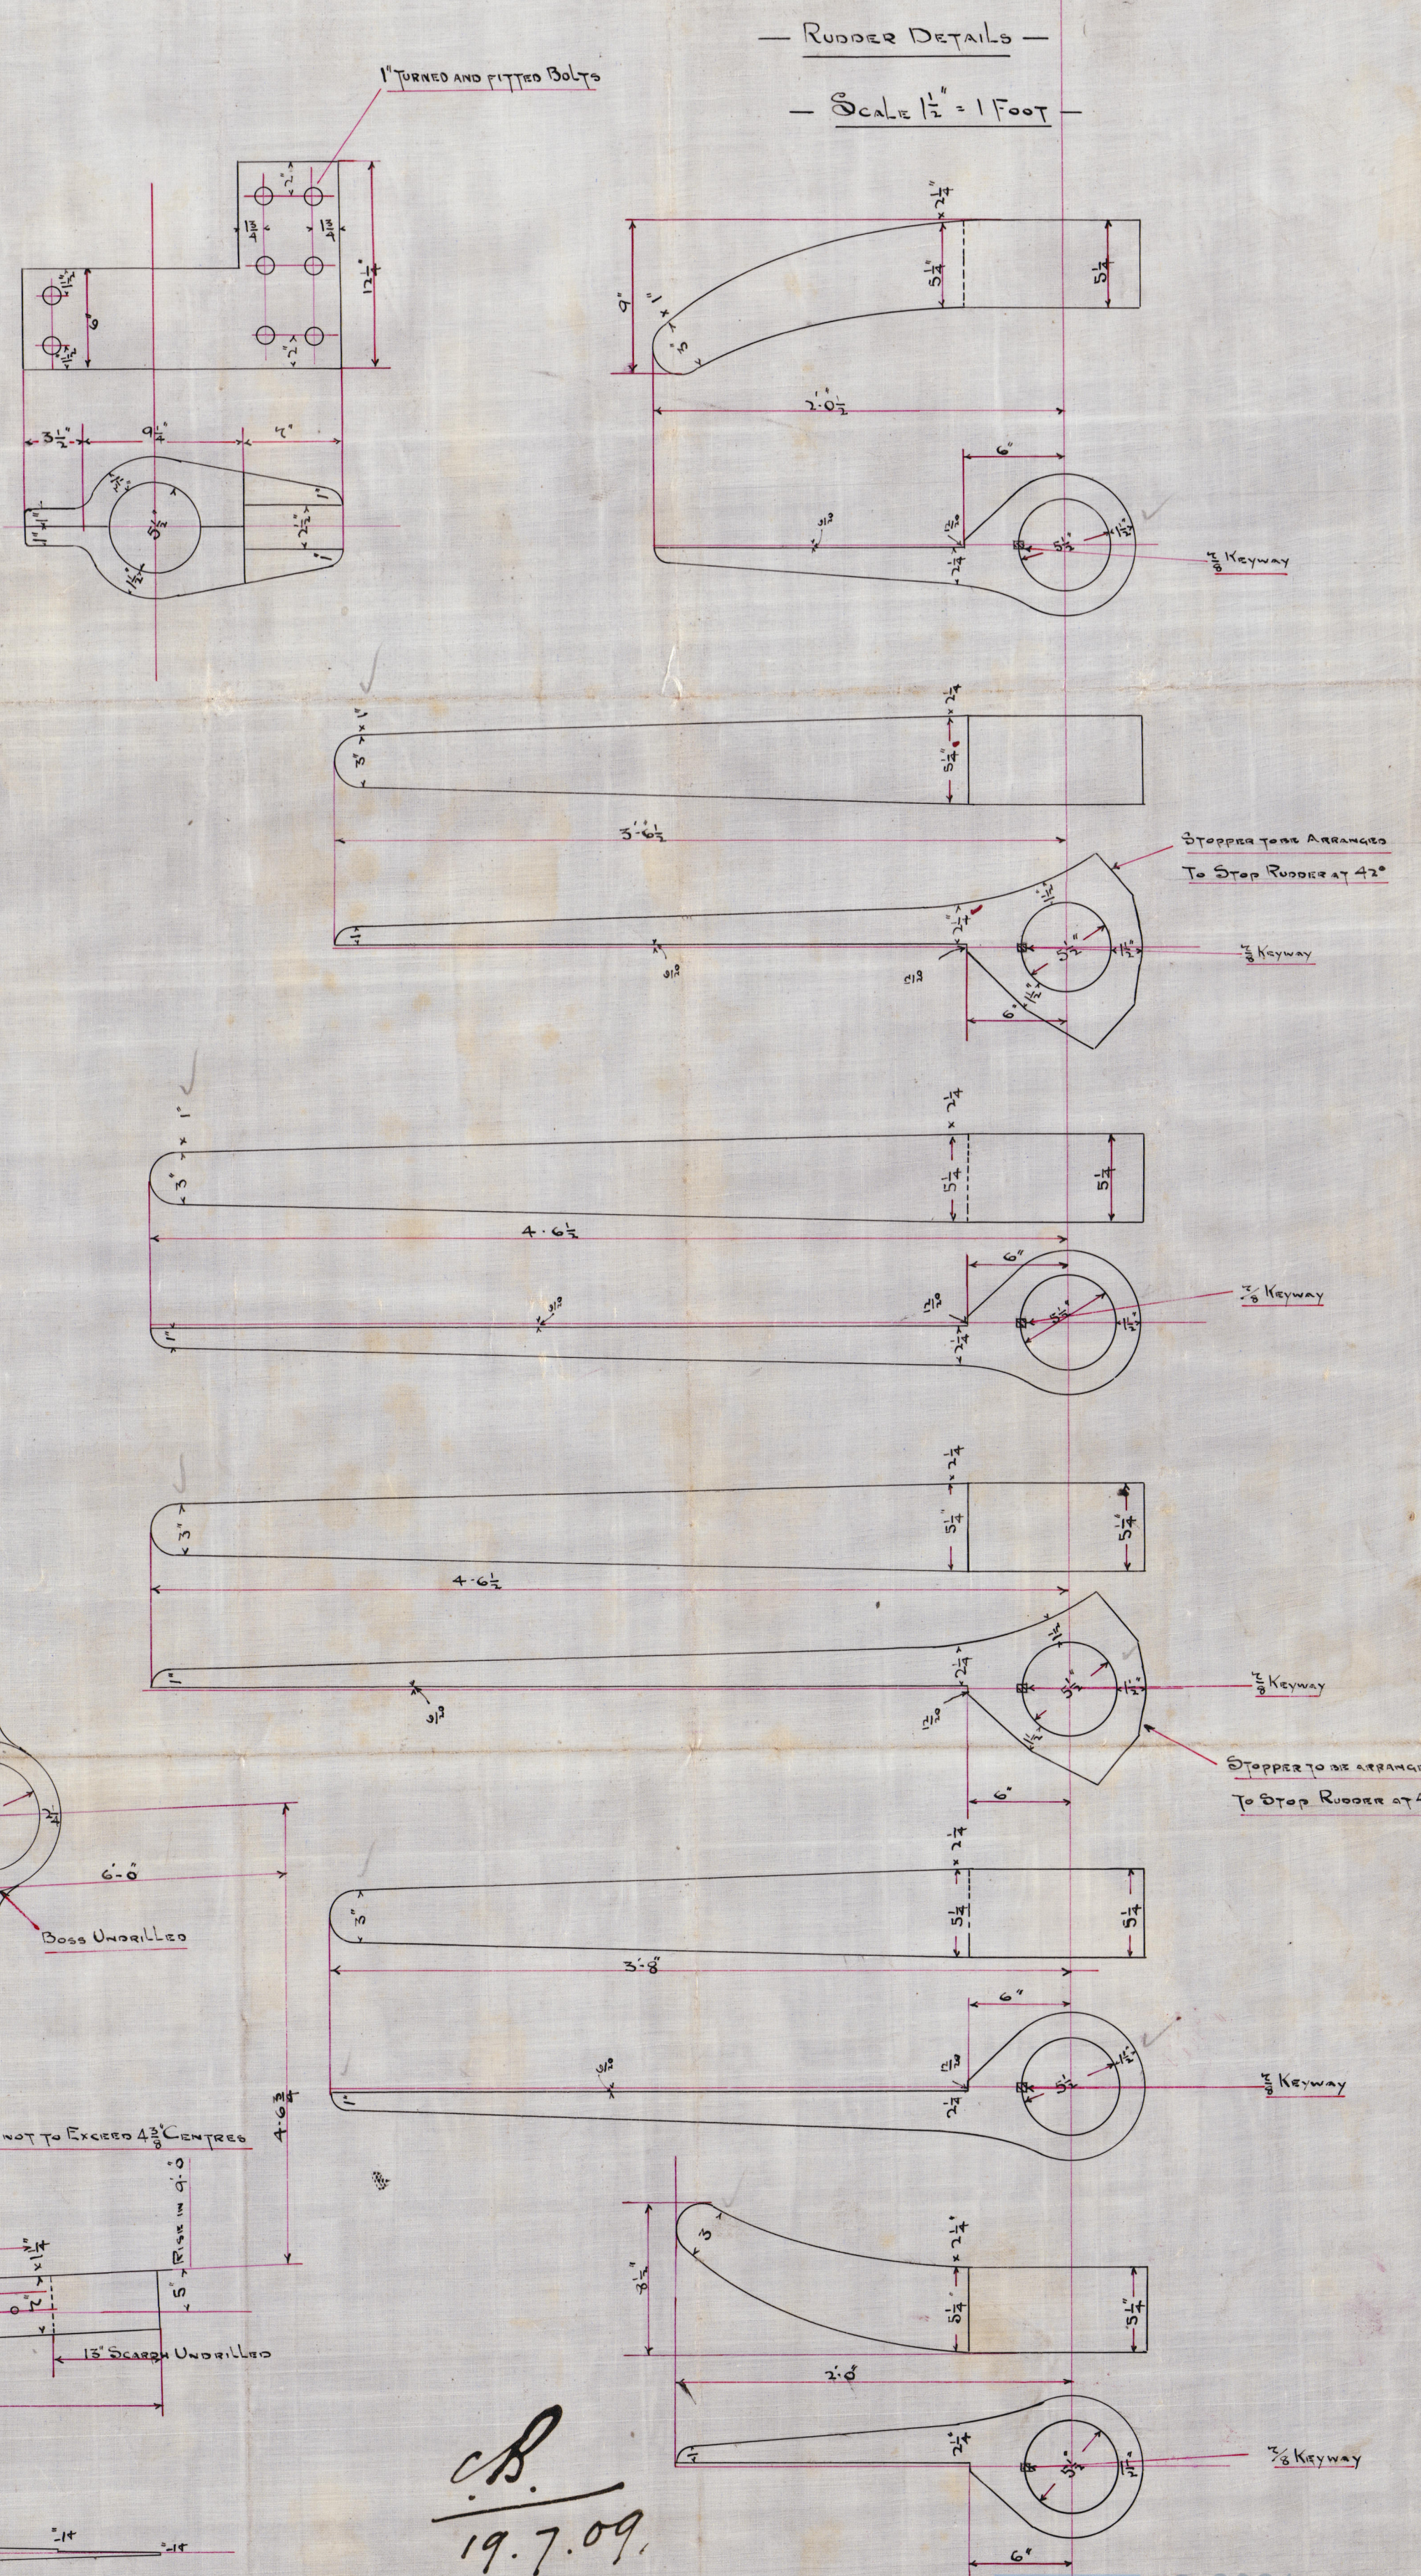


STERNFRAME AND RUDDER —


— N^o 263 Ship —

— SCALE $\frac{3}{4}'' = 1 \text{ FOOT}$ —

AREA OF RUDDER	41.5'
CENTER OF GRAVITY AFT CENTER OF RNTLS	2'11"
SPEED	11.5 KNOTS
RADIUS OF QUADRANT	3'10"

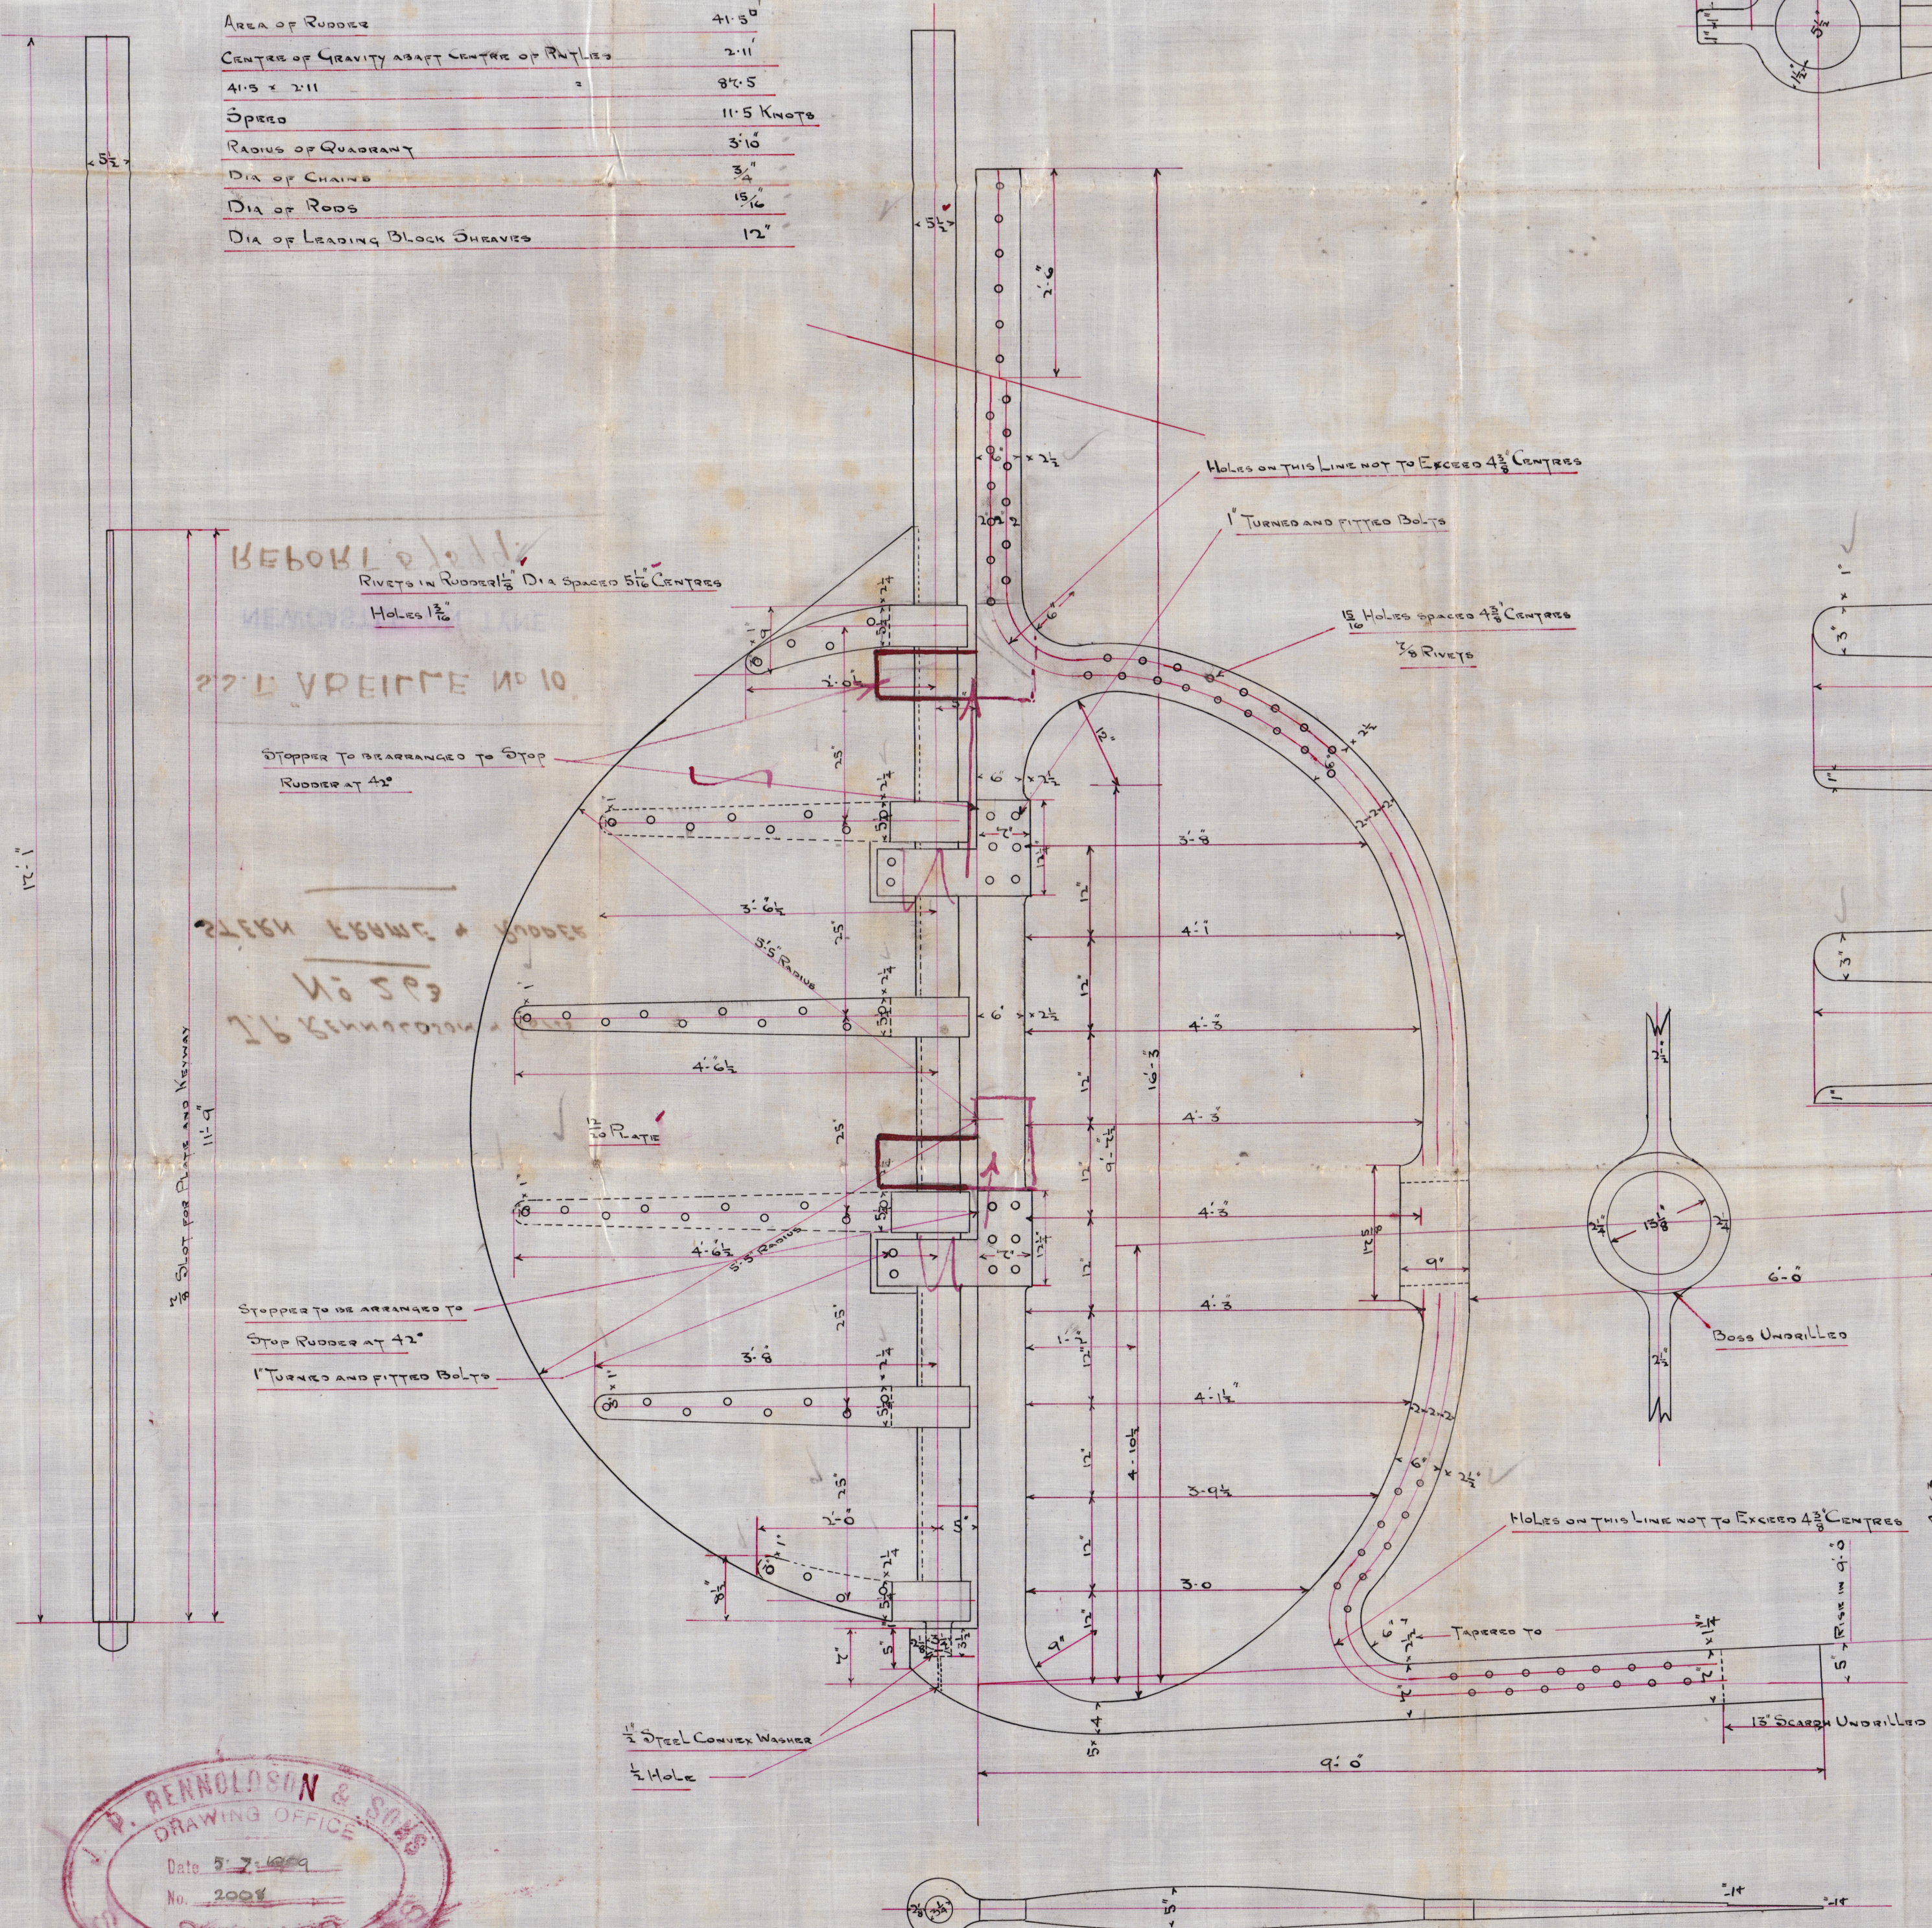

C.B.
19.7.09.

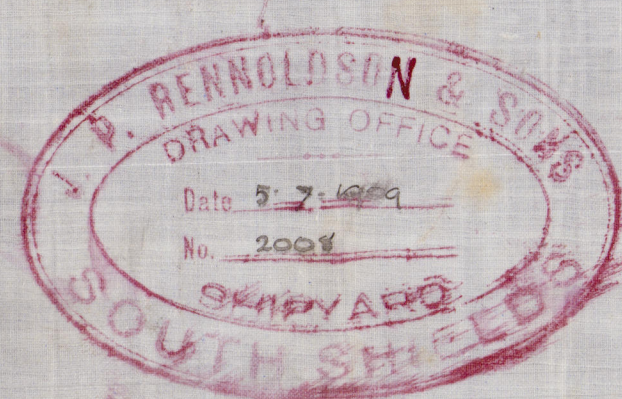

007403-007411-0046

J. P. RENNOLOSON & SONS

Nº 263

STERN FRAME & RUDDER

S.S.T. "ABEILLE No 10"

NEWCASTLE ON TYNE.

REPORT 57599.



© 2021

Lloyd's Register
Foundation