

GENERAL DIMENSIONS
 LENGTH S. P. 430'-0"
 BEAM MOULDED 58'-0"
 DEPTH TO UPPER DECK AT SIDE 33'-3"

ALTERATIONS			
NO.	DATE	DESCRIPTION	APPROVED
1	11-21-18	ROOF DECK REVERTED CHANGED	
2		FORE PEAK CHANGED TO FRESH	
3		ENGINE WORKSHOP STORES REVERSED	
4	11-14-19	ADDED Y.P. DECKING ON BOAT	
5	11-17-19	OK. & CASING TOP	
6		FORE PEAK CHANGED TO FUEL OIL	
7	11-24-19	ROTARY PAINTS ON BOAT PK. CHANGED TO WELIN PAINTS (CONT'D ONLY)	
8	12-16-19	TANKS NUMBERED 1-10 INSTEAD OF 1-10	
9	1-23-20	ELIMINATED FROM FORE PEAK	

MATERIAL

CHARGE

ACTION

S.S. ATLANTIC SUN


PLAN PRINTS											
PRINT NO.	DEPT.	NO. SHEET	DEPT.	NO. SHEET	DEPT.	NO. SHEET	DEPT.	NO. SHEET	DEPT.	NO. SHEET	DEPT.

HULL DIVISION

GENERAL ARRANGEMENT

SCALE - ARRANGEMENT 1/16" = 1 FT.
 SCALE - DETAIL 1/32" = 1 FT. DATE JULY 20, 1919
 SUN SHIPBUILDING CO.
 CHESTER, PA. U.S.A.

DR. NO. 20-7001-A
 Lloyd's Register
 Foundation

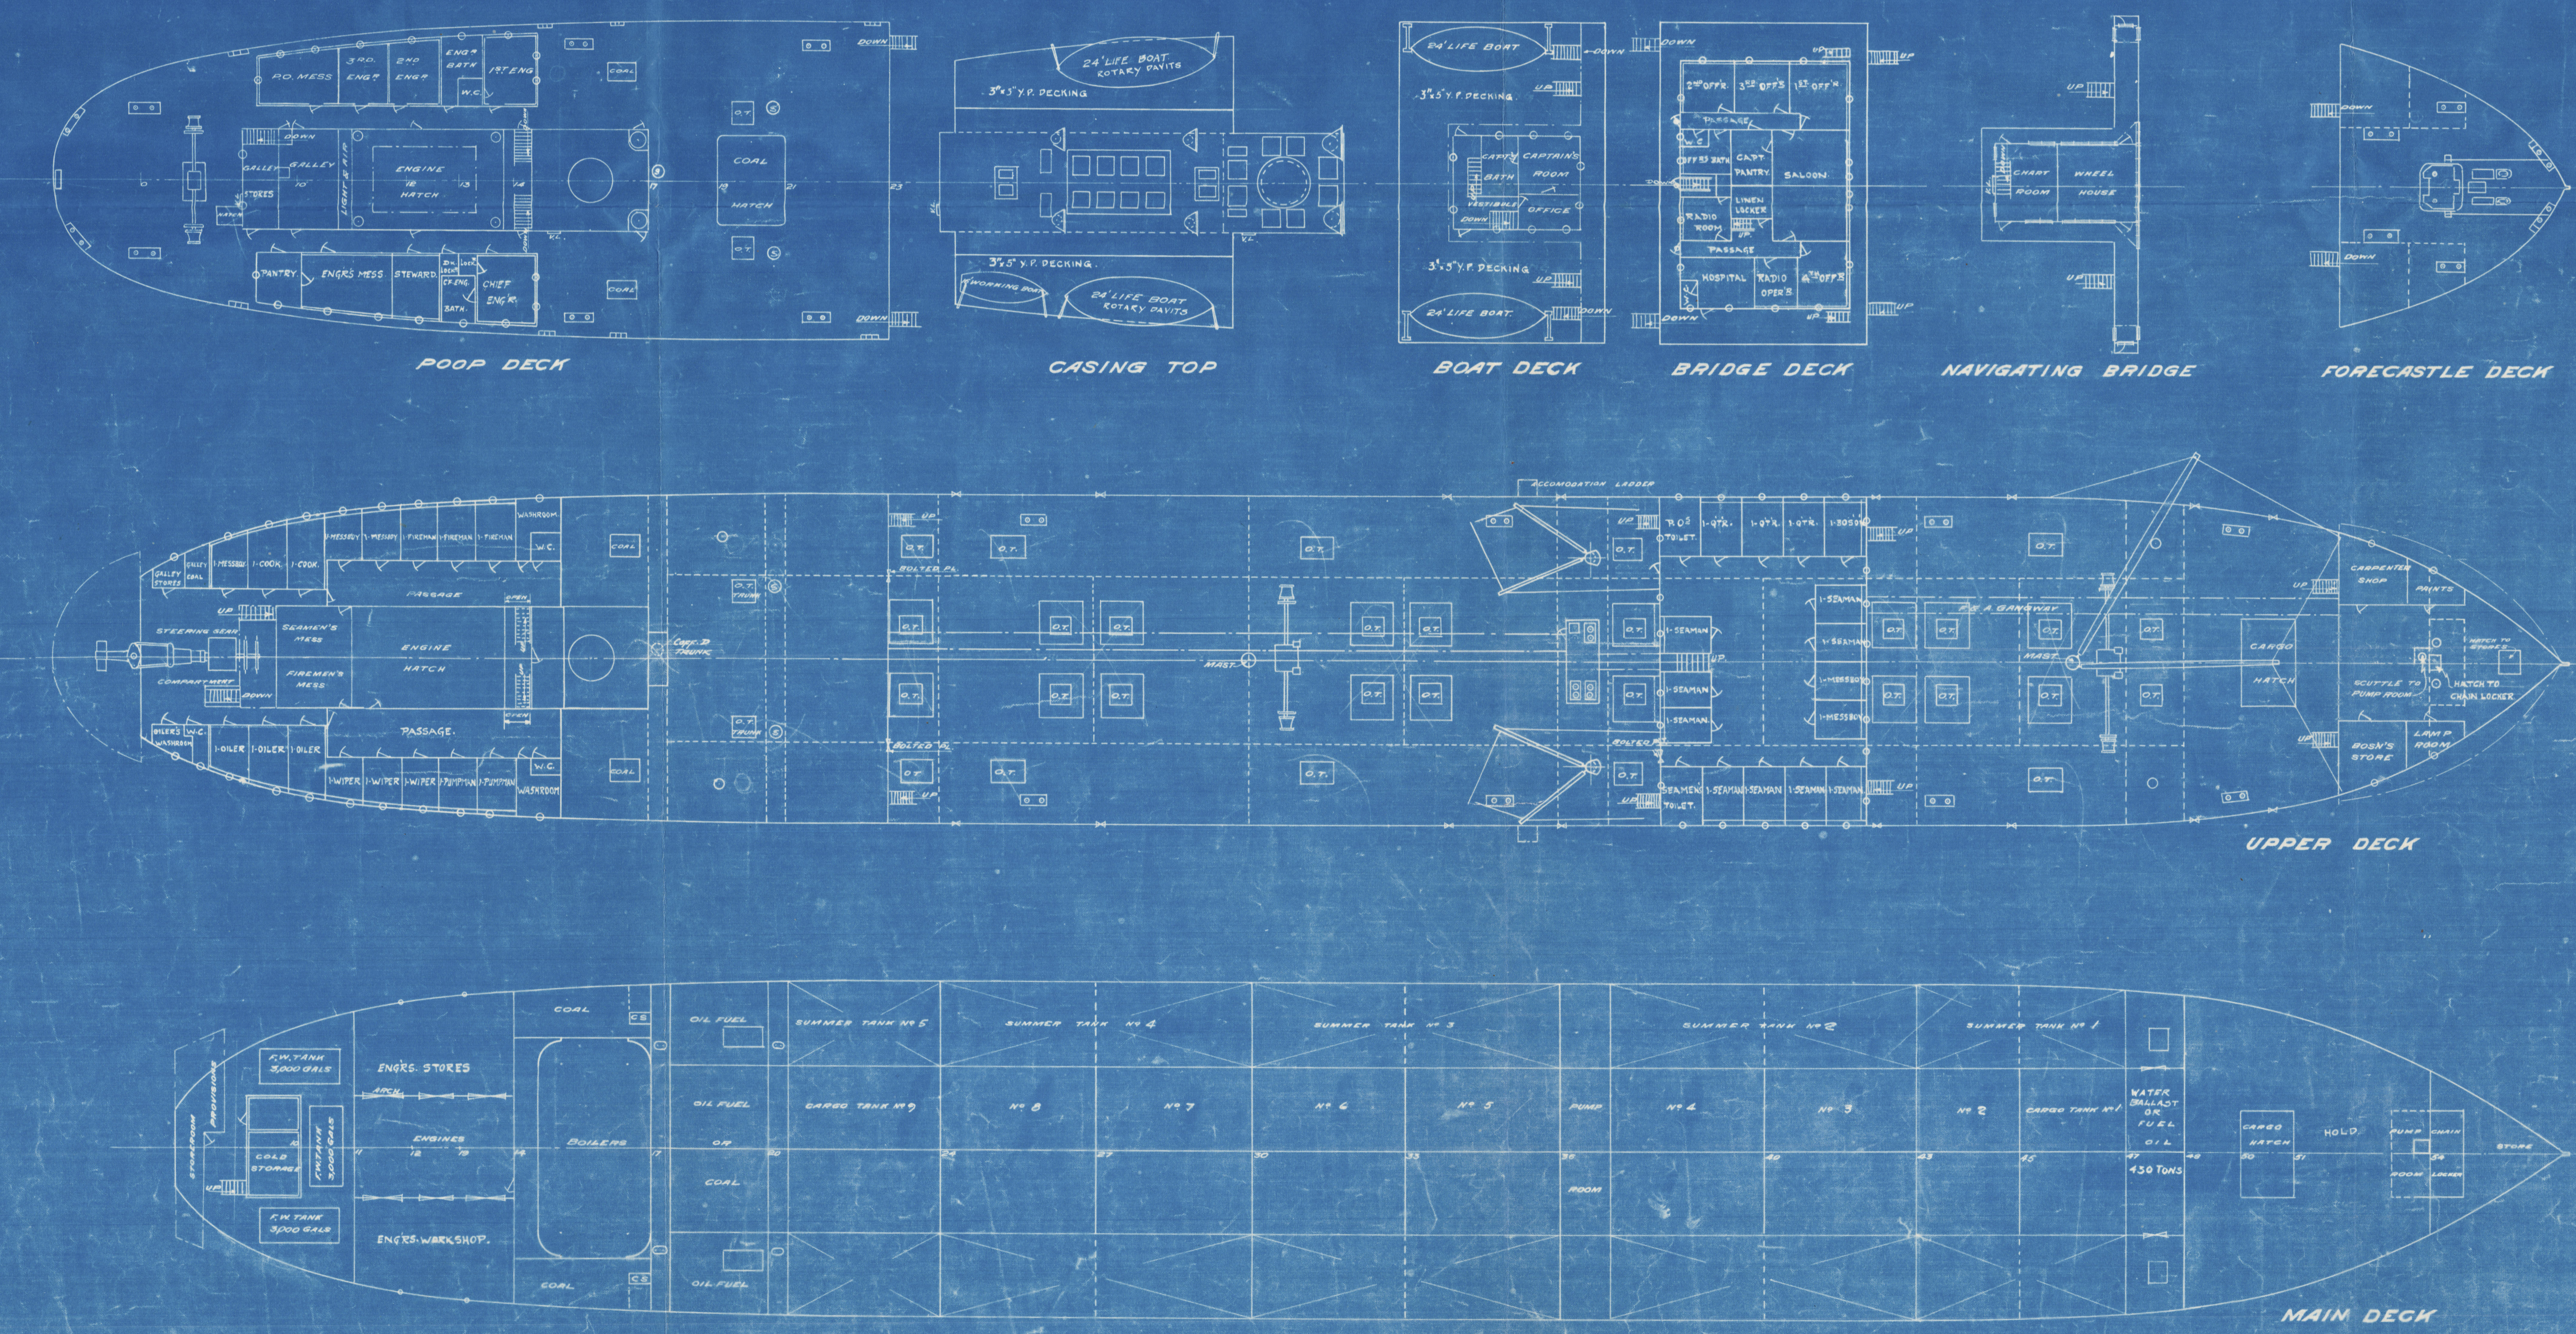

General Arrangement

S. S. "Atlantic Sun"

Phl. 3767

→ "PANUCO"
Ex



© 2021

Lloyd's Register
Foundation

007403-007411-0150