

15-2-06

15. 2. 06
 4. 8. 06
 18. 12. 06
 31.

NUMBERS

$\frac{1}{2} S = 26.39$ ✓
 $\frac{1}{2} G = 55.62$ ✓
 $D = 33.10$ ✓

115.11 ✓
 - 7.0
 108.11 ✓ = 12° 15'

LENGTH = 423 ✓
 45730 ✓ = 210° 15'

EQUIPMENT N°


115.11 ✓
 LENGTH = 423 ✓
 45691 ✓

Rod 375 ✓
 BRIDGE 1875 ✓ 79.15 = 330 ✓
 FOLE 11875 ✓


DARK HOUSE 62.7
 434 ✓
 52255 EQUIP. N°

$\frac{1}{2} \left\{ \begin{array}{l} U.D. \\ D \end{array} \right. \begin{array}{l} 12.77 \\ 16.82 \end{array}$

EQUIPMENT			
2 BOWER	ANCHORS	STOCKLESS	68 ✓ VENTS.
1	"	"	58 1/2 ✓ "
1	STREAM	EX. STOUT	19 ✓ "
1	KEDGE	"	8 ✓ "
270	FT.	STUD CHAIN CABLE	2 5/8 ✓ "
90	"	STREAM WIRE	5 ✓ "
120	"	STEEL WRE	5 1/2 ✓ "
of 90	"	HAWSEERS	8 ✓ "
of 90	"	WARDS	7 ✓ "

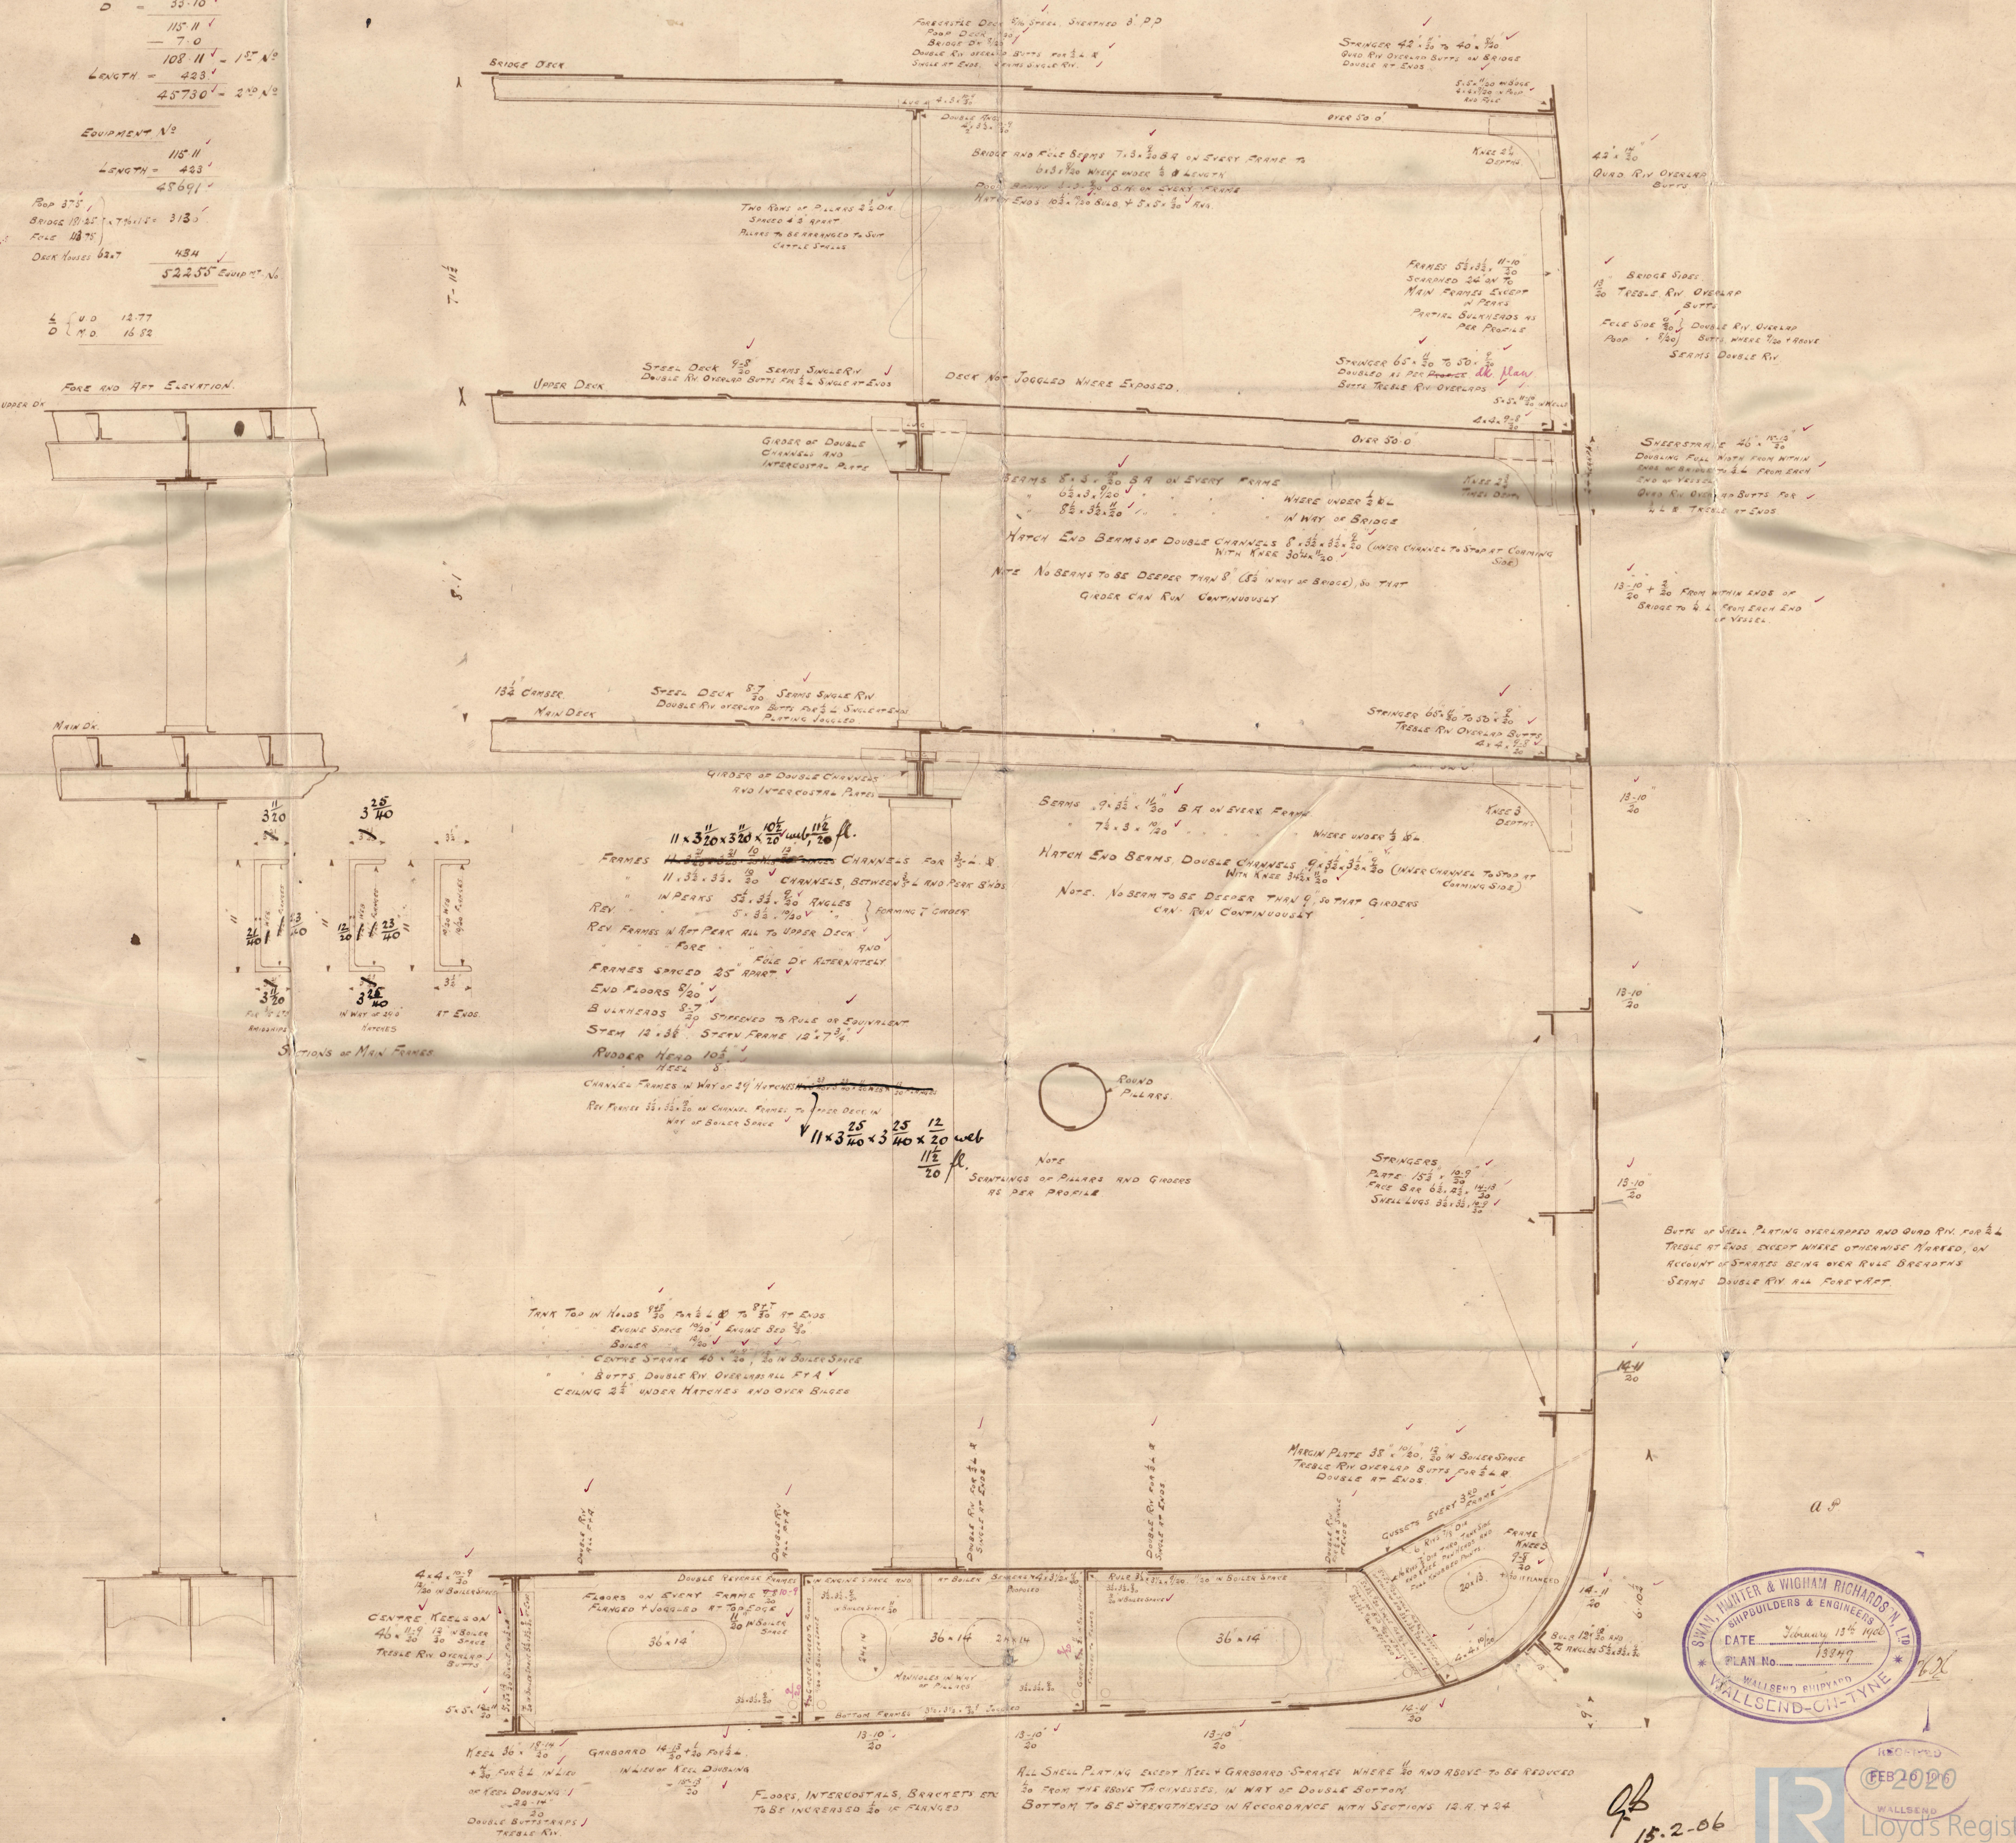

SWAN, HUNTER & WIGHAM RICHARDS N. LTD.
SHIPBUILDERS & ENGINEERS
DATE February 13th 1946
PLAN No. 13849
WALLSEND SHIPYARD
WALLSEND-CUN-TYNE



RECEIVED
WALLSEND

Lloyd's Register
Foundation

007412 - 007421 - 0080


Newcastle.

Messrs. Swan Hunter & Wigham
Richardson Ltd.

No. 119 ship.


Midship Section.

S/S "Ganelon"

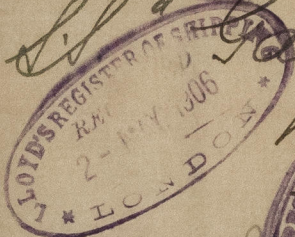



Kwz 53953

New CITY OF BRITAIN.

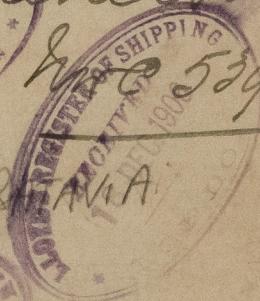

S/S "R10 TEVCO"

Kwz 53953

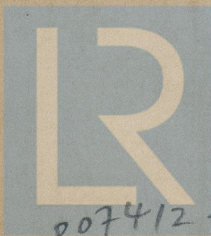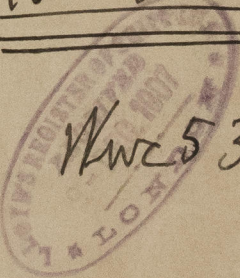


© 2020

Lloyd's Register
Foundation

007412-007421-0080

779

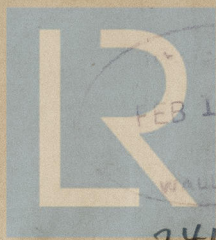

© 2020

FEB 16 1906

Lloyd's Register
Foundation

007412-007421-0080