
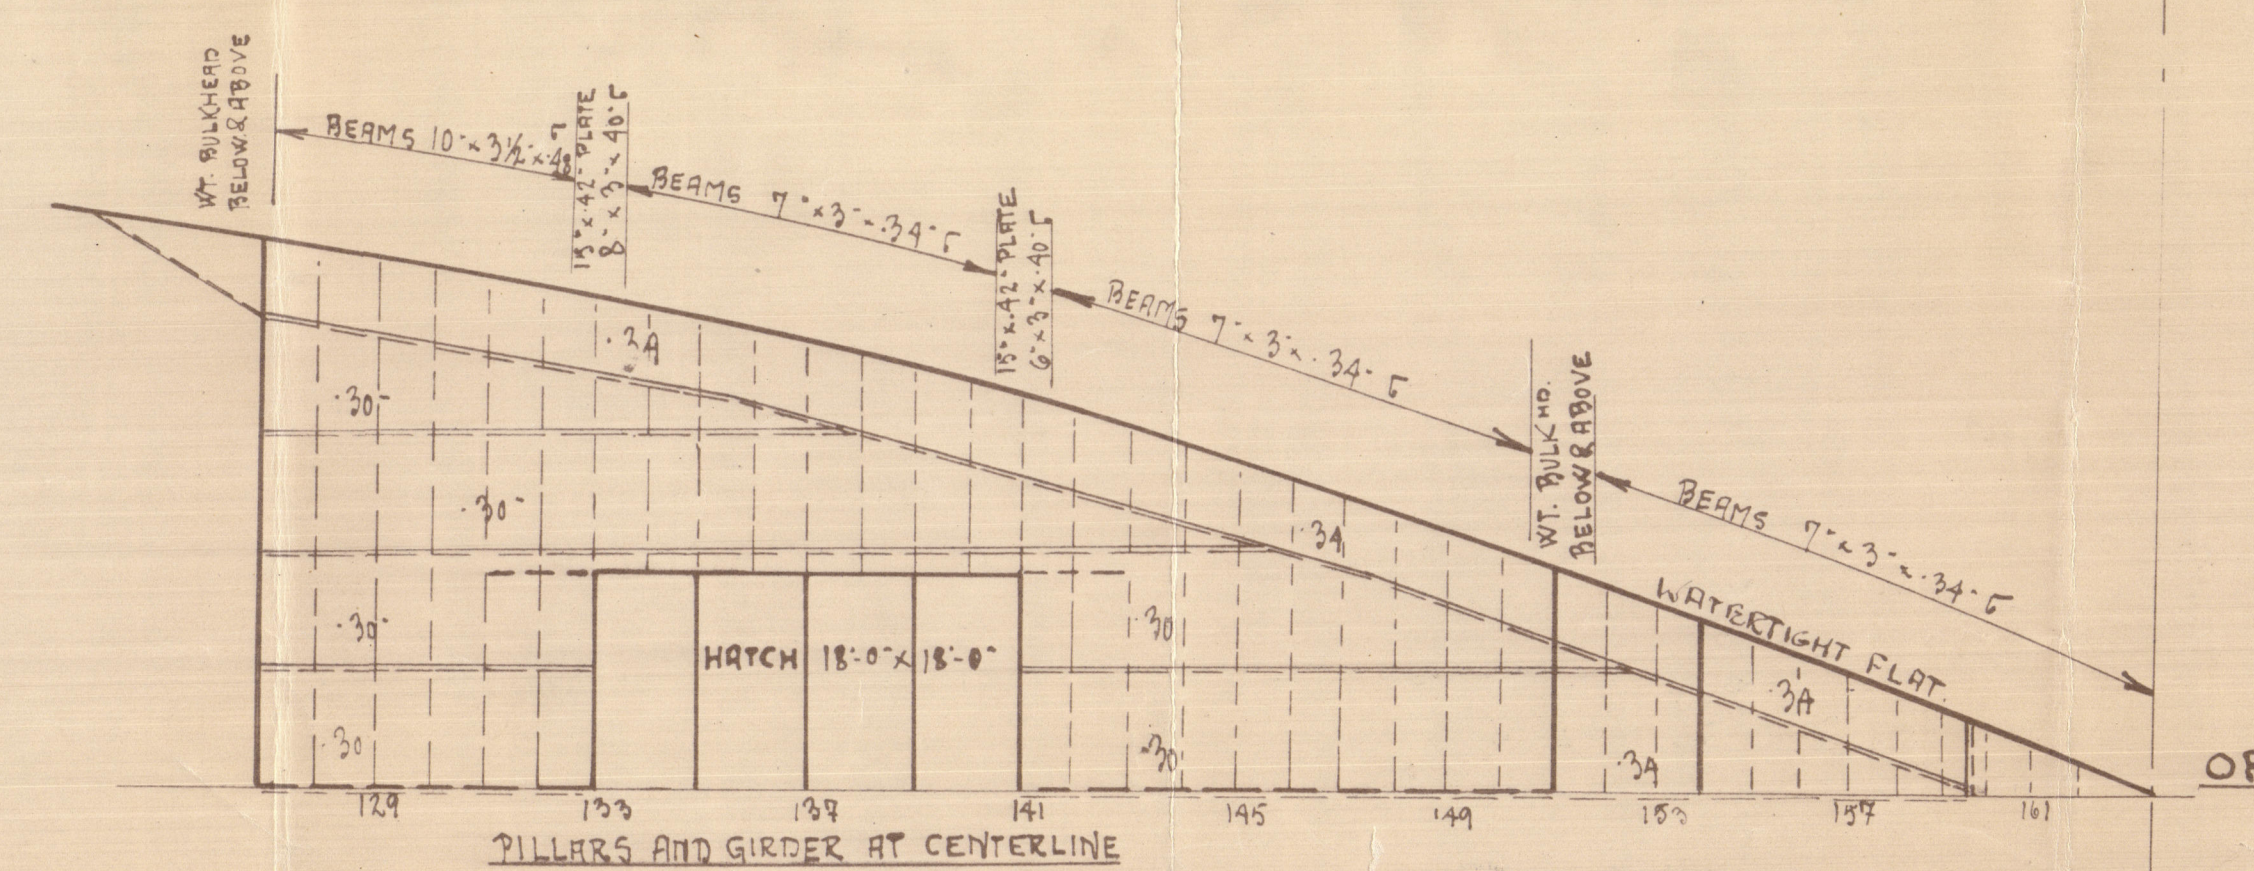
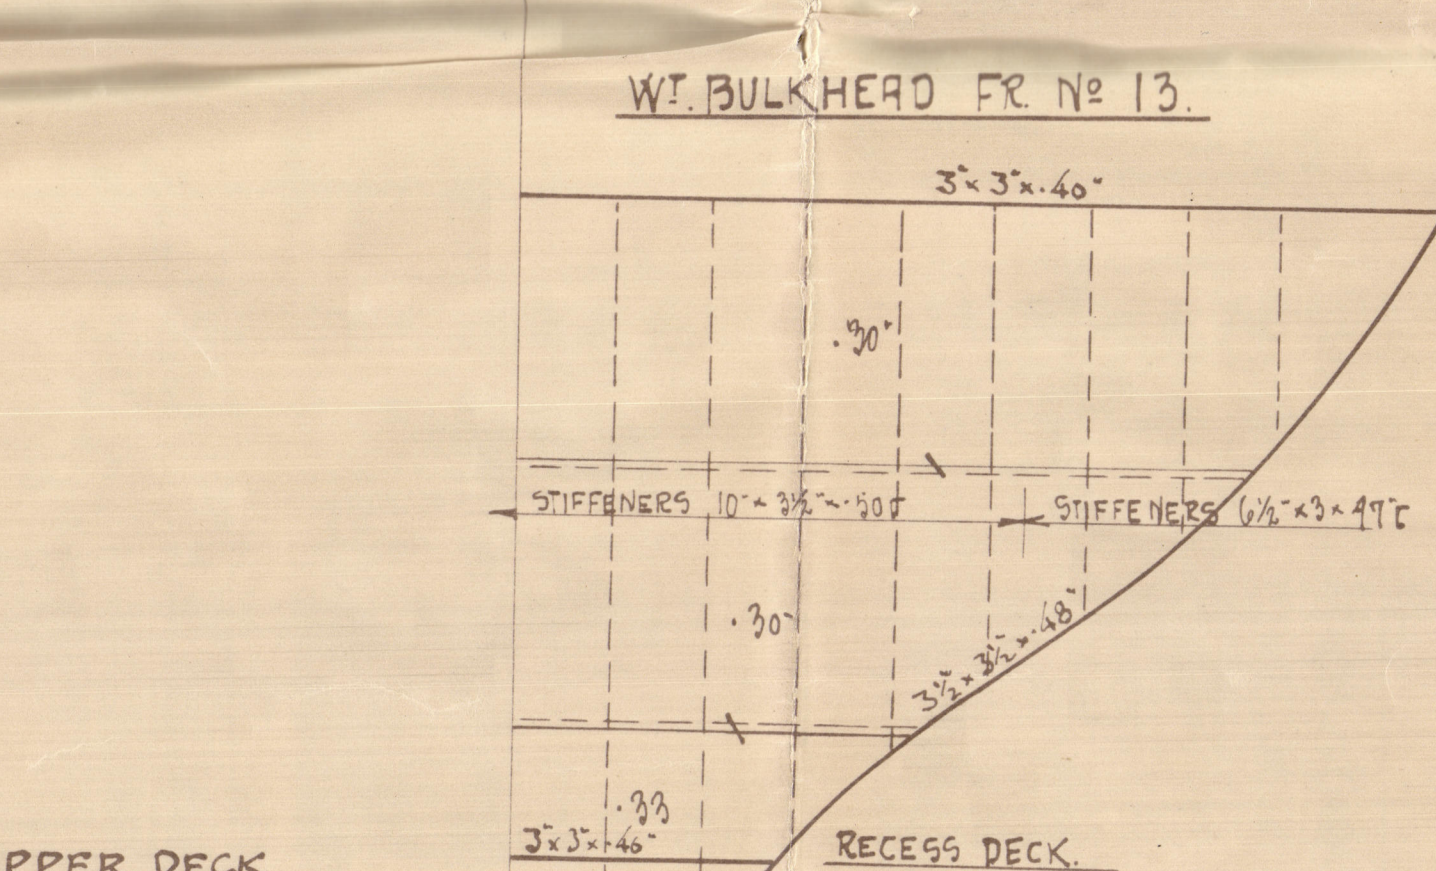
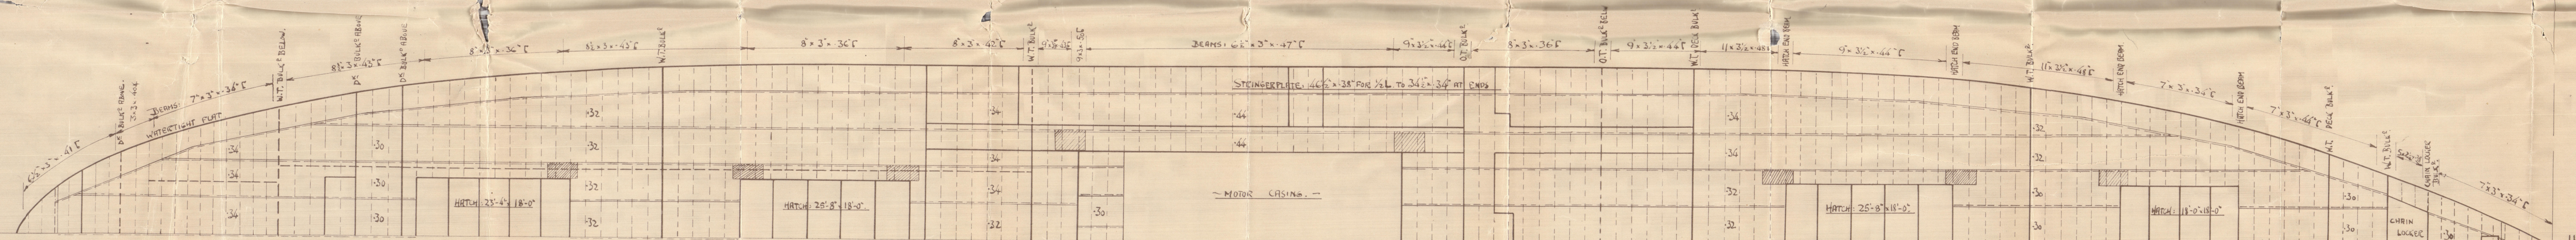
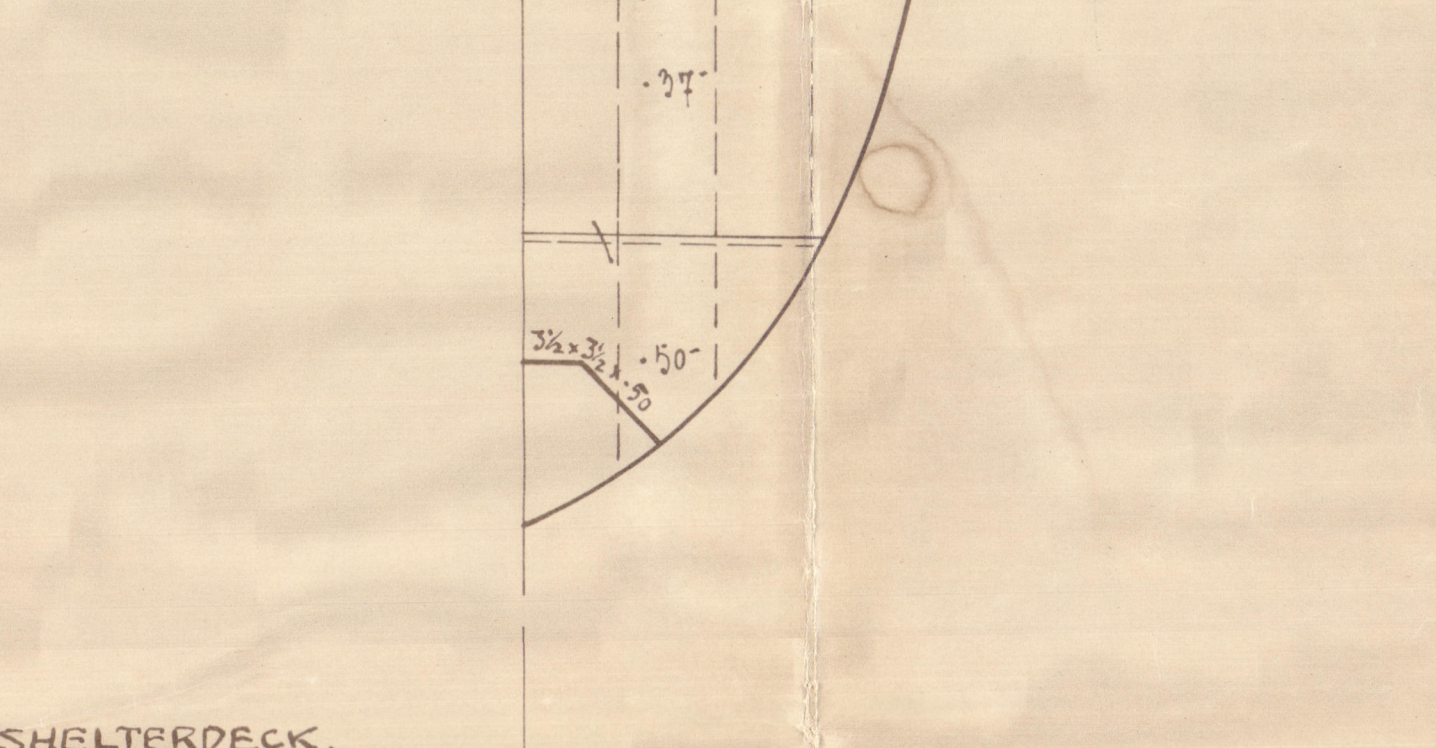
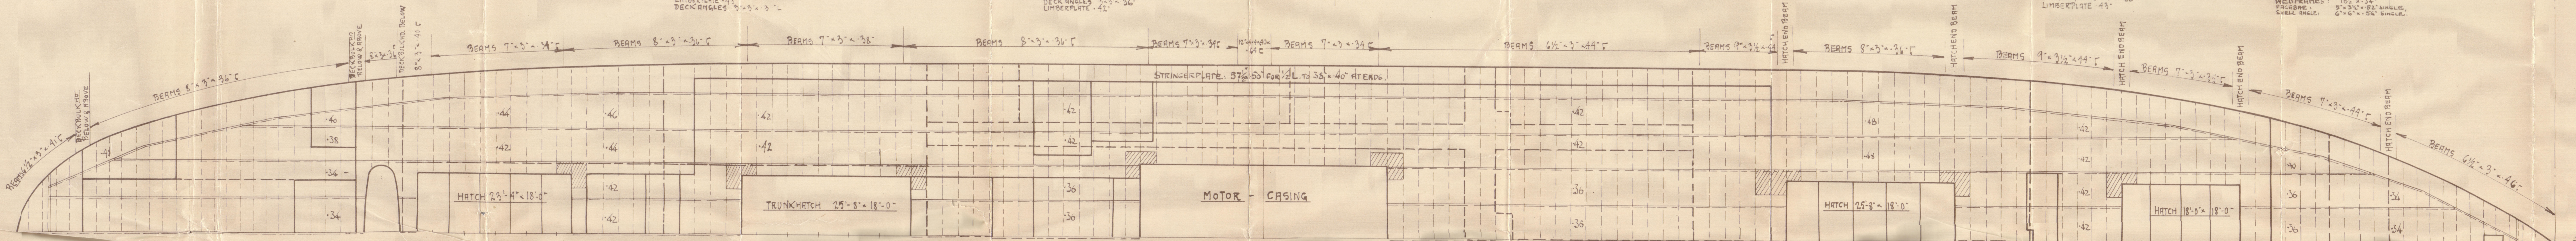
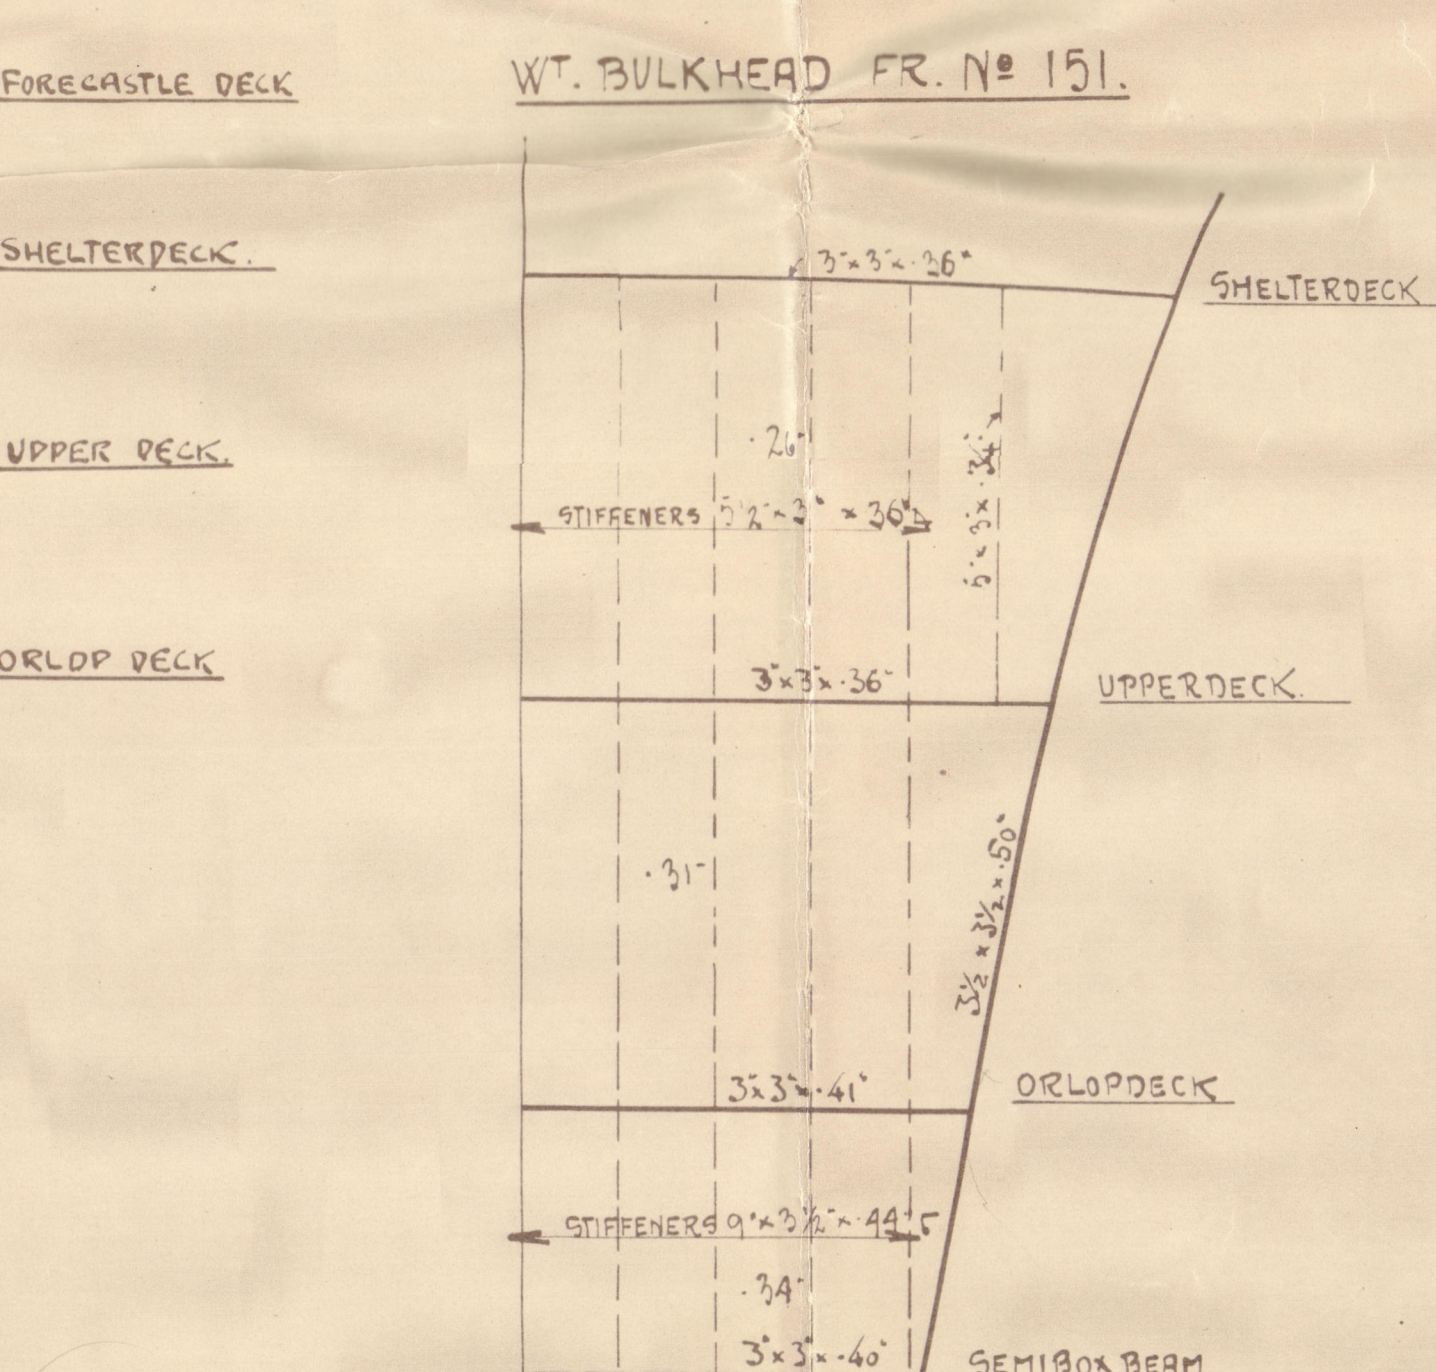
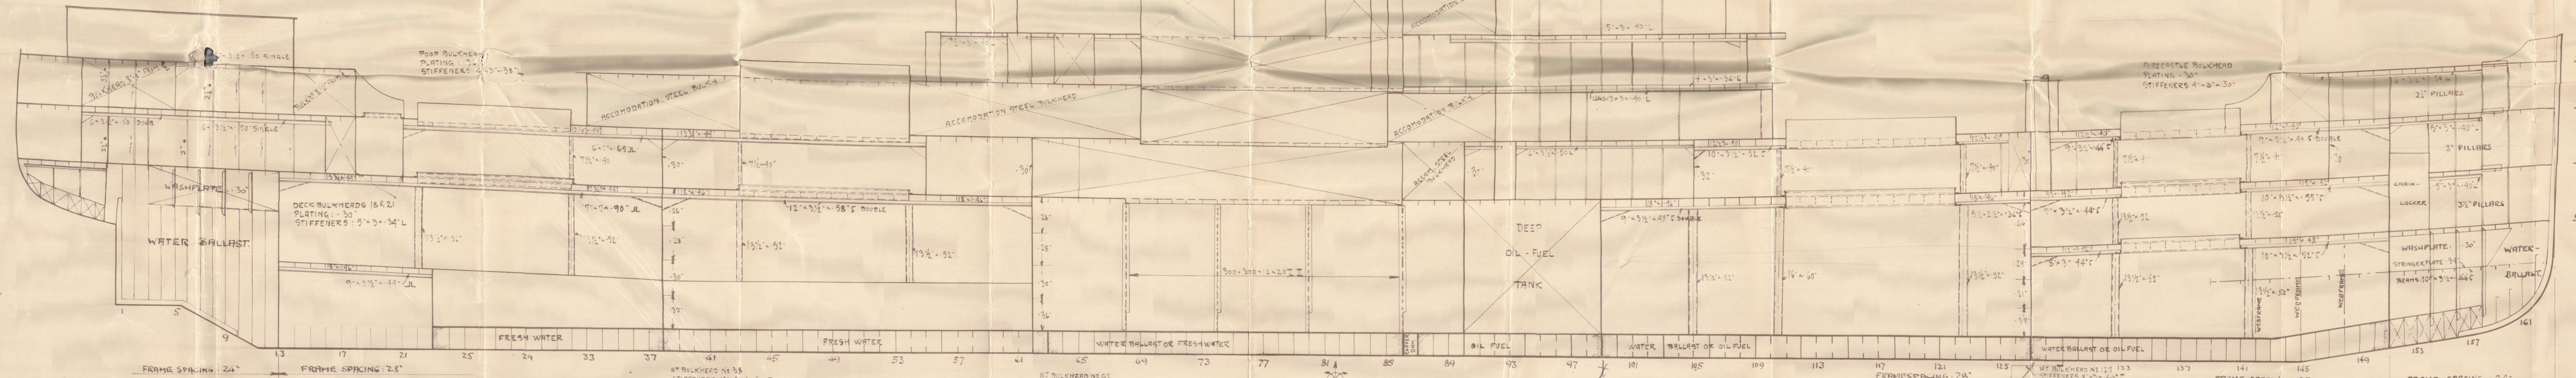
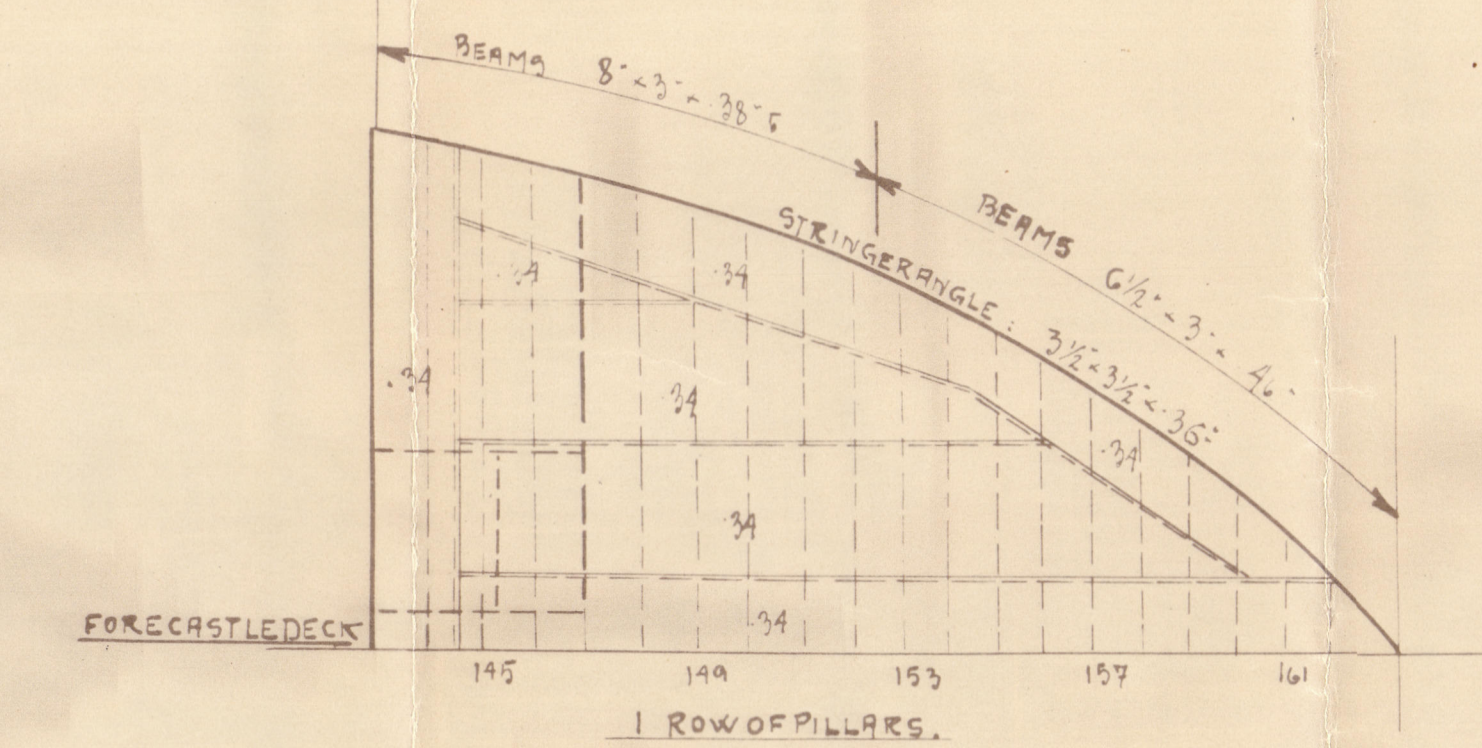
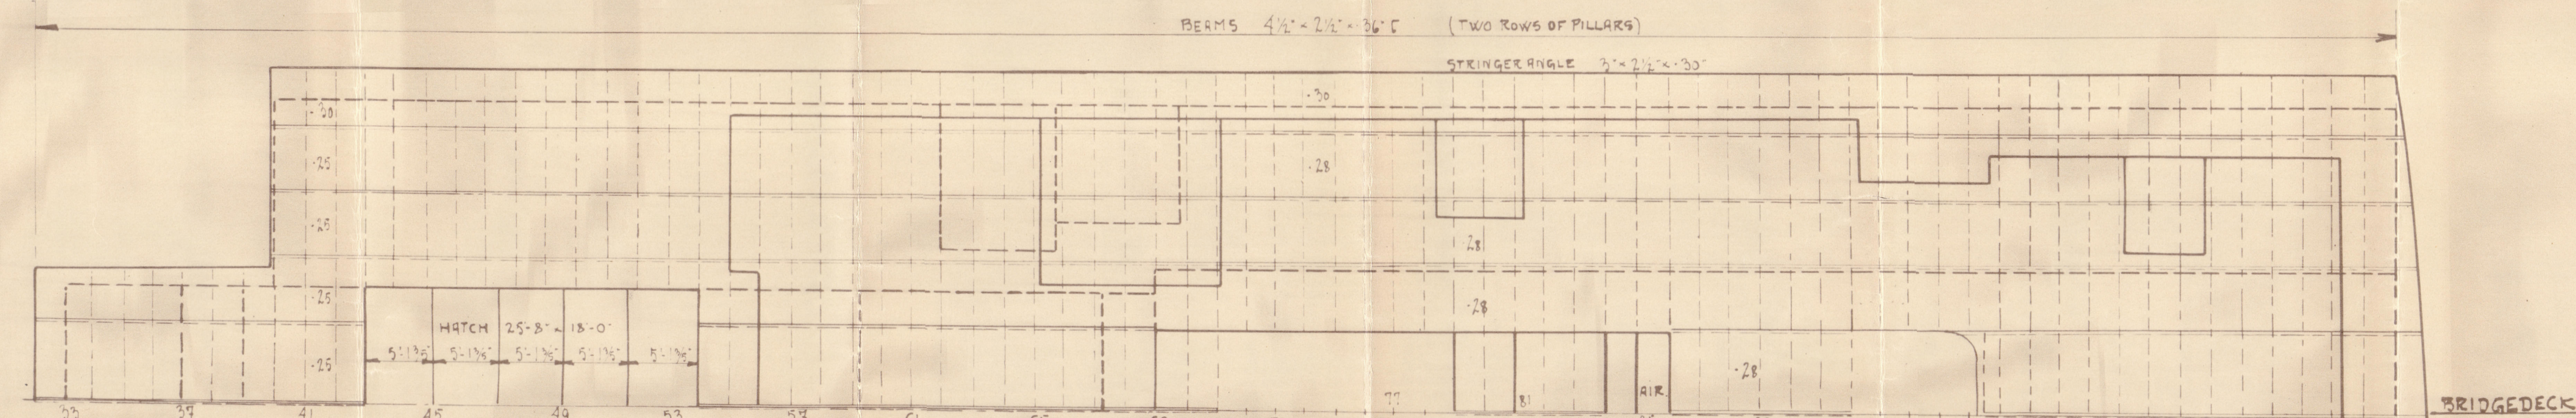


1/8 - 1/8 "SANTA INEZ" & "SANTA RITA":

PROFILE, DECK PLANS ETC. -

SCALE: 1/8" = 1 FOOT.

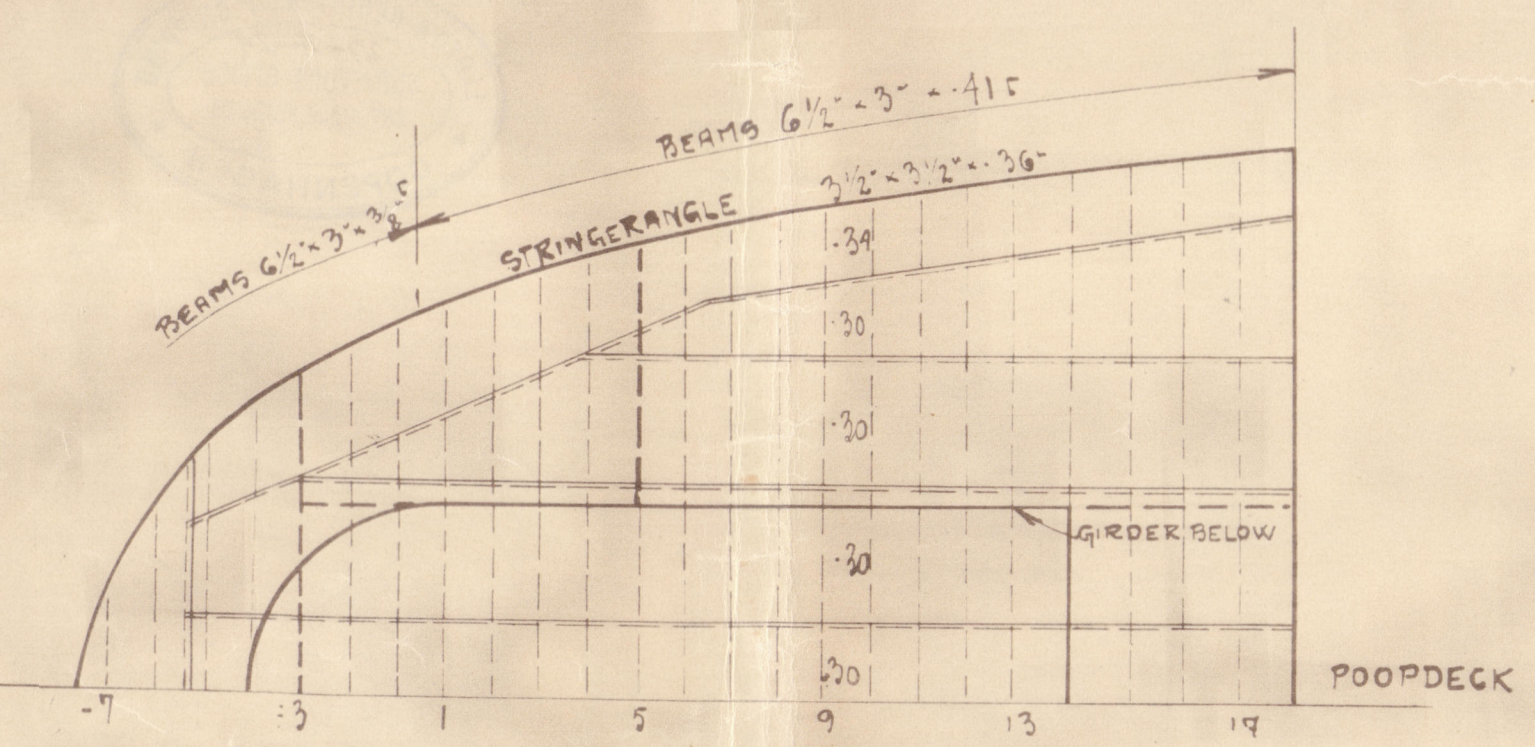


Mr. "SANTA INEZ"

of New York

Brunmeier & Wain
Copenhagen No 552.

Longitudinal Section
& decks, as built.

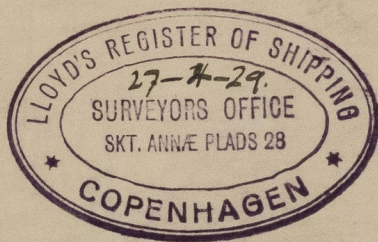

© 2020

Lloyd's Register
Foundation

007412 - 007421 - 0154