




M. V. "MARINULA".
GENERAL ARRANGEMENT. [AS FITTED].



PROFILE, POOP & FORECASTLE & UPPER DECK.


SCALE $\frac{1}{8}$ INCH = ONE FOOT.

LENGTH B. P. 440'-0". BREADTH M^{ld} 54'-0". DEPTH M^{ld} 36'-6".

 


PROFILE.


POOP DECK.

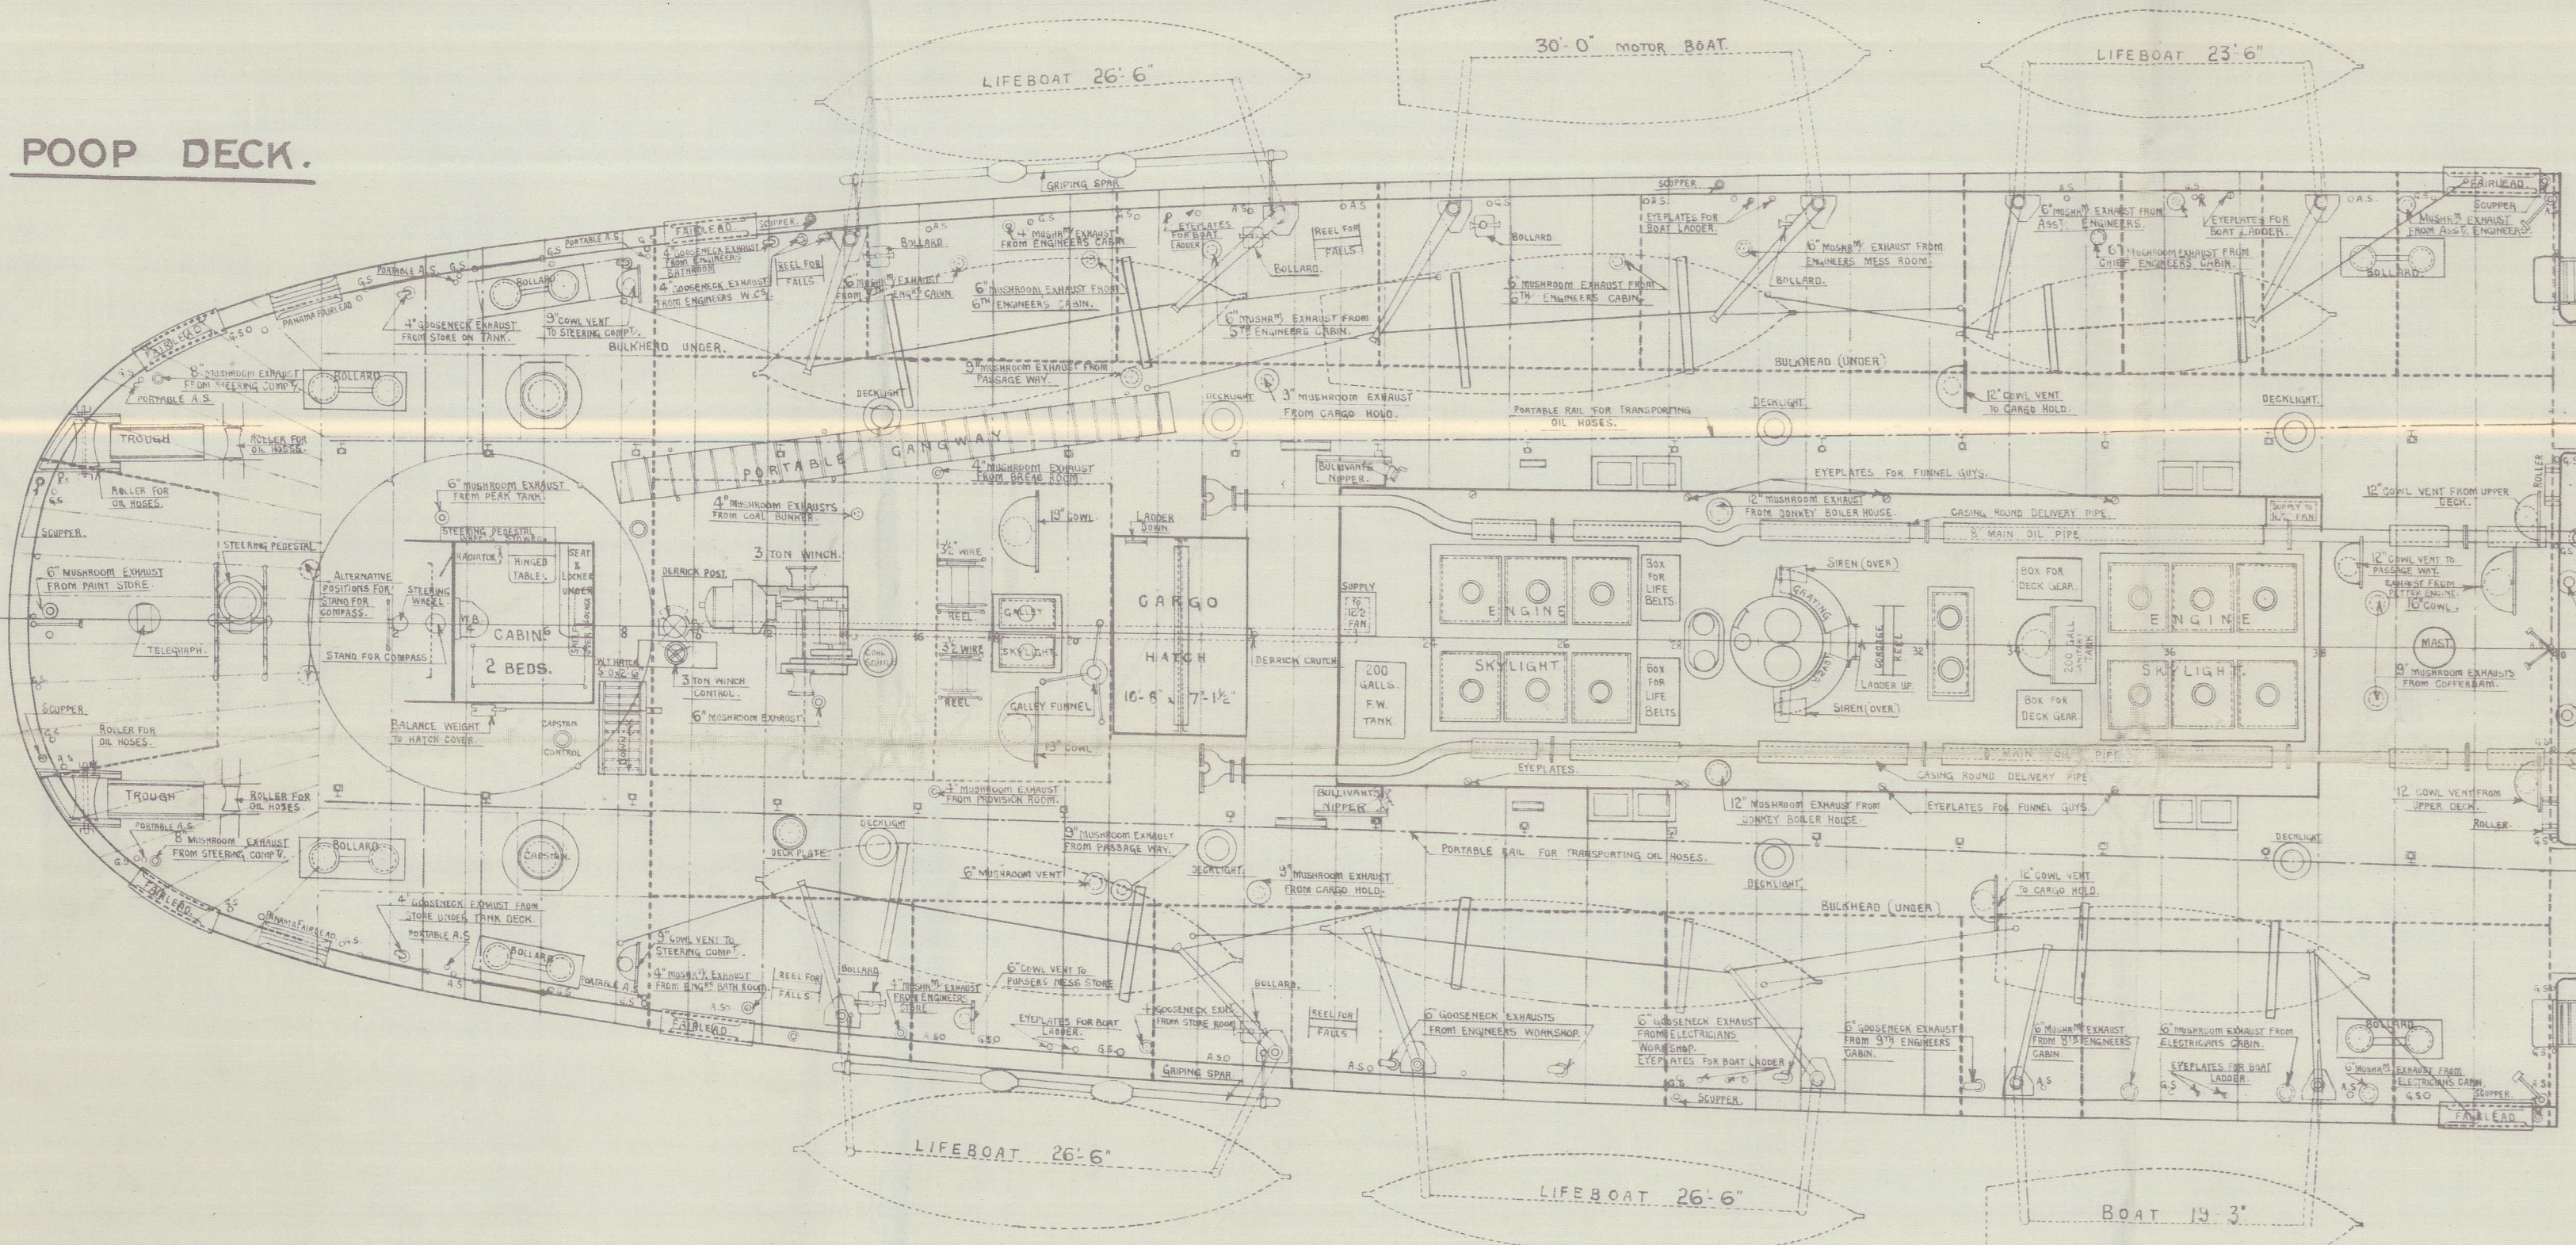


FORECASTLE DECK.

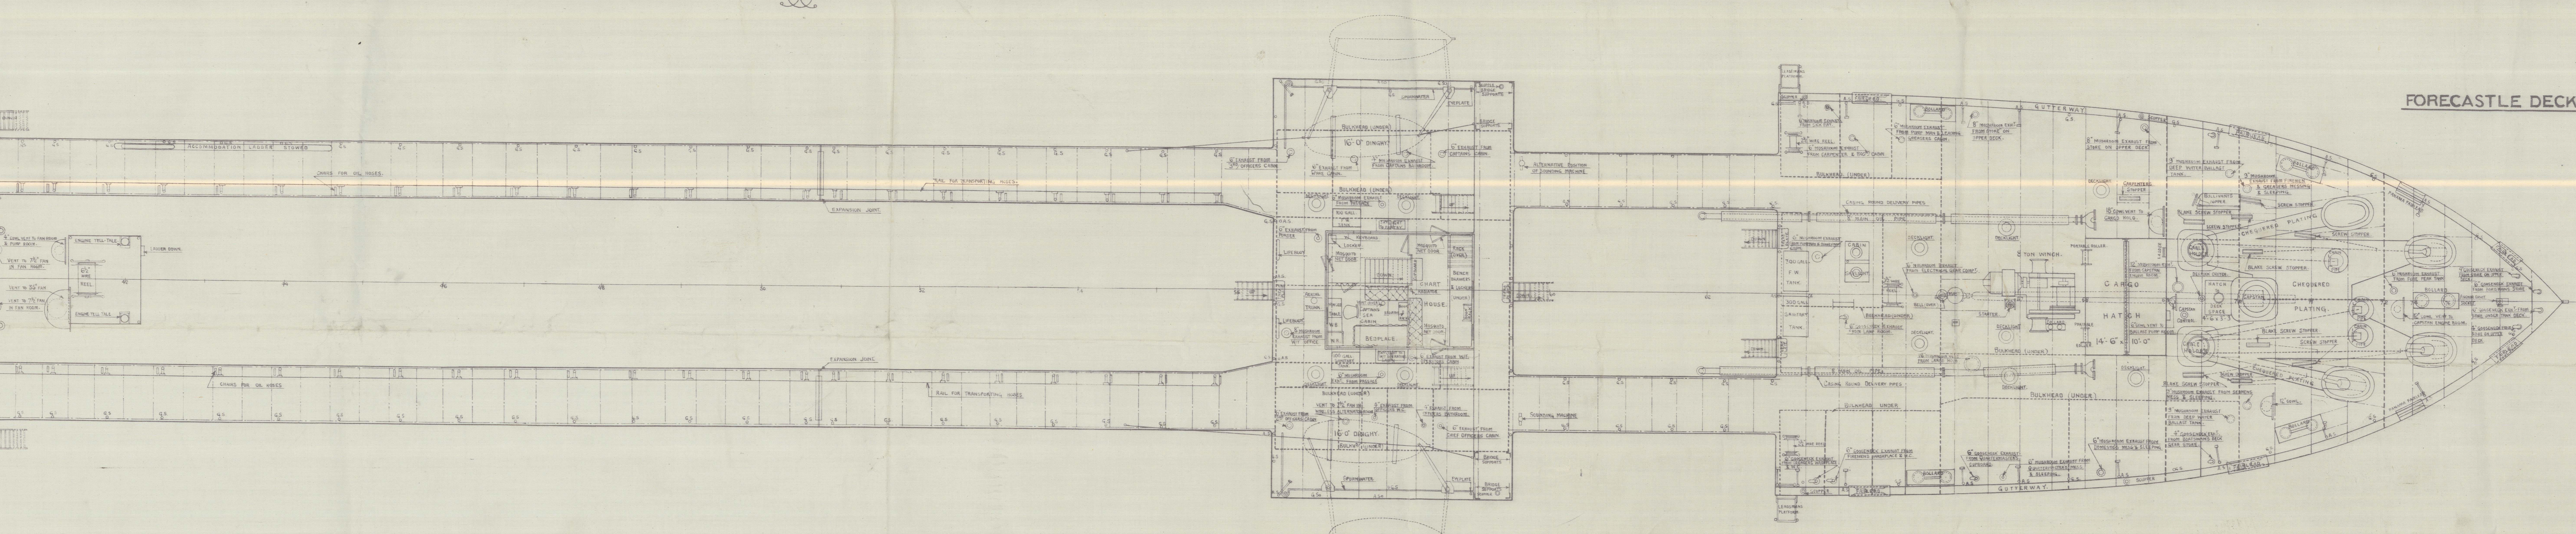

UPPER DECK.

 

UPPER DECK.

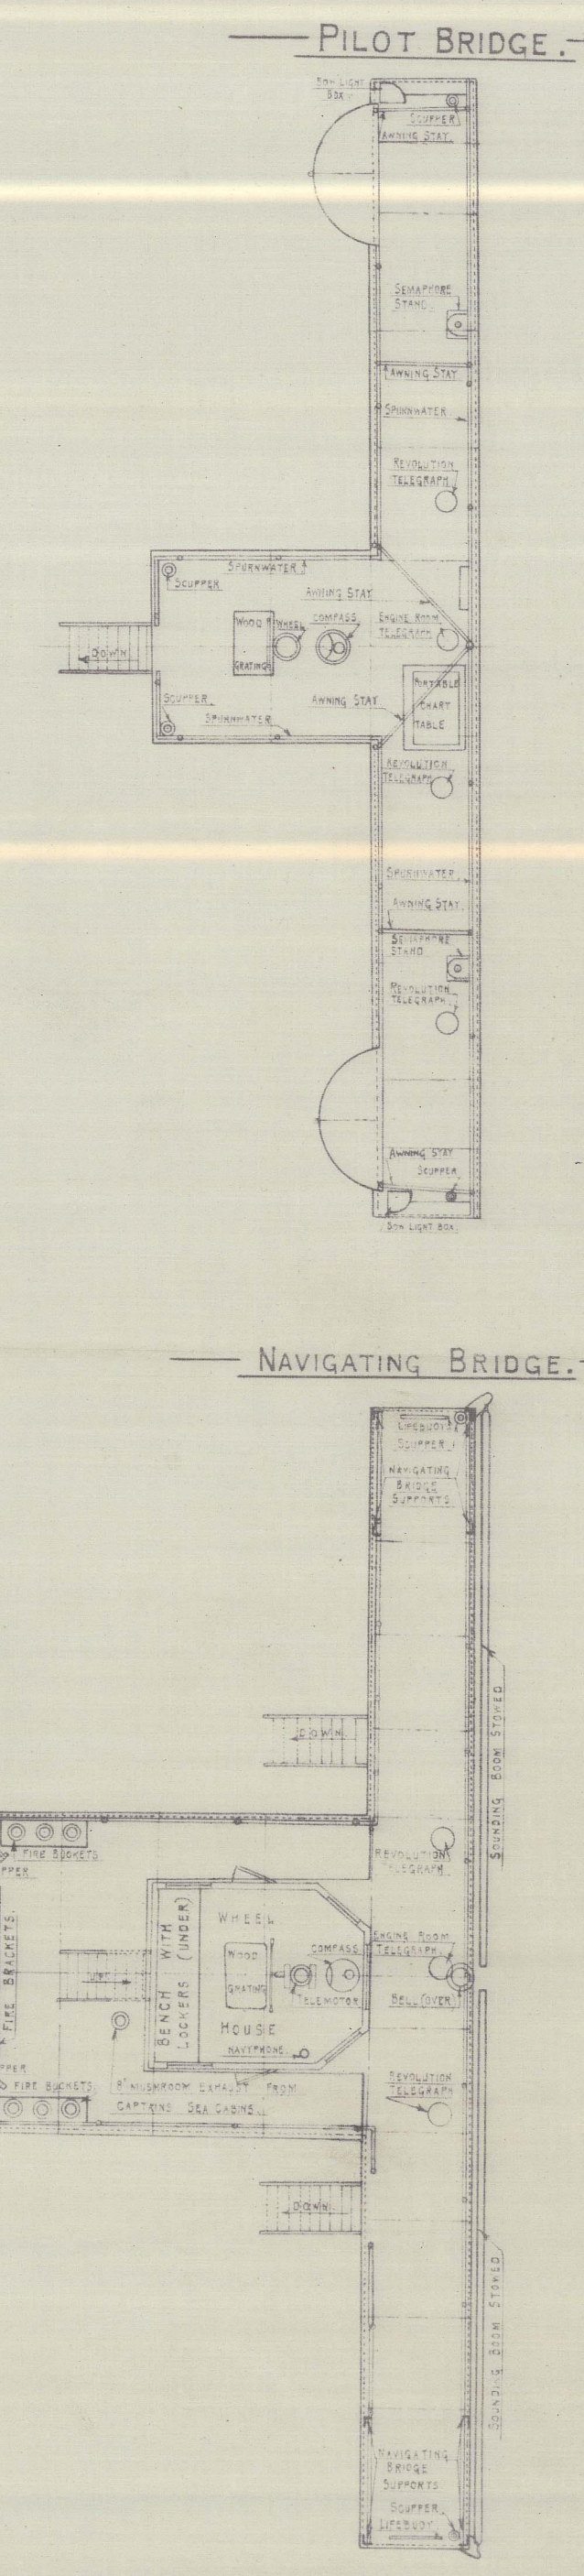

"Trigonia"
ex
M.V. Maurula.

ex Santa Margherita

General arrangement. (amended)
Profile & Decks.

Barrow. 1st Entry Report No. 1854.



© 2021

Lloyd's Register
Foundation

007432-007438-0003