

S.S. 26: 94.

Rudder Gear.

To class 300A1. Leeds.

Scale 1" = 1 ft


$$A \times D = 48.4 \times 1.88 = 90.99$$

SPEED UNDER 10 KNOTS

VAN YLIET & CO.

HARDINXVELD

HOLLAND

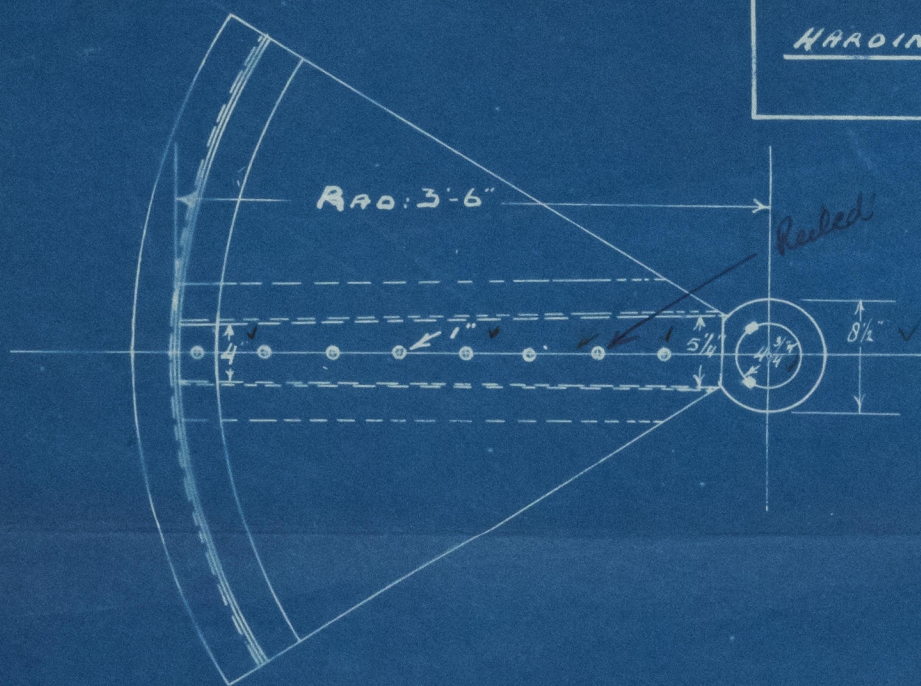

Scale 3" = 1 FT

Chrysanthi

94

S.S. no. 94. only.

Photom report no. 7670

Rudder Plan.

Rot 7670.

Rudder.



© 2020

Lloyd's Register
Foundation

007448-007455-0124