




12.4.11
4.5.11
1.6.11
28.6.11
11.11.11

1095

S.S. N° 94. 4 1095 appd. 10/11/11
LONGITUDINAL SECTION

SCALE $\frac{1}{8}$ " = 1 FT.
DIMS 169' 6" B x 28' 0" x 13' 5" MLD.
TO CLASS 100 A1, LLOYDS.

VAN VLIET & CO
HARDINXVELD - HOLLAND.



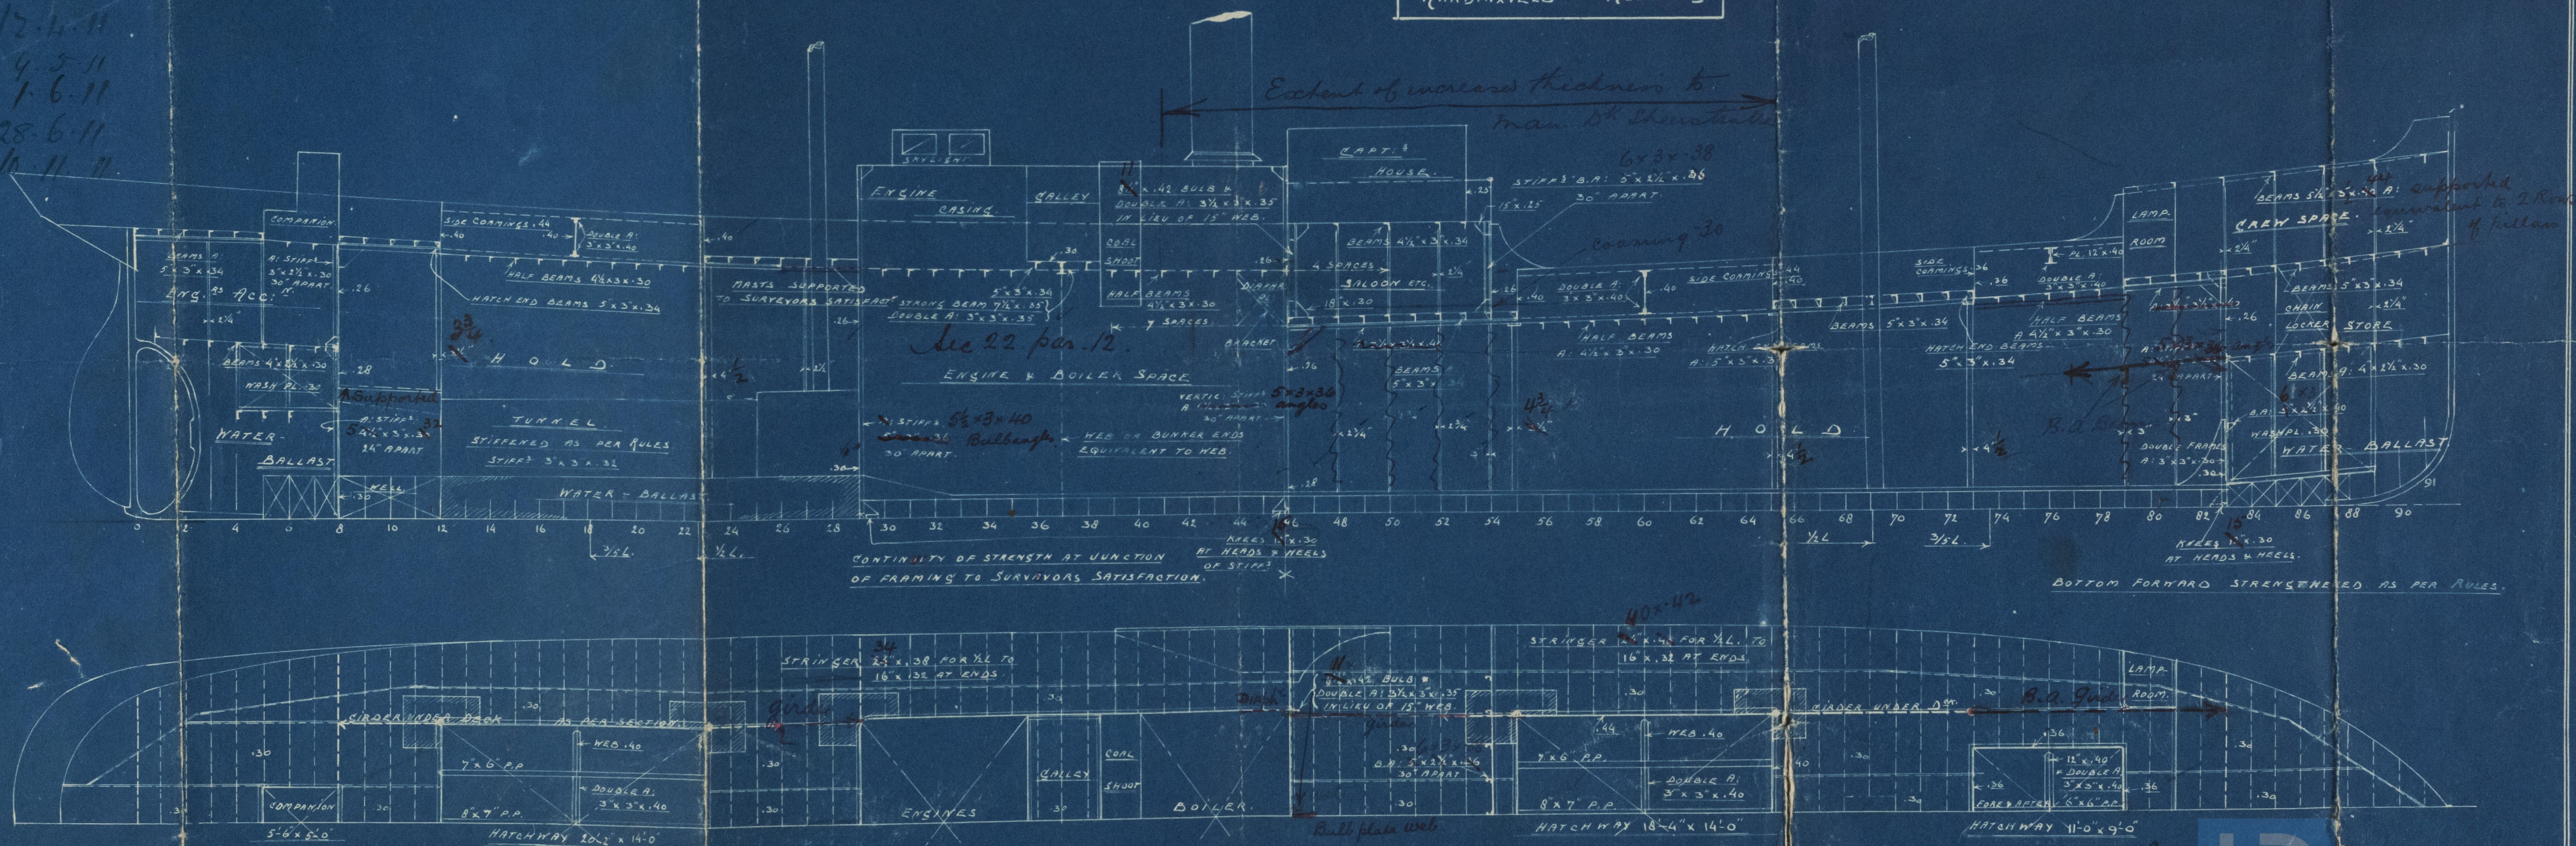



BOTTOM FORWARD STRENGTHENED AS PER RULES.






94 '95
profile & dk.

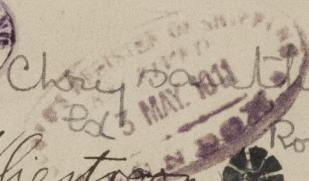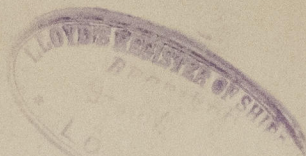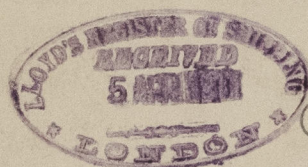

Choy Ban Thi
No 94. ss "The stream" 
No 95. ss "Ullvang".


Ref 7670

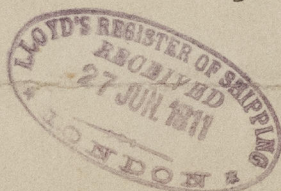

S.S. no. 94. - 95
Profile Plan.

S.S. 94. P. Adam report. no. 7070 ~~1111~~

S.S. 95 " " no. 7919.

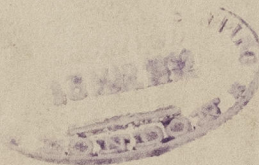

007448-007455-0126



© 2020

Lloyd's Register
Foundation