






PROFILE & DECK PLANS N° 132 SHIP

LENGTH B.P. 300'-0" BREADTH 45'-0" DEPTH 22'-1"

TO CLASS 100 A1. AT LLOYDS

SCALE $\frac{1}{8}$ " INCH = 1 FOOT.

18.8.03

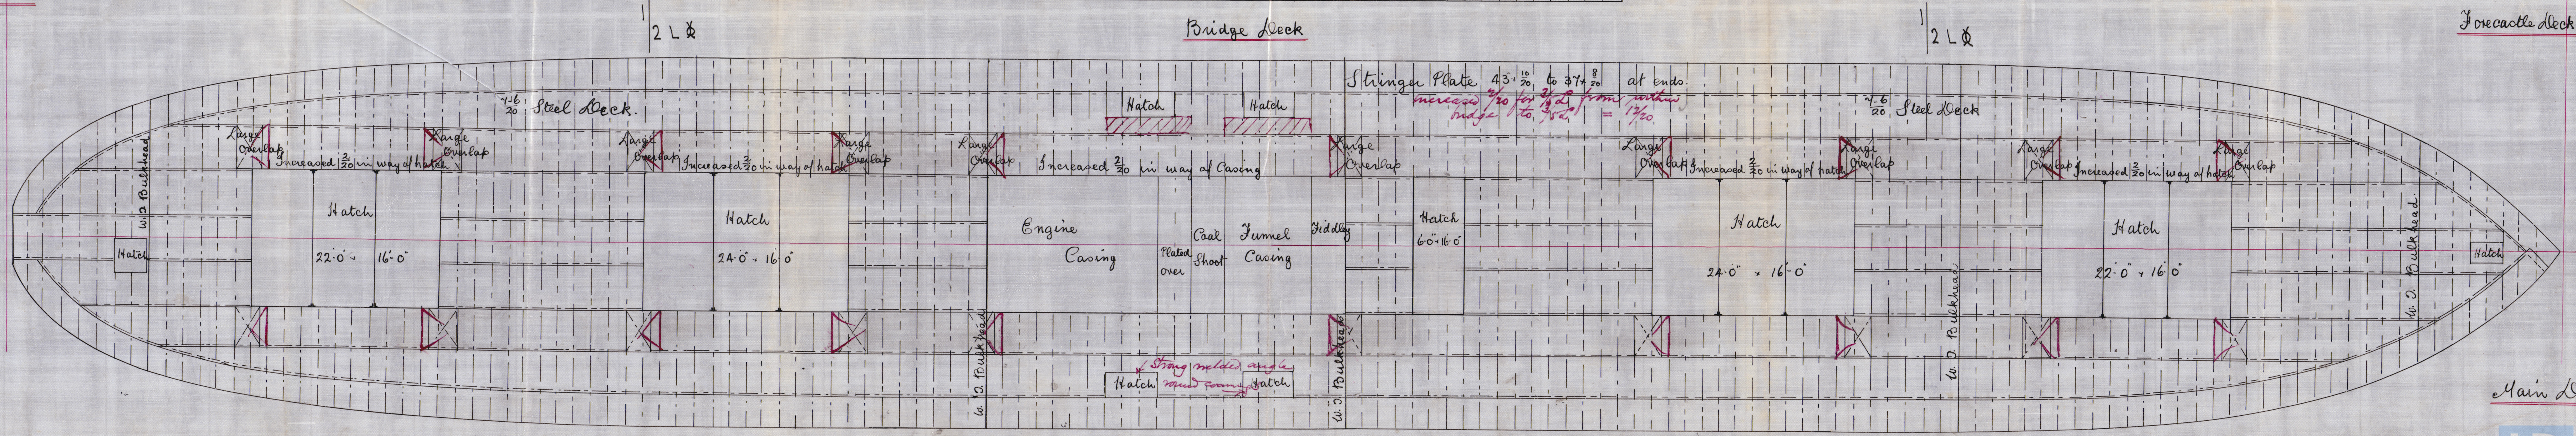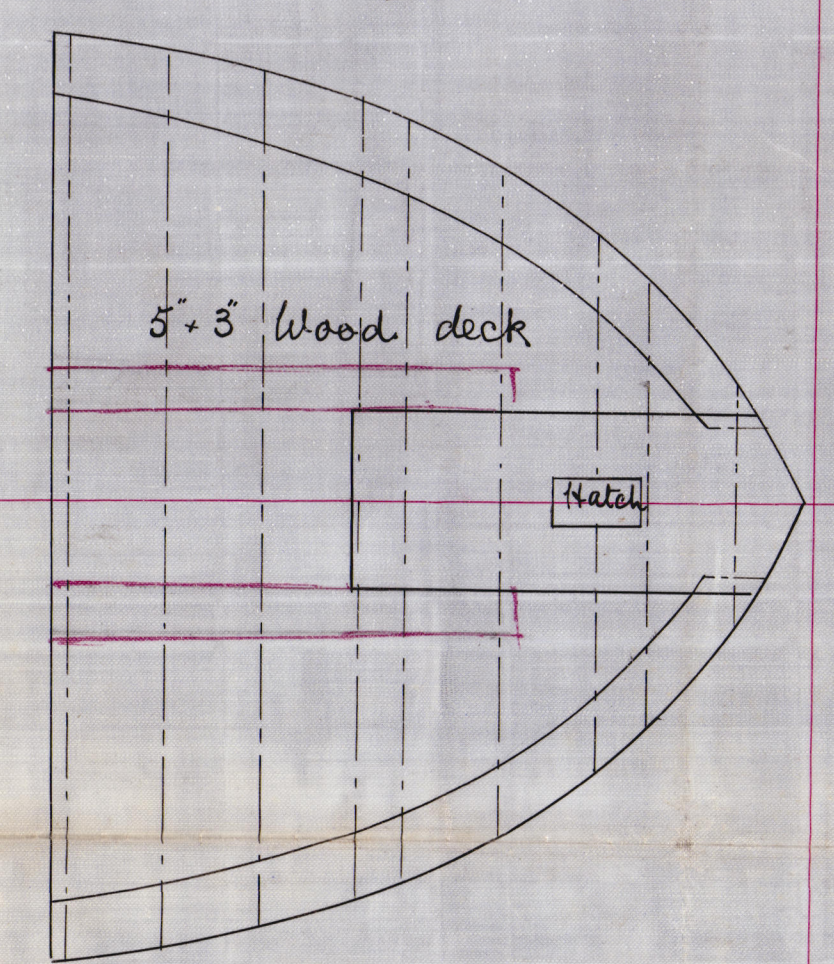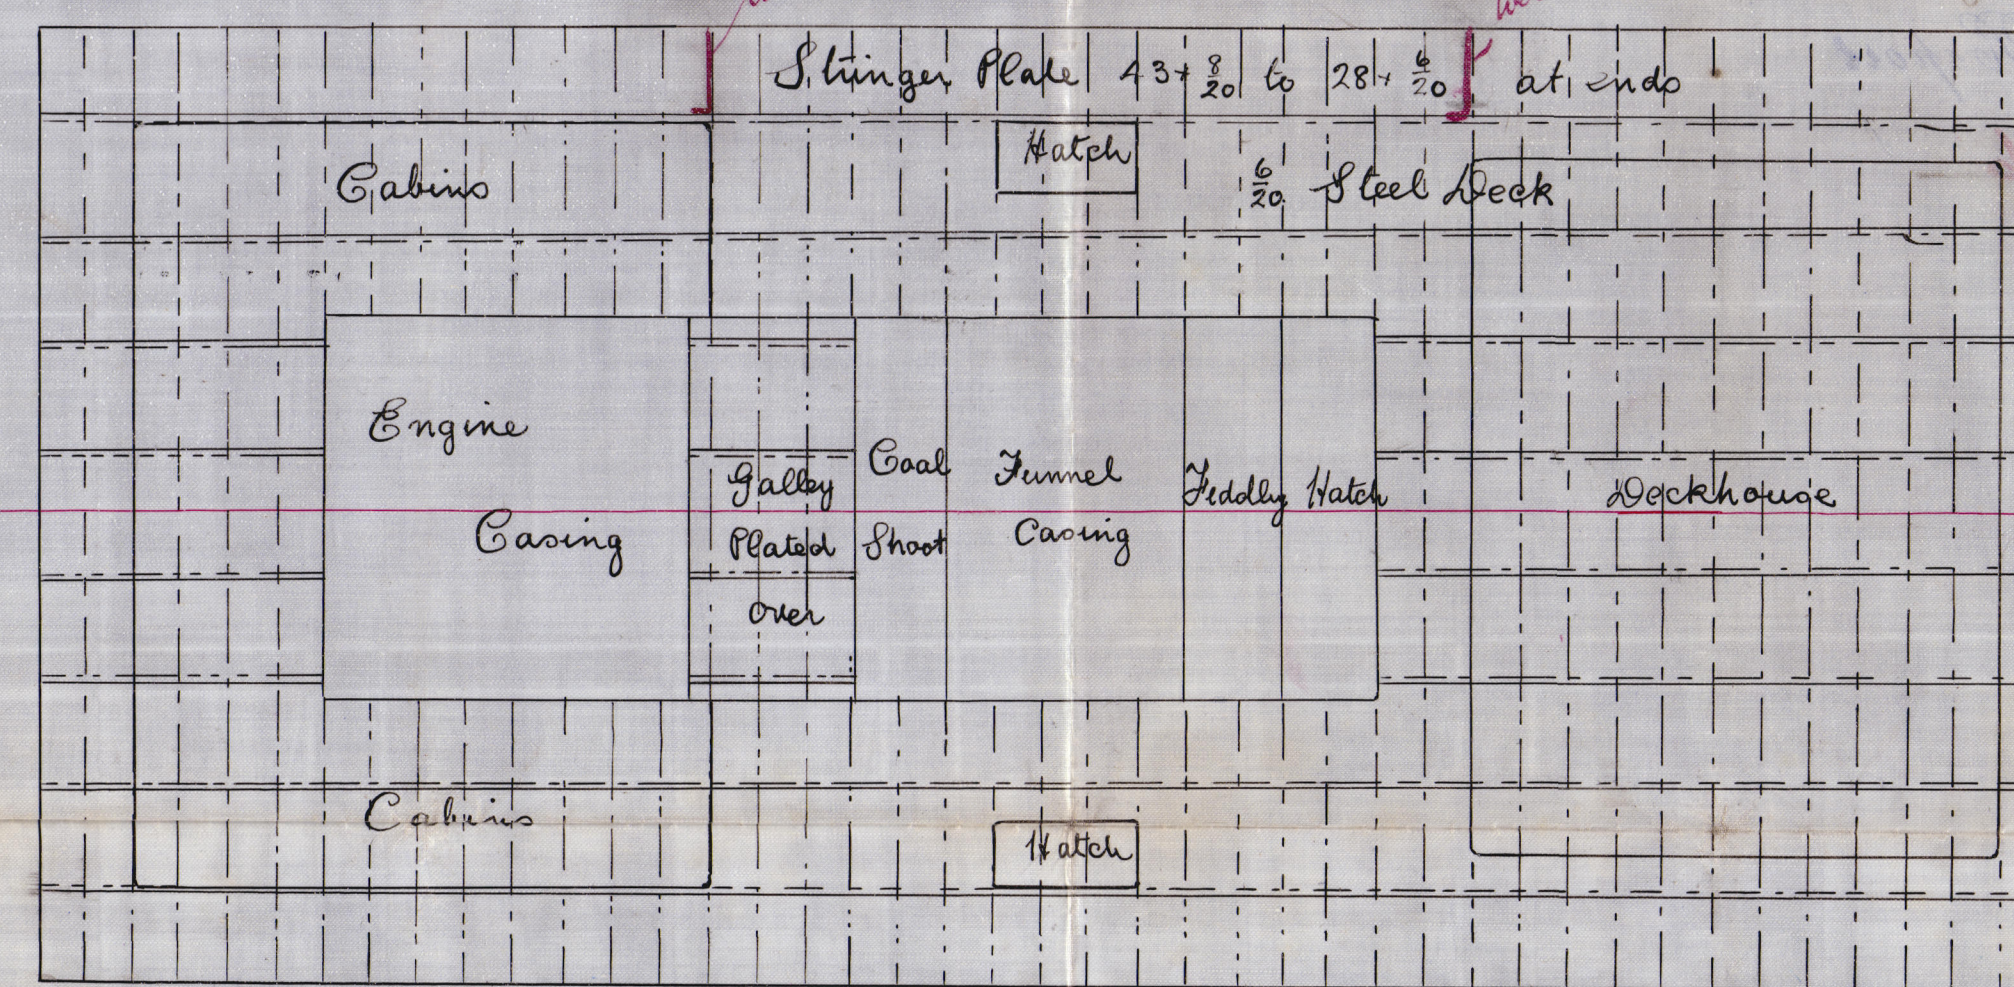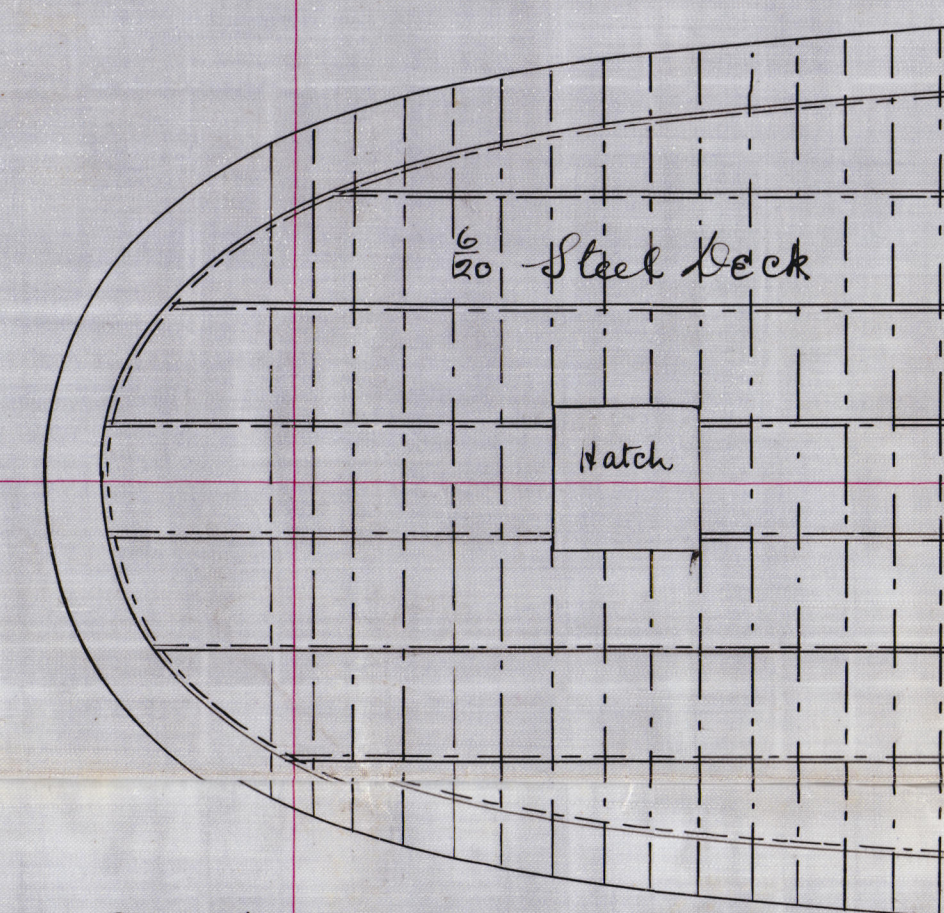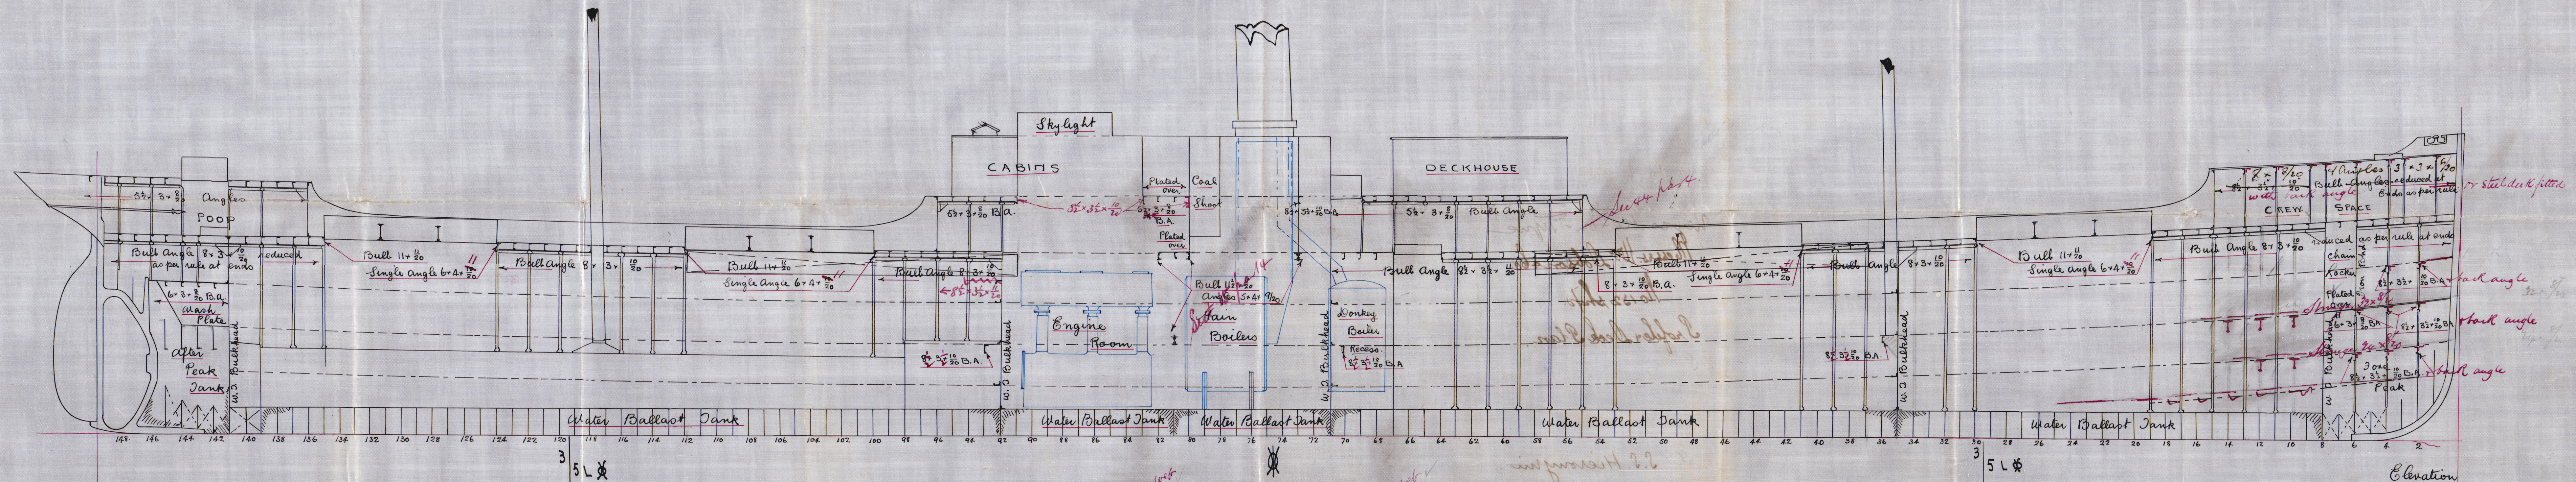

Main Deck.


Newcastle-on-Tyne

Messrs. Wm. Dobson & Co.

No. 132 ship.

Profile & Deck Plan.

S.

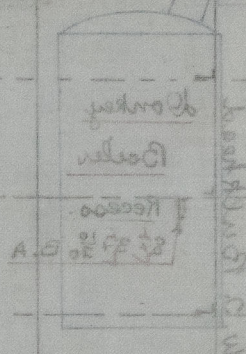

S.S. Hieronymus

Newcastle Report

No. 46716



© 2021

Lloyd's Register
Foundation