
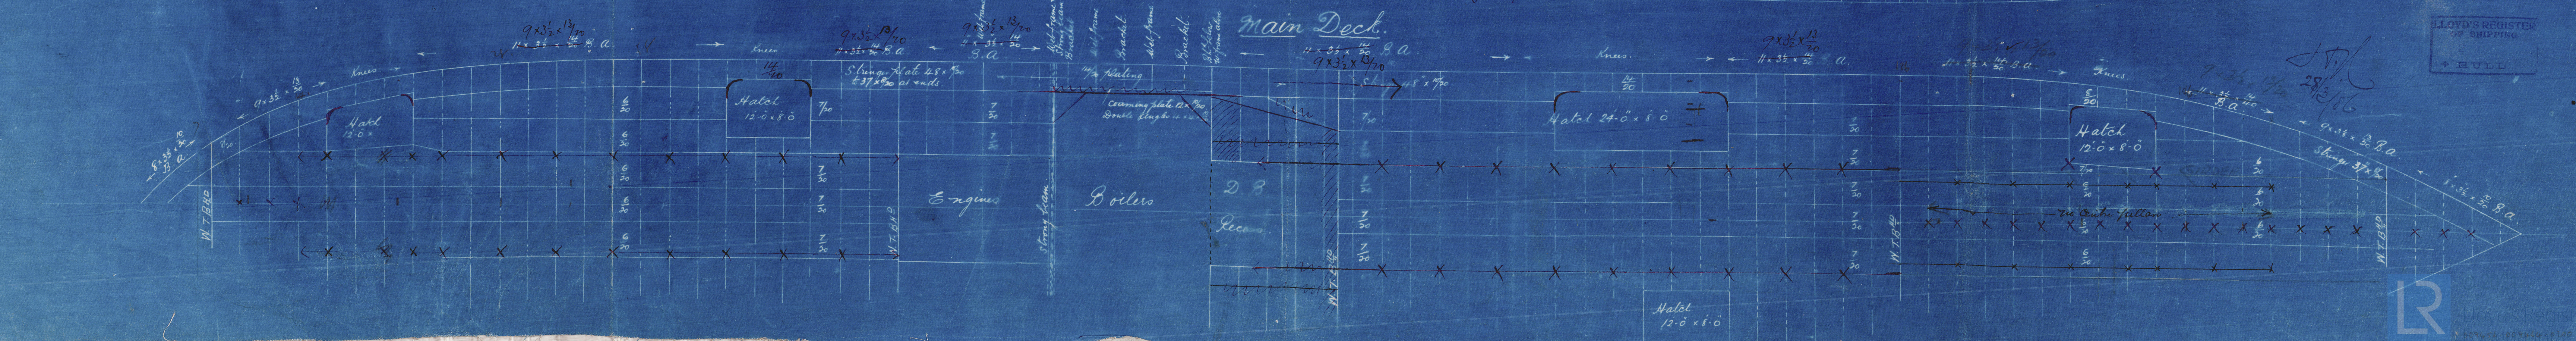
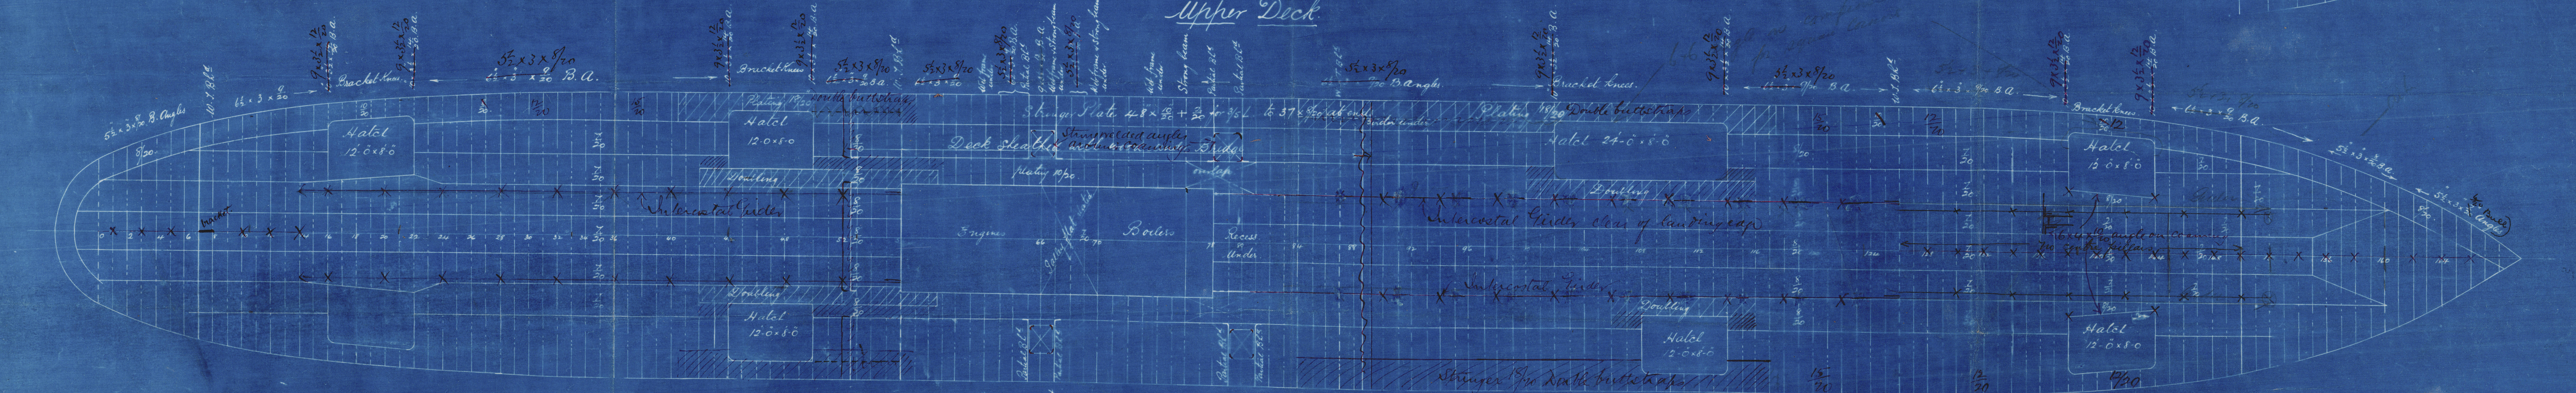
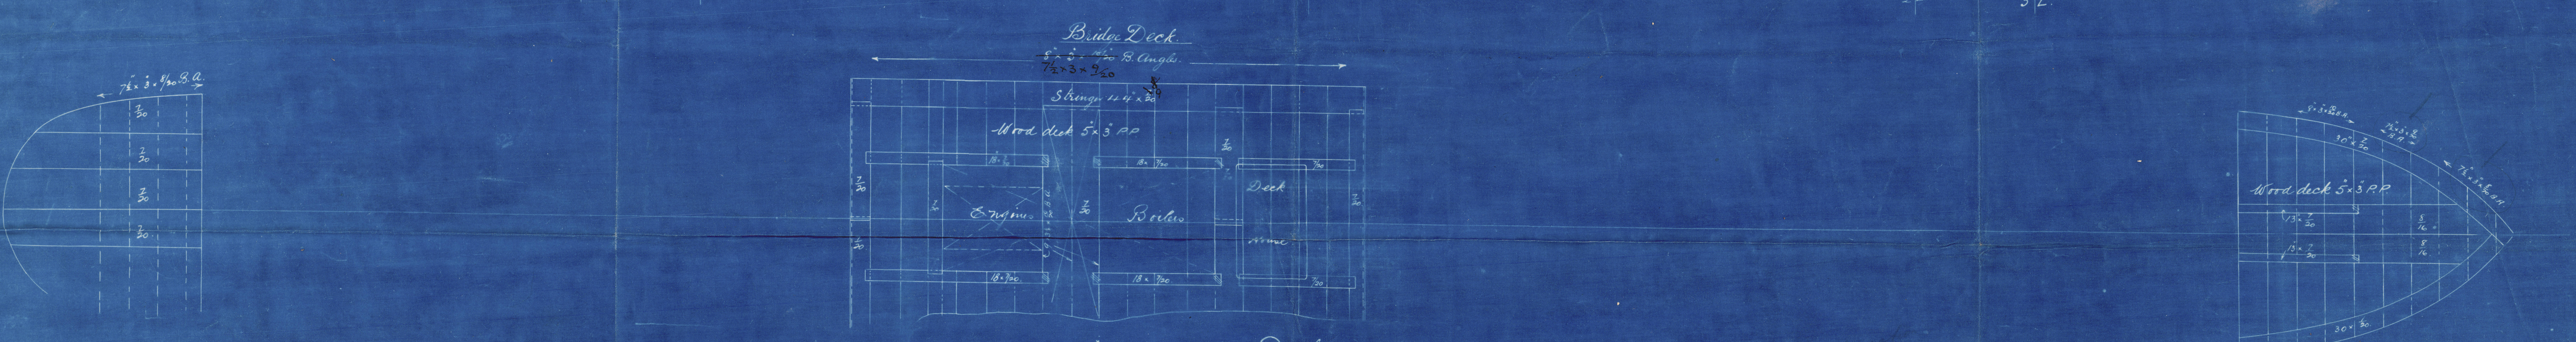
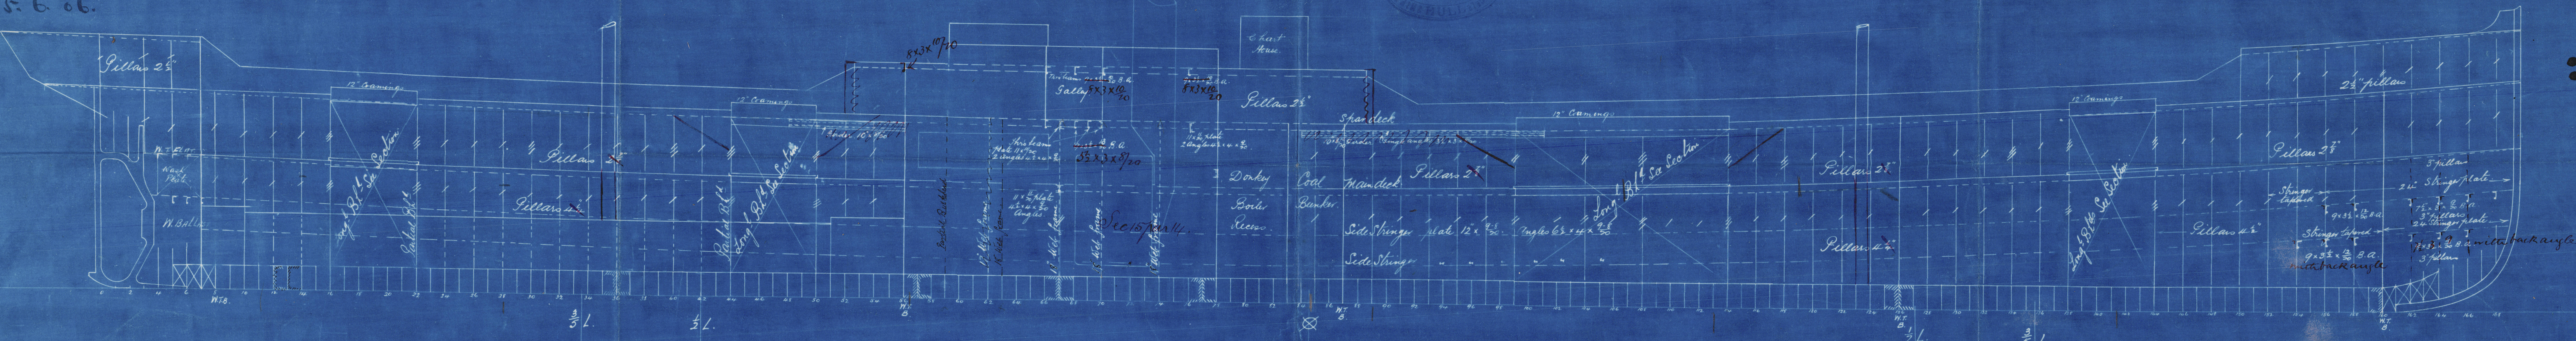


19.3.06  
10.4.06  
19.4.06  
5.6.06.

— No 522-523 —

— PROFILE —

B.P. 340.0 x 40.0 CY. x 24.0 MLD  
LLOYD'S LENGTH 338'83" x 39'82" x 24'83"

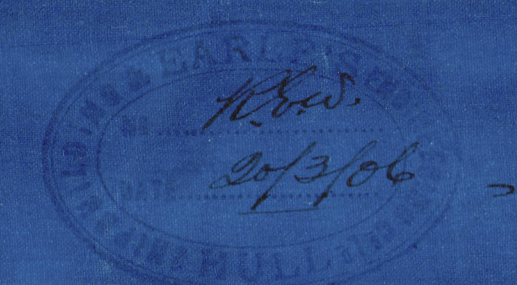

LLOYD'S REGISTER  
OF SHIPPING  
HULL



Earle's S. & E. Co. Ltd.

522 + 523


Amended

Profile and Deck Plans.

s/s "Teno"

Hull Report No. 18444

row "DON Luis"

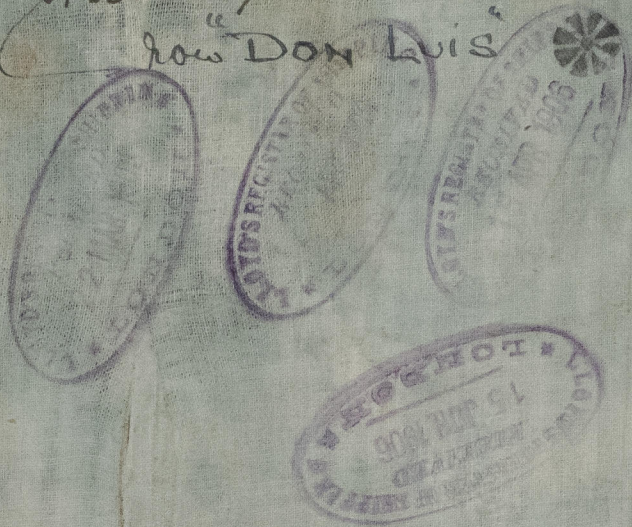

s/s "Teno" Hull Report No. 18444  
"Lebu" " " 18586



4




9.  
4  

---

11  

---

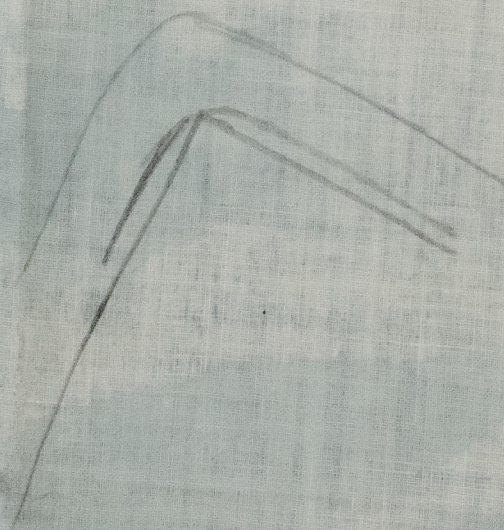

© 2021

Lloyd's Register  
Foundation