

N^o 236-7.


STERN FRAME CASTING.

SCALE $\frac{1}{2}$ " TO ONE FOOT.

MARK * INDICATES THE SCANTLING APPROVED BY TEISHINSHO & LLOYD'S.

LONGITUDINAL No.	51,005.0
RULE SECTION. *	$9\frac{1}{2} \times 9\frac{1}{2}$ "
LLOYD'S APPROVED.	$9\frac{1}{2} \times 13$ "
ACTUAL CASTING.	$9\frac{1}{2} \times 12\frac{1}{2}$ "

* REMARK: — IN HIGH POWERED VESSELS THE DIMENSIONS OF THE STERN FRAME WILL REQUIRE TO BE INCREASED TO THE SATISFACTION OF THE COMMITTEE.

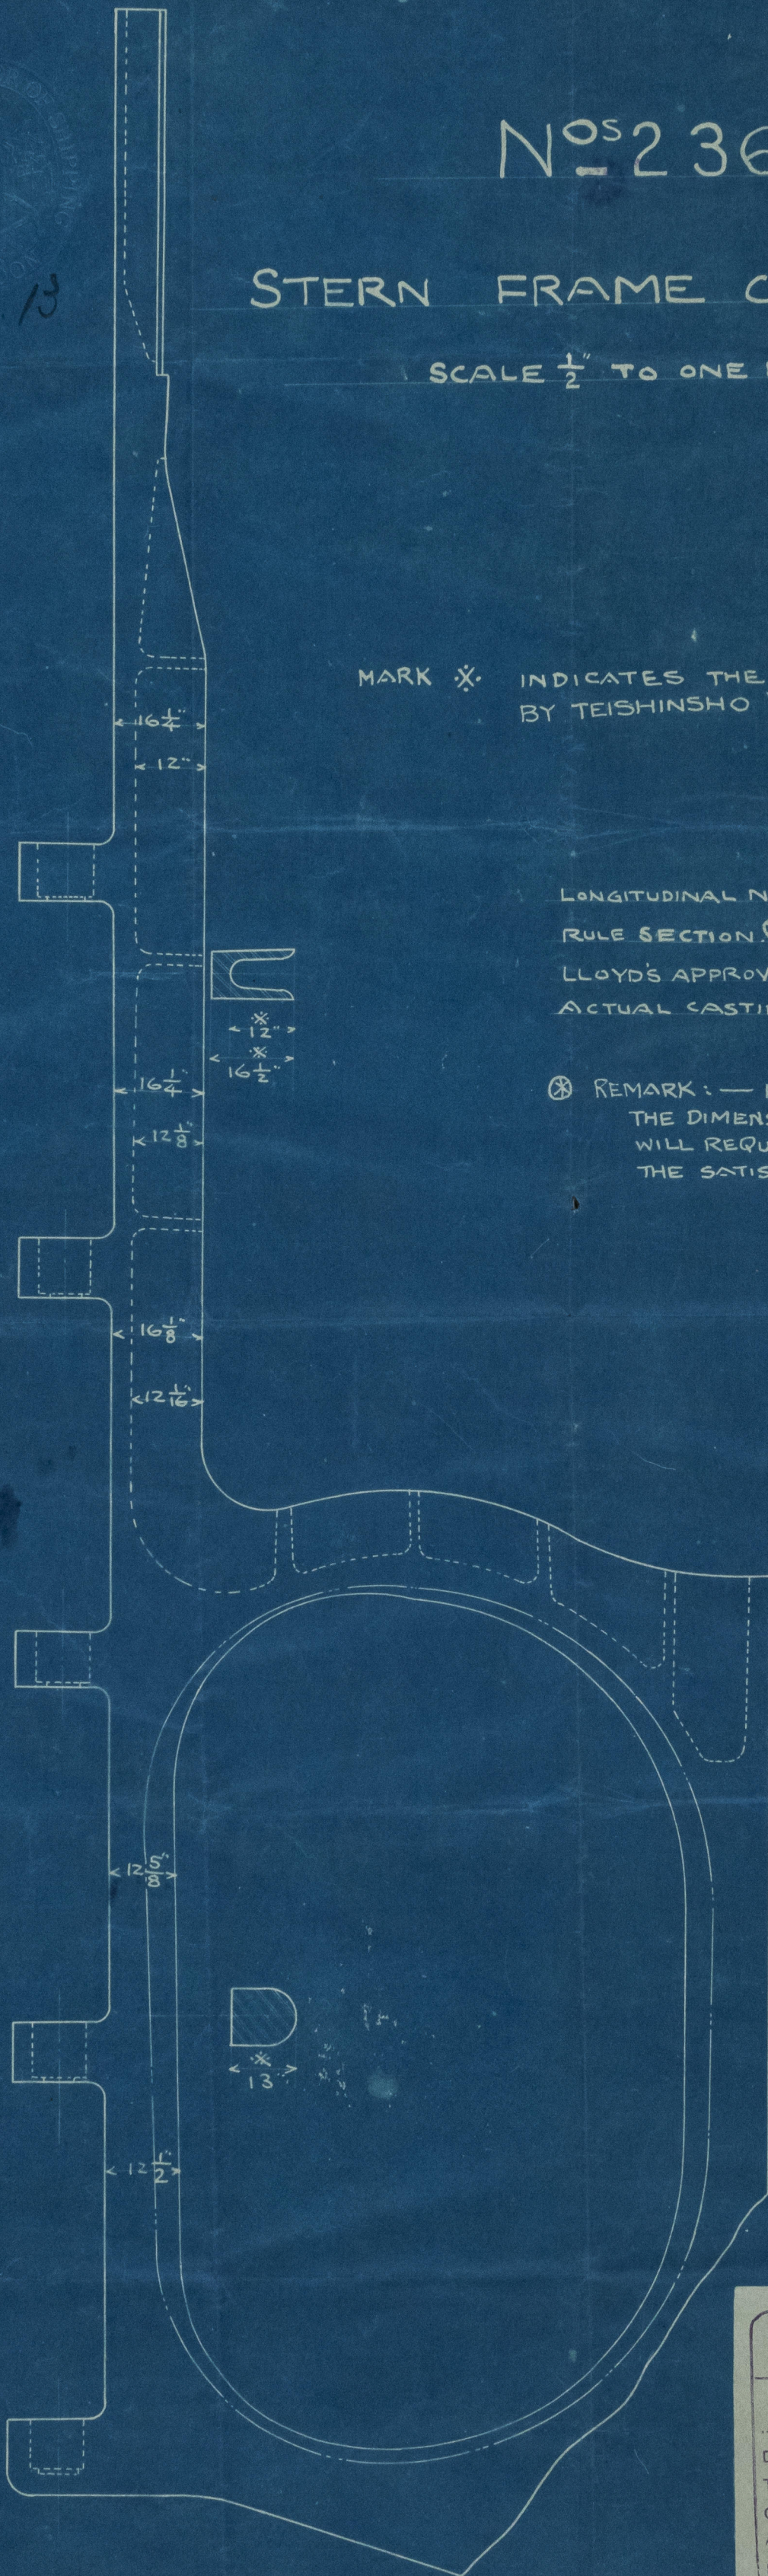

198.13

31/7/10

MITSU-BISHI
DOCK YARD & ENGINE WORKS
NAGASAKI

DRAWN BY...
TRACED BY...
CHECKED BY...
APPROVED BY...
DRAWING OFFICE NO. 46333
DATE JUL 29 1913

236-7

Stern Post as
cost


Nagasaki

(236) Suwa Maru

Nag. Rept. N^o 938

(237) Fushimi Maru

Nag. 955

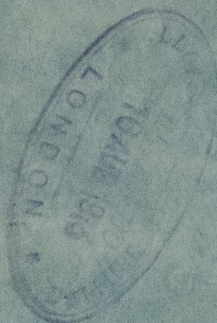

© 2020

Lloyd's Register
Foundation

007465-007473-0040