

DATE

DRAWING OFFICE NO

APPROVED BY

CHECKED BY

TRACED BY

DRAWN BY

Handwritten signature



DOCK YARD & ENGINE WORKS
NAGASAKI
JAPAN

Section
Alterations

Nº 236-7

Nagasaki

S. S. Suwa Maru
Nagasaki Ript 938

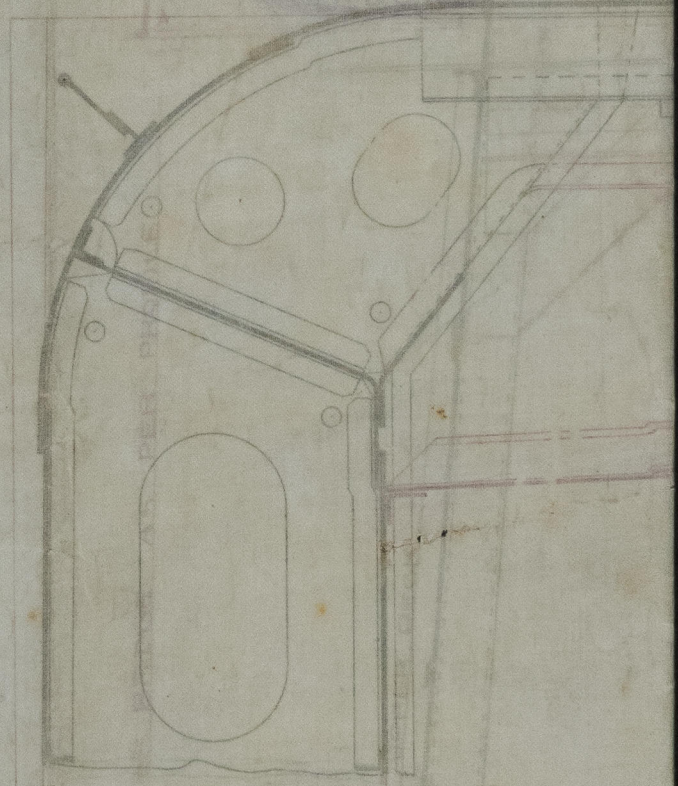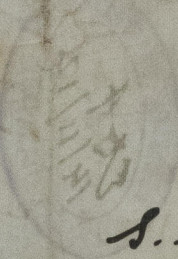

PORT HULL



© 2020

Lloyd's Register
Foundation

007465-007473-0041