

NOS 236-7


STERN FRAME

LLOYD'S APPROVED PLAN.

SC

PLAN

SEC

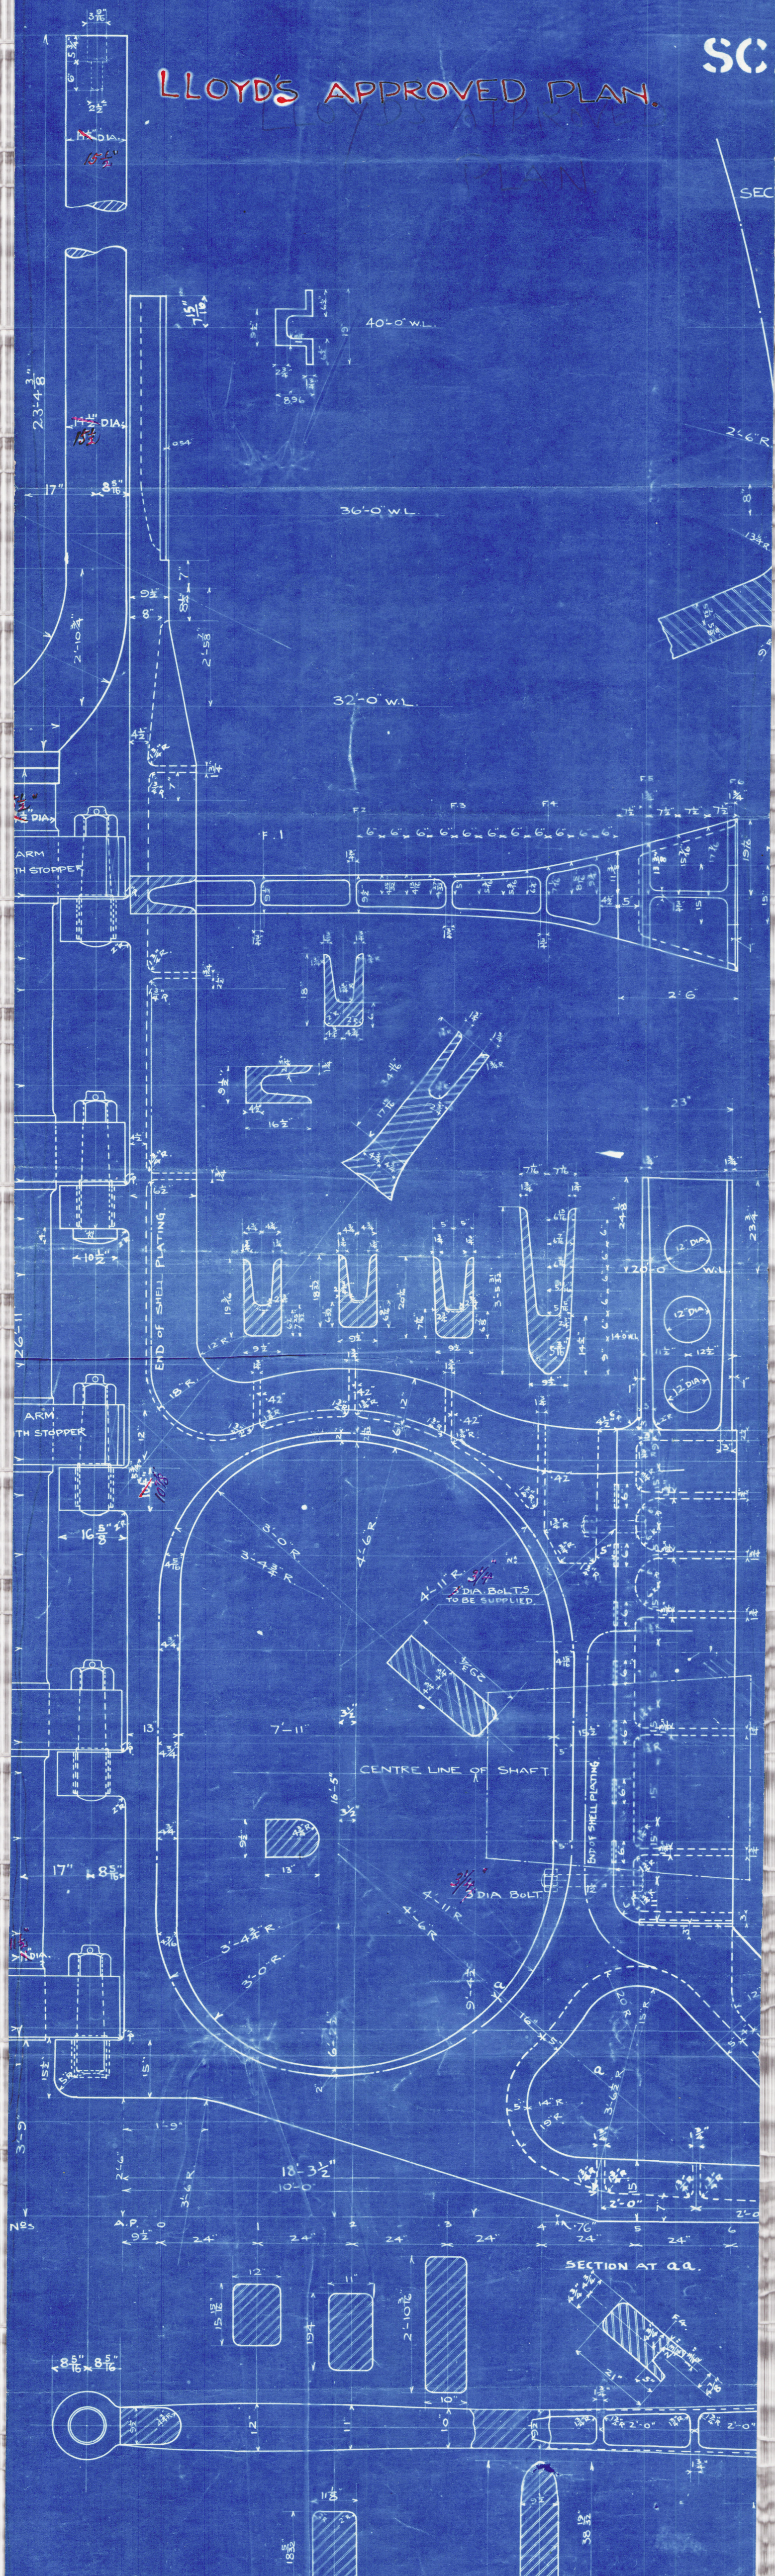

MITSUBISHI
 DOCK YARD & ENGINE WORKS
 NAGASAKI

DRAWN BY
 TRACED BY
 CHECKED BY
 APPROVED BY
 DRAWING OFFICE NO. 65342
 JUL 25 1913

RECORDED
 INDEXED
 3/17/13

LR

10020

Lloyd's Register Foundation

236-7

Stern & name as
approved


Nagasaki

Suma Maru

Nagasaki Ript- 938

Furukawa Maru

Nag Ript 112

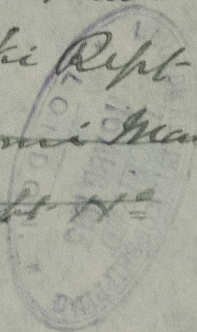

© 2020

Lloyd's Register
Foundation