

MIDSHIP SECTION.

PRINCIPAL DIMENSIONS.

LENGTH	PR.	388'-0"
BREADTH	MO.	53'-3"
DEPTH	"	32'-0"
TWEEN DECK HEIGHT.		8'-6"
HEIGHT OF POOR BRIDGE AND FORECASTLE DECK.		7'-9"

NUMERALS		EQUIPMENT NUMERAL.	
B+D	53.25+39 = 85.25	(53.25+32.00) x 388.00 = 33,077.00	
(B+D)xL	85.25 x 388 = 33,077.00		
PROPORTIONS.			
DEPTH TO LENGTH	12.13 (TO U.D)	POOP DECK = 183.56	
"	9.76 (TO B.D)	BRIDGE DECK = 680.30	
BREADTH TO	7.29	FO'LE DECK = 193.99	
		DECK HOUSES = 606.16	
		NUMERAL 34,741.01	

EQUIPMENT			CWTS	STOCKLESS
1.	BOWER ANCHOR	60	"	"
1.	"	"	"	"
1.	"	50 1/2	"	"
1.	STREAM	20 1/2	"	"
1.	KEDGE	8 1/2	"	"
2 1/2	STUD CHAIN	270	FATHOM.	"
4 1/2	STEEL WIRE	90	"	"
4 1/2	"	120	"	"
8	HAWSER	2 - 90	"	"
7	"	2 - 90	"	"

J. French



MIDSHIP SECTION.

~~by Box 2900~~

"Koki Maru"


yka 2838

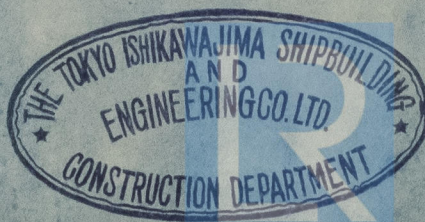

© 2020

Lloyd's Register
Foundation

007465-007473-0210

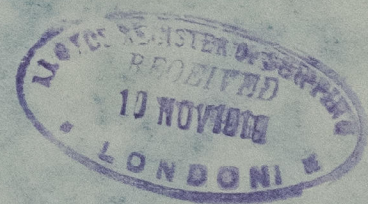

© 2020

Lloyd's Register
Foundation