


SHIP NO. 563
CONSTRUCTION PROFILE
AND
DECK PLAN

NOTE:
ALL BEAMS, INCLUDING THOSE TO SALOON DECK
AND SHUTTER, ARE FITTED ON EVERY FRAME.
PAINTED LETTERS IN RED SHOW THE
ALTERATIONS BY OWNER'S
REQUIREMENTS.

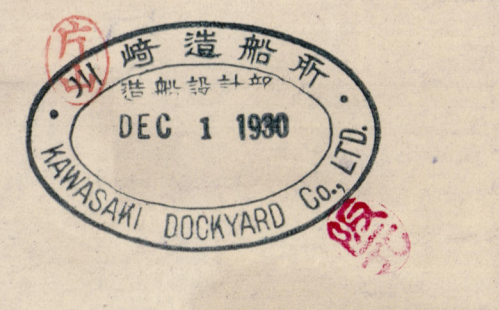

M/S "KIOSHIMA MARU"
Profile & Decks

