

extended
-1931

SKETCH OF SHELL PLATING

IN LIEU OF DOUBLING
FOR HAWSE PIPE

DIAMOND AND INTERCOSTAL PLATES
AT CORNER OF HATCHES

Diagram illustrating the measurement of the lower legs and feet:

- Top measurement: $3' 3'' \times \frac{6}{20}$
- Middle measurement: $3' \frac{1}{2}'' \times 3' \frac{1}{2}'' \times \frac{7}{20}$
- Bottom measurement: $22'' \times \frac{6}{20}$
- Bottom-most measurement: $KNEES 18'' \times \frac{7}{20}$

ME 545

TANK FRAMES DOUBLED FOR 3rd L.
TO COLLISION BULKHEAD.

COLLISION BULKHEAD $\frac{5}{16}$ PLATES
VERTICAL STIFFENED WITH
 $6 \times 3 \times \frac{5}{16}$ B.A. AND CONNECTED *2" apart*
WITH $18 \times \frac{5}{16}$ KNEES TO TANKTOP.

FORECASTLE DECK


— SS No 154. —

PROFILE & DECKPLANS.

SCALE $\frac{1}{8}$ = 1 FOOT ENG. MEASURE. B.M.V. 28-11-08

Skipstegnekantoret No. 1570.

S/S. Karlsborg
 Bgm. 779
 Profile & Deck plans

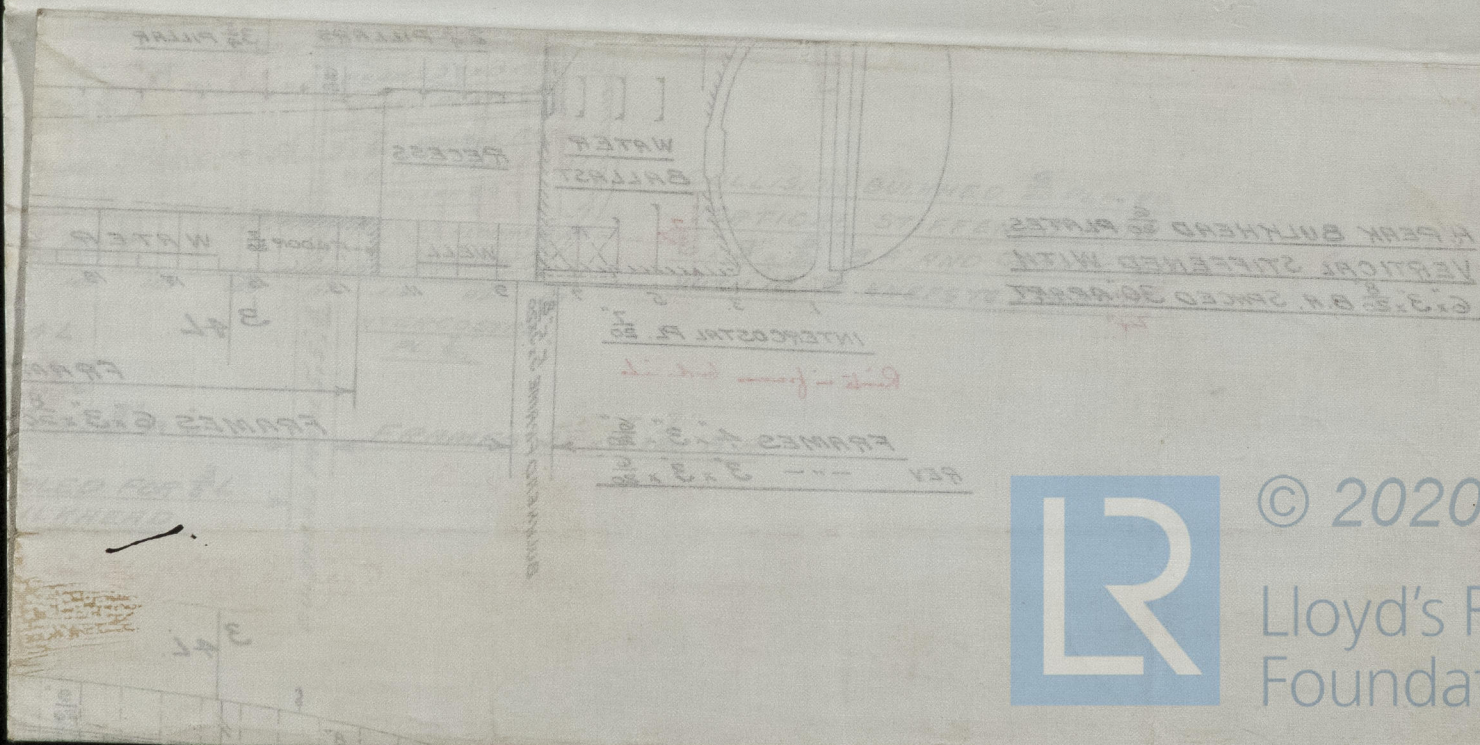

© 2020

Lloyd's Register
 Foundation