

PANNING STRINGER	
IN FORE PEAK TANK	
STRINGER PL.	36" x 96"
RT. KNEE	10" x 36"
SHELL ANGLE	150° x 150° x 9"
PANNING BEAM	300° x 50° x 3/4"
DEEP BEAM	36° x 36° x 3/4"
IN HOLD	
UNIT PLATE	44"
SHELL ANG.	90° x 90° x 11/16"
FACE OF R.	180° x 90° x 11/16"

M.V. "HOKKAI-MARU"
Nagasaki Report No. 1879.

"HOKKAI-MARU"
CONSTRUCTION PROFILE
AND DECK PLAN.
SCALE 1/16" = ONE FT.
445'-0" x 60'-6" x 40'-9"
(FINISHED PLAN.)




M.V. "HOKKAI MARU".

Nagasaki Report No.1878.

"HOKKAI-MARU."
CONSTRUCTION PROFILE
AND DECK PLAN.

SCALE $\frac{1}{16}$ " = ONE FT.

445'-0" x 60'-6" x 40'-9"
(FINISHED PLAN.)

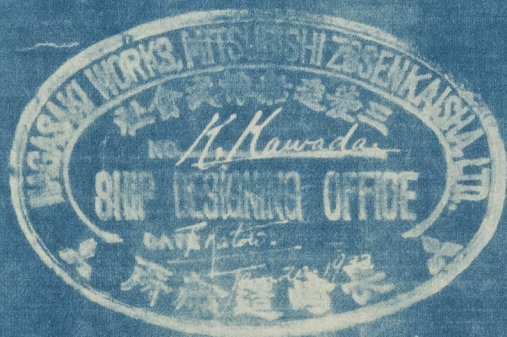

K. Kawada
Jan. 20th 1935.

007486-007495-0051



© 2020

Lloyd's Register
Foundation

007486-007495-0051