
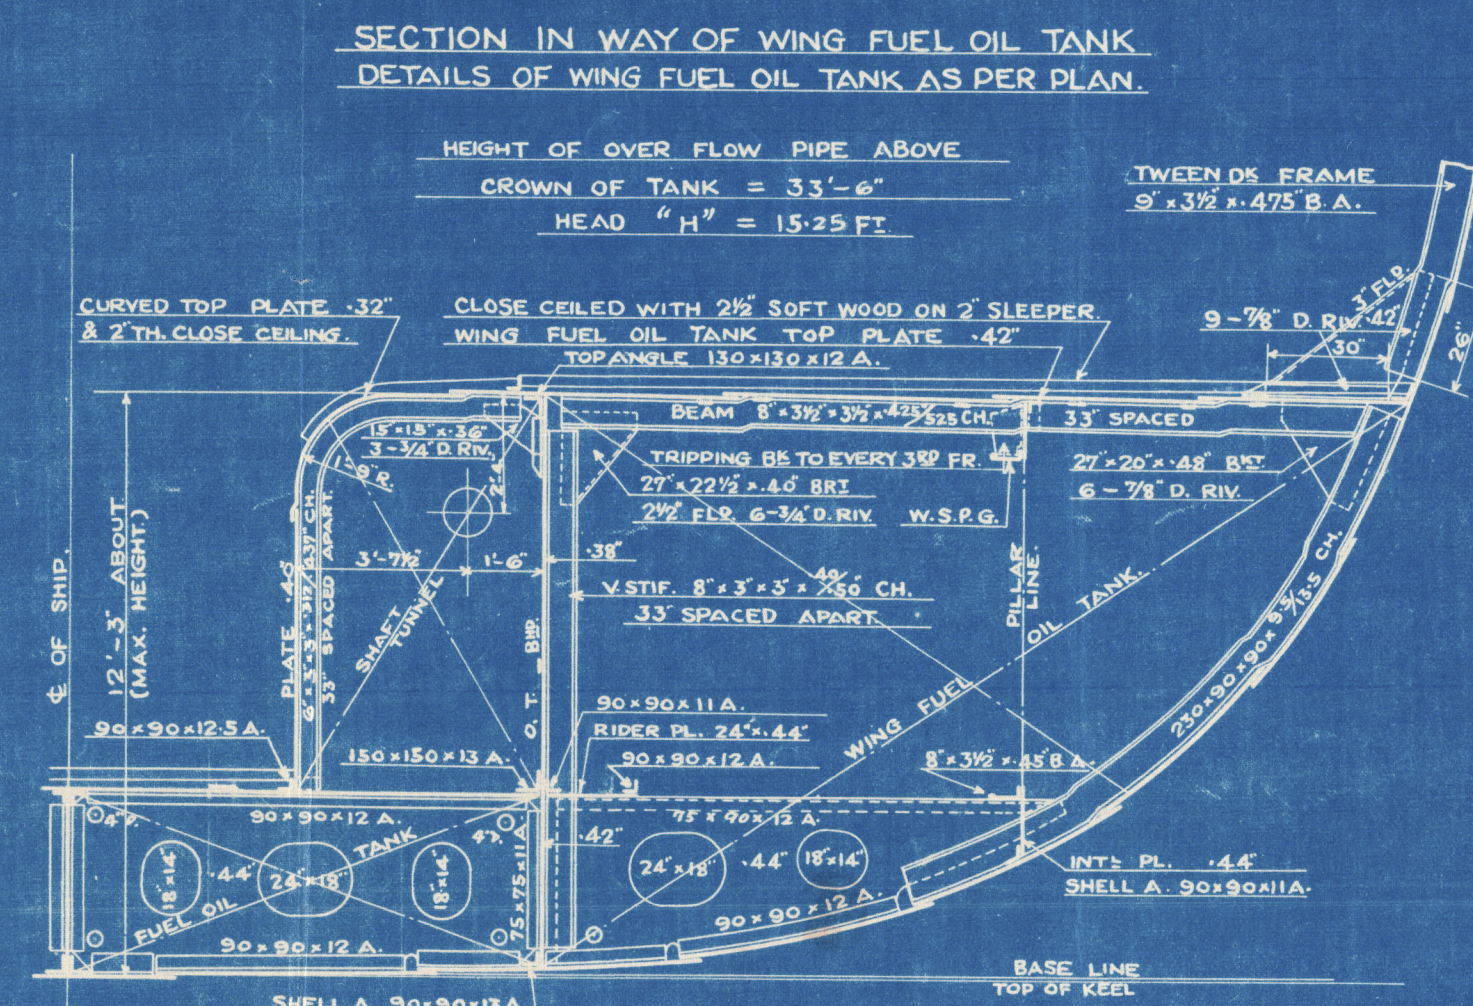


N.B. :-

INCHES "YAWATA SEITETSU STANDARDS"


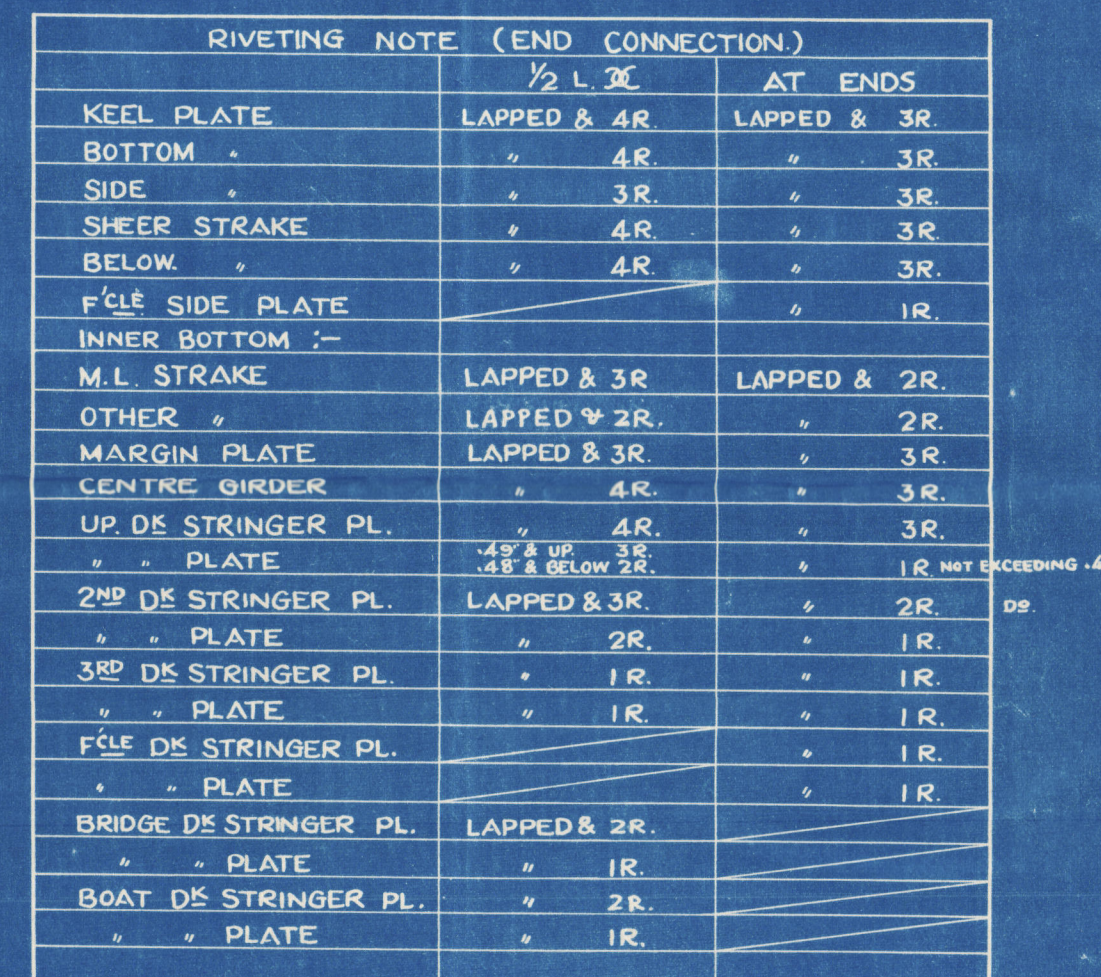

NAGASAKI WORKS, MITSUBISHI ZOSSEN KAISHA, LTD.


NO. 446

SHIP DESIGNING OFFICE

O. F. Stevens

Jan. 14, 1933.

所 長 造 船 長

Y. K. Kishimoto
June 14th 1933.

M.V. "HOKKAI MARU".

Nagasaki Report No.1878.

M.S. "HOKKAI-MARU" MIDSHIP SECTION.

445'-0" x 60'-6" x 40'-9"
SCALE 1/4 INCH TO ONE FOOT
(FINISHED PLAN.)



H. Kawada
Jan. 14th 1933.

007486-007495-0052



Lloyd's Register
Foundation

007486-007495-0052