

Lucas 7.6

Lloyd's Stamp
24.12.19

664.
30.1.20

Signed:
C. C. G.
23.12.19

MIDSHIP. SEC.



Inguetta Nos 142

"Fulgor" Gen 8298.

"Vigor" — 8374.

(Nº 1)

See plan
h/o-10

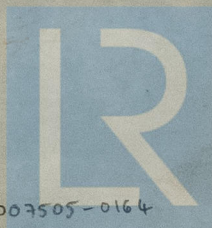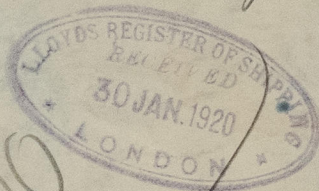

© 2020

Lloyd's Register
Foundation

007496-007505-0164