

23-11-16

MIDSHIP SECTION

N^{OS} 363 & 4.

SCALE 1/2" = 1 FOOT.

DIMENSIONS 125'-0" BP x 22'-0" EX x 12'-3" DEPTH OF HOLD

STEEL STEAM TRAWLER

CLASSED 100.A.1.

SCANTLINGS OF QUARTER & FORECASTLE DECKS.
SAME AS MAIN DECK.

LLOYDS NUMERALS

TRANSVERSE N^O (B+D) = 34.91. ✓


$\frac{B}{D} = 11.75$. ✓

LONGITUDINAL N^O Lx (B+D) = 4363.75 ✓

$\frac{L}{D} = 9.55$. ✓

NUMERAL FOR RUDDER = 65.17 ✓

SPEED 10 1/2 KNOTS

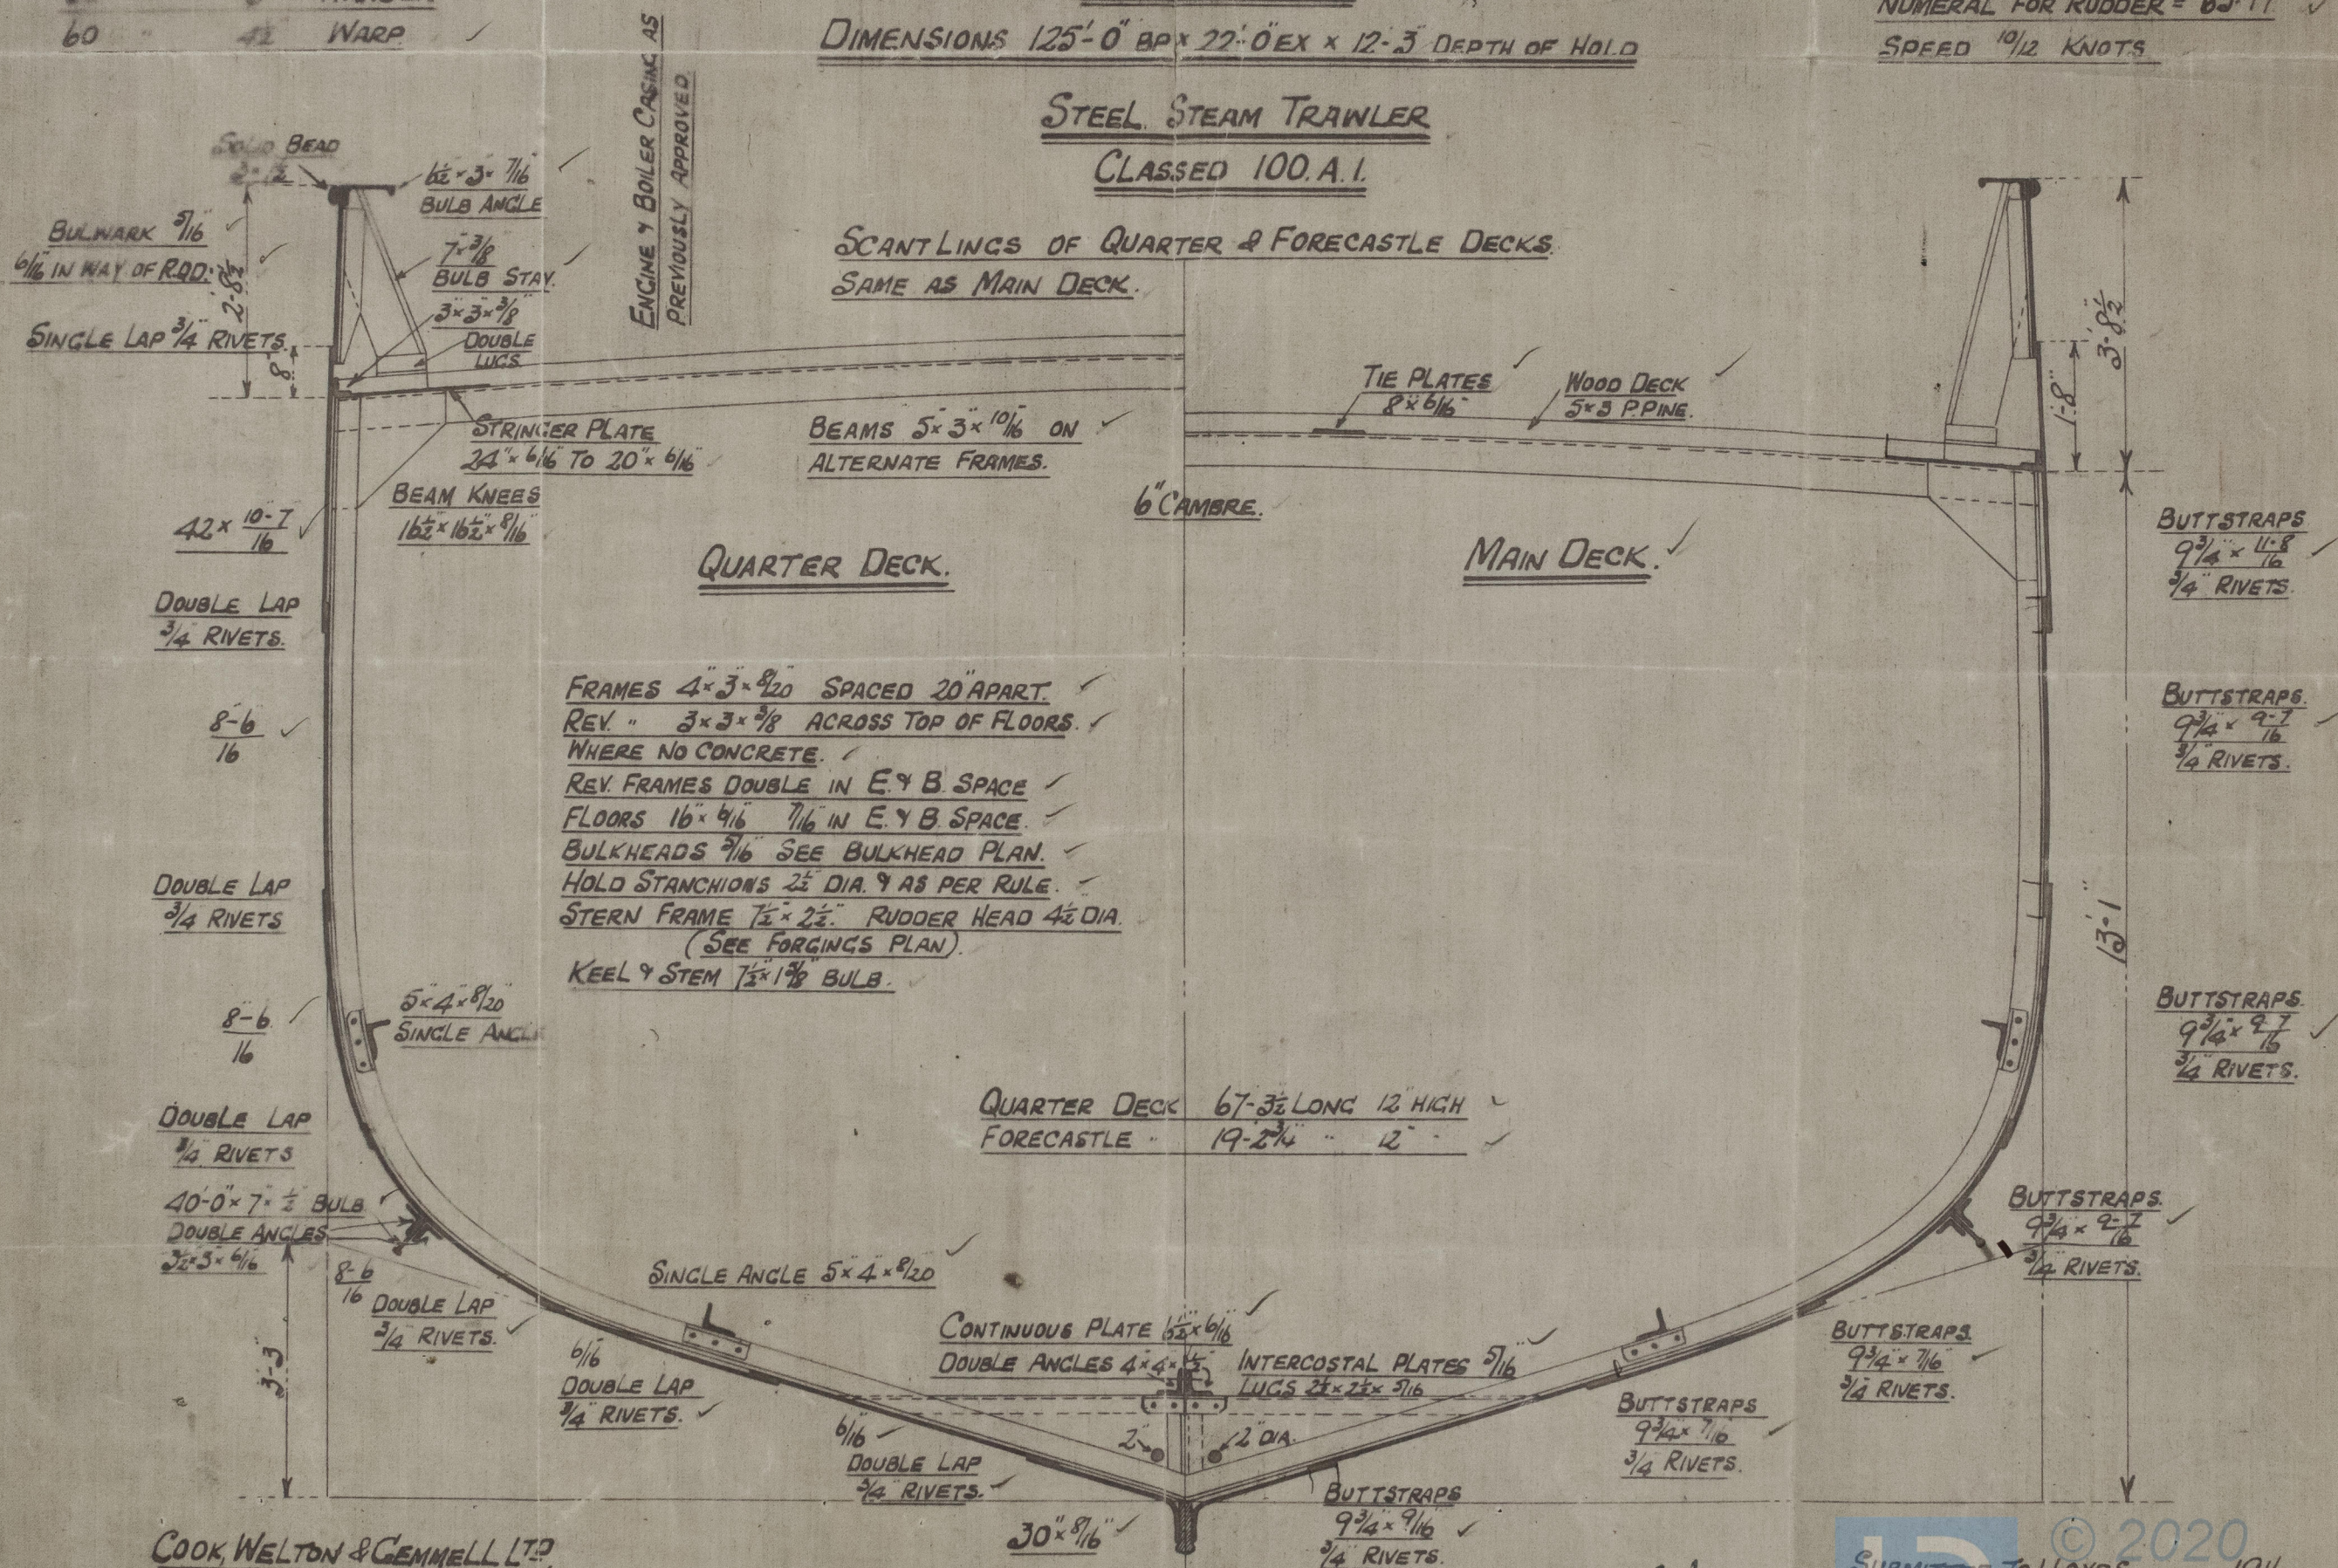

FRAMES 4" x 3" x 1/20" SPACED 20" APART.
REV. " 3" x 3" x 3/8" ACROSS TOP OF FLOORS.
WHERE NO CONCRETE.
REV. FRAMES DOUBLE IN E. & B. SPACE.
FLOORS 16" x 9/16" 7/16" IN E. & B. SPACE.
BULKHEADS 7/16" SEE BULKHEAD PLAN.
HOLD STANCHIONS 2 1/2" DIA. & AS PER RULE.
STERN FRAME 7 1/2" x 2 1/2" RUDDER HEAD 4 1/2" DIA.
(SEE FORGINGS PLAN).
KEEL & STEM 7 1/2" x 1 1/8" BULB.

QUARTER DECK 67'-3 1/2" LONG 12" HIGH
FORECASTLE 19'-2 1/4" " 12" "

COOK, WELTON & GEMMELL LTD.
SHIPBUILDERS,
BEVERLEY.

SUBMITTED TO LLOYDS. 1916
APPROVED BY LLOYDS 1916.

© 2020 Lloyd's Register Foundation

007506 - 007517 - 0172

AMENDED PLAN

MIDSHIP SECTION
Nos 363-4.

BUILDERS.


COOK WELTON AND
GEMMELL



REHEARD
EX
J^s John Burlingham
Hull Rpt No. 30 071

ss. Robert Betson.

Hull Rpt No 30101.

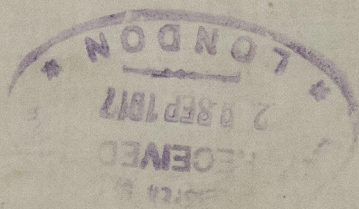

© 2020

Lloyd's Register
Foundation

007506-007517-0172