


SCALE  $\frac{1}{2}$ " TO ONE FOOT.



*21 Melrose*  
*26th May*

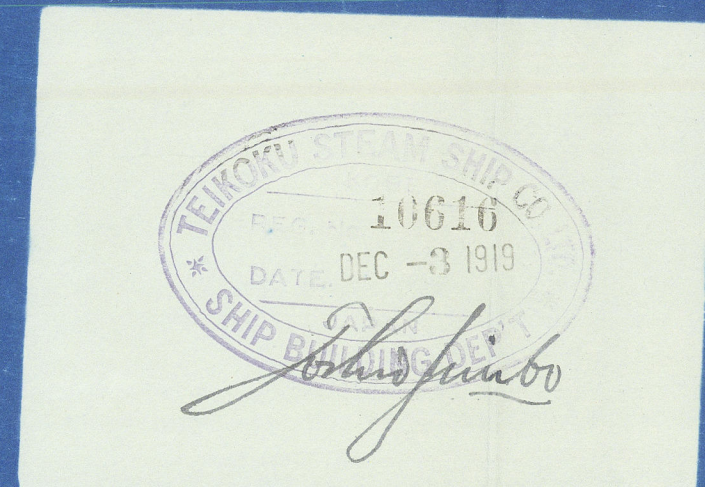

S.S. "SHUNKO MARU"


Harima Shipyard No 30

On: Japan.

Stern Frame & Rudders  
of Vessel as built

Kobe Report No 2680

M<sup>n</sup> "SYUNKO MARU" <sup>4</sup>

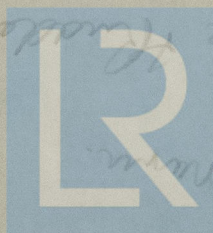

© 2020

Lloyd's Register  
Foundation

007506-007517-0197