


SCALE $\frac{1}{2}$ " TO ONE FOOT.


EQUIPMENT NUMBER		
L x (B + D)		= 35.347
EJECTION	425 x 84 x .75	= 3550
DECK HOUSE	30.33 x 75 x .50	= 114
"	69.3 x 75 x .50	= 260
"	37 x 75 x .50	= 139
		38,410

EQUIPMENTS			
WATER ANCHORS (STOCKLESS TYPE)		68 CWTs. EACH	
"	"	58 1/2 "	
REAM	"	"	2 3/4 " OR 19 CWTs. (EX. STOCK) ORDINARY TYPE
ROPE	"	"	10 " OR 8 " " " " "
FATHOMS		2 5/8" STUD LINK CHAIN CABLE FOR BOWER ANCHOR	
90 FATHOMS	5"	CIR. STREAM STEEL WIRE ROPE	
120	"	5 1/2 "	STEEL WIRE ROPE FOR TOW LINE
90	"	2 3/4 "	" " " " HAWSER
90	"	8"	MANILA ROPE
90	"	2 1/2 "	STEEL WIRE ROPE FOR WARP
90	"	7"	MANILA ROPE

PROPELLER BOSS PLATE 76"
BUTTS LAPPED & QUADRUPLE RIVETED

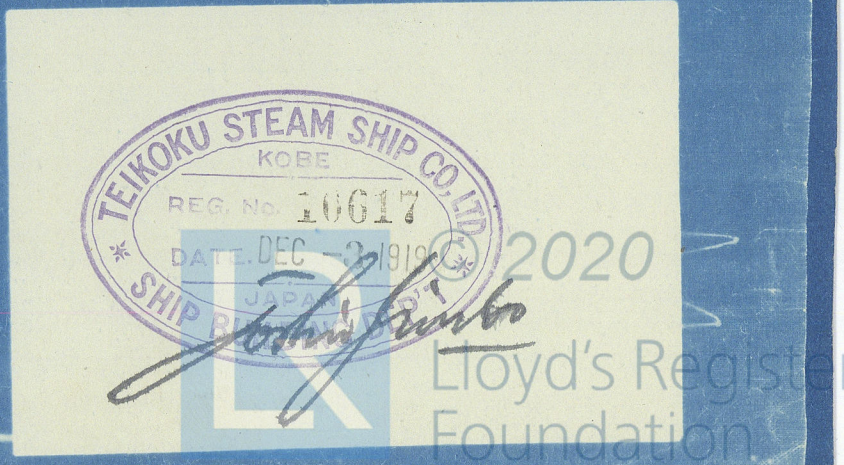

Midships Sec
Star 30
Shunko. Mar.

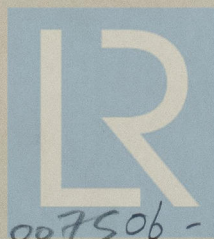

© 2020

Lloyd's Register
Foundation

007506 - 007517 - 0198

S. S. "SHUNKO MARU"


Harima Shipyard No 30

On: Japan.

Midship Section
of Vessel as built

Kobe Report No 2680

M_m "SYUNKO MARU"

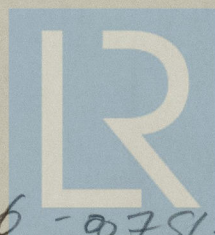

© 2020

Lloyd's Register
Foundation

