

No. 1520.

-2 DEC 1932

Index. No. 21597
(For London Office only.)

Rpt. C.11.

Lloyd's Register of Shipping.

SURVEYS FOR FREEBOARD.

Computation of Freeboard for Steamer, ~~Sailing Ship, Tug~~
having Poop, Bridge and Forecastle.

Port of Survey Wellington.

Date of Survey 25th October, 1932.

Name of Surveyor [Signature]

Particulars of Classification 100 A.1.
S.S. Ank. No. 3-1-28.
S.S. Ank. No. 1-52

Ship's Name SEIAN MARU (Type of Superstructures.)

Nationality and Port of Registry British Japanese
Wellington, Japan

Official Number 127809

Gross Tonnage 1948.23

Date of Build 6/1911

Moulded Dimensions: Length 272'0" Breadth 41'0" Depth 19'11" tons

Moulded displacement at moulded draught = 85 per cent. of moulded depth

Coefficient of fineness for use with Tables

Depth for Freeboard (D)	Depth correction	Round of Beam correction
Moulded depth	(a) Where D is greater than Table depth (D - Table depth) R =	Moulded Breadth (B)
Stringer plate	(b) Where D is less than Table depth (if allowed) (Table depth - D) R =	Standard Round of Beam = $\frac{B \times 12}{50}$
Sheathing on exposed deck $T \left(\frac{L-S}{L} \right) =$	If restricted by superstructures	Ship's Round of Beam
Depth for Freeboard (D) =		Difference
		Restricted to
		Correction = $\frac{\text{Diff}}{4} \times (1 - \frac{S_1}{L})$

DEDUCTION FOR SUPERSTRUCTURES.

	Mean Covered Length (S)	Equivalent Enclosed Length (S ₁)	Height	Height Correction	Effective Length (E)	
Poop enclosed						Standard Height of Superstructure
" overhang						" " R.Q.D.
R.Q.D. enclosed						Deduction for complete superstructure
" overhang						Percentage covered $\frac{S}{L} =$
Bridge enclosed						" " $\frac{S_1}{L} =$
" overhang aft						" " $\frac{P}{L} =$
" overhang forward						Percentage from Table, Line A. (corrected for absence of forecastle (if required))
F'cle enclosed						Percentage from Table, Line B. (corrected for absence of forecastle (if required))
" overhang						Interpolation for bridge less than 2L (if required)
Trunk aft						Deduction =
" forward						
Tonnage opening aft ...						
" forward						
Total						

SHEER CORRECTION.

Station	Standard Ordinate	S	M	Product	Actual Ordinate	Effective Ordinate	S	M	Product	Mean actual sheer aft =	Mean standard sheer aft =
A.P.		1					1				
$\frac{1}{8}L$ from A.P.		4					4				
$\frac{3}{8}L$ "		2					2				
Amidships		4					4				
$\frac{3}{8}L$ from F.P.		2					2				
$\frac{1}{8}L$ "		4					4				
F.P.		1					1				
Total											

Correction = $\frac{\text{Difference between sums of products}}{18} \left(\frac{75 - S}{2L} \right) =$

If limited on account of midship superstructure.

If limited to maximum allowance of $1\frac{1}{2}$ ins. per 100 ft.

Deduction for Tropical Freeboard.

Addition for Winter and Winter North Atlantic Freeboard.

Depth to Freeboard Deck = Ft.

Summer freeboard =

Moulded draught (d) =

Deduction for Tropical freeboard and addition for Winter freeboard = $\frac{d}{4}$ inches =

Addition for Winter North Atlantic Freeboard (if required) =

Deduction for Fresh Water.

Displacement in salt water at summer load water line

$\Delta =$

Tons per inch immersion at summer load water line

T =

Deduction = $\frac{\Delta}{40T}$ inches =

TABULAR FREEBOARD corrected for Flush Deck (if required)

Correction for coefficient

	+	-
Depth Correction		
Deduction for superstructures		
Sheer correction		
Round of Beam correction		
Correction for Thickness of Deck amidships		
Other corrections, scantlings, etc.		

Summer Freeboard =

SUMMER FREEBOARD amidships from Centre of Disc to top of Deck Line, Wood, Steel, Deck:-

Tropical Fresh Water Line above Centre of Disc		Tropical Fresh Water Freeboard	
Fresh Water Line " "		Fresh Water " "	
Tropical Line " "		Tropical " "	
Winter Line below " "		Winter " "	
Winter North Atlantic Line " "		Winter North Atlantic " "	

007506 - 007517 - 0306 1/2

1906 Hudson assigned

007506 - 007517 - 0306 2/2

Particulars of fiddley, funnel and ventilator coamings:— Fiddley opening 8'11" x 24". Hinged steel covers fitted.
Funnel and ventilators riveted to casing top 7'4" above Bridge Deck.

Particulars of Companionways :—

[illegible]

Particulars of Air Pipes in exposed positions on freeboard, raised quarter, or superstructure decks:—

	Forecastle Head:-
<u>Fore Deck:-</u> 4 (2p and 2s) 3" diameter with orifice 12" above deck.	1-3" with orifice 12" above deck.
<u>After Deck:-</u> 2 (1p and 1s) 3" diameter with orifice 12" above deck (s) and 19" above deck (p).	
<u>Bridge Deck:-</u> 2 (1p and 1s) 3" diameter with orifice 12" above deck.	

All fitted with plugs and covers.

Particulars of Gangway Cargo and Coaling Ports:—

Particulars of Side Scuttles : Forecastle:- Port side 5 - 10" lights.
Star side 4 - 10" " .
Poop:- Port side 4 - 10" lights.
Star Side 5 - 10" " .
ALL FITTED WITH HINCED DEADLIGHTS. ✓

Particulars of Guard Rails:— Forecastle and Poop:— Open rails 45" high, 2- $\frac{7}{8}$ " rods, stanchions 1 $\frac{1}{2}$ " top to 1 $\frac{3}{8}$ " bottom 4'6" apart.
Bridge Deck:— Bulwarks 3'6" high, 5 $\frac{1}{2}$ x3" B.A. top rail, stiffeners 3 $\frac{1}{2}$ x3" angle 5'9" apart.
Fore and After Decks:— Bulwarks 4'2" high, 6x3" B.A. top rail. Plating .25", stiffeners 5 $\frac{1}{2}$ x3" B.A. 6'0" apart.

Particulars of Gangways, Lifelines, etc.:— Ample provision for rigging lifelines.

State position of each freeing port ... { After Well:— 11'0", 30'0", 48'0" and 64'0" from Poop bulkhead. } 9" above
(F. and A. position and height above deck edge) { Forward Well:— 10'0", 24'0", 44'0", 59'0" from Bridge front. } deck.

State whether the freeing ports are fitted with shutters, bars, or rails, and give particulars of such:— 2 horizontal bars $\frac{3}{4}$ " diameter.

Bridge, Aft Bulkhead	18"x.37"	.34"	7x3x.5 BA	2'6"	17 BKT. TOP & BOT. 4 RIV. EA. ARM	204"10"x3'3"	26"	7'3"
Bridge, Forward Bulkhead	-	.25"	2 1/2x2 1/2x.25	30" to 42"	-	2 @ 5'6"x2 1/2" OPEN PASSAGEWAY INCH WITH 5 DOORWAYS	12"	7'13"
Forecastle Bulkhead	-	-	-	-	-	-	-	-
Trunk, Aft	-	-	-	-	-	-	-	-
Trunk, Forward	-	-	-	-	-	-	-	-
Exposed Machinery Casings on Free- board or Raised Quarter Decks ...	-	-	-	-	-	-	-	-
Exposed Machinery Casings on Super- structure Decks30"	.25"	2 1/2x2 1/2x.25	24" to 30"	TOP 12 BKT. 3 R. BOTTOM NIL	5'6".2 1/4" ENG. R. 5'6"x1 1/4" FLOORLEY	12"	7'13"
Machinery Casings within Superstruc- tures not fitted with Class I Closing Appliances40"	.30"	2 1/2x2 1/2x.25	24" to 30"	STEEL CONTINUOUS FROM F.B. DECK TO TOP OF CASING	-	-	7'13"

Pool Bulkhead	Teakwood Doors 1½" thick. Opens from both sides.
Raised Quarter Deck Bulkhead ...	----
Bridge, After Bulkhead	3" boards in channels. 1906
Bridge, Forward Bulkhead	Hinged watertight doors. 10 dogs and wedges.
Forecastle Bulkhead	Teakwood Doors 1½" thick. Opening from both sides.
* Exposed Machinery Casings on Freeboard or Raised Quarter Decks ...	----
Exposed Machinery Casings on Superstructure Decks	{ Engine Room Doors teak 1½" thick. Opens from both sides.
Machinery Casings within Superstructures not fitted with Class I Closing Appliances	{ Fiddle Doors steel ½" thick in halves. Upper half lock & handles, lower half slip bolts inside.
* Deckhouses on Flush Deck Ships ...	----

PARTICULARS OF PROTECTION TO OPENINGS, ETC.

HATCHWAYS ON FREEBOARD AND SUPERSTRUCTURE DECKS												
Description of Hatchway	No.1 Cargo.	No.2 Cargo.	No.3 Cargo.	No.4 Cargo.	BUNKER ON BRIDGE DECK	TRIMMING ON BRIDGE DECK	BUNKER ON BOAT DECK	BUNKER IN BRIDGE SPACE	TRIMMING IN BRIDGE SPACE	ESCAPE ON FORE DECK		
Dimensions of Hatchway	23'-4" x 18'-0"	23'-4" x 18'-0"	23'-4" x 18'-0"	23'-4" x 18'-0"	7'-0" x 5'-10"	4'-0" x 2'-11"	3'-11" x 16'-0"	7'-1" x 6'-0"	3'-11" x 3'-0"	3'-4" x 1'-9 1/2"		
COAMINGS	Height above Deck	34"	34"	34"	34"	18"	18"	3"	9"	9"	30"	
	Thickness	.46	.46	.46	.46	.40	.37	3x3x3/8oa	9" B	9" B	.37	
	Sides					Casings	.37					
	Ends											
	Stiffeners	5 1/2 x 3/8 L	5 1/2 x 3/8 L	5 1/2 x 3/8 L	5 1/2 x 3/8 L							
	Brackets, Stays	10" BELOW TOP 2 @ 24" EA. SIDE	10" BELOW TOP 2 @ 24" EA. SIDE	10" BELOW TOP 2 @ 24" EA. SIDE	10" BELOW TOP 2 @ 24" EA. SIDE							
HATCH BEAMS	Number	5	5	5	5	Nil	Nil	Nil	Nil	Nil	Nil	
	Spacing	47"	47"	47"	47"							
	Scantling and Sketch											
	Bearing Surface	3 1/2"										
FORE AND AFTERS	Number	Nil	Nil	Nil	Nil	Nil	Nil	Nil	Nil	Nil	Nil	
	Spacing											
	Unsupported Lengths											
	Scantling* and Sketch											
	Bearing Surface											
HATCH COVERS	Material	Wood	Wood	Wood	Wood	Wood	Wood	Wood	Wood	Wood	Wood	
	Thickness	2 1/2"	2 1/2"	2 1/2"	2 1/2"	2 1/2"	2 1/2"	2 1/2"	2 1/2"	2 1/2"	2 1/2"	
	How fitted	F&A	F&A	F&A	F&A	F&A	Thwart	F&A	F&A	Thwart	F&A	
	Bearing Surface	2 3/8 COAMINGS 4" BEAMS.	2 3/8 COAMINGS 4" BEAMS.	2 3/8 COAMINGS 4" BEAMS.	2 3/8 COAMINGS 4" BEAMS.	2 1/2" F&A 2 1/2"	2 1/2"	2 1/2"	3"	2 1/2"	2 1/2"	
Spacing of Cleats	24"	24"	24"	24"	20" AT SIDES CONTIN. BARE ENDS	18" SIDES 25" ENDS.	42"	20"	18"	15" SIDES 10" ENDS.		
Number of Tarpaulins	3	3	3	3	2	3	2	2	2	3		
*Are wood fore and afters steel shod at all bearing surfaces? No Fore and Afters fitted. Are battens and wedges efficient and in good condition? Yes. Are tarpaulins in good condition and in accordance with rule requirements? Yes. Are lashings provided in accordance with rule requirements? Yes.												

Particulars of fiddley, funnel and ventilator coamings:— Fiddley opening 8'11" x 24". Hinged steel covers fitted.
Funnel and ventilators riveted to casing top 7'4" above Bridge Deck.

Particulars of Flush Bunker Scuttles :—

Particulars of Companionways :—

Particulars of Ventilators in exposed positions on freeboard and superstructure decks :-

<u>Fore Deck:-</u>	6-18" vents. / 36" coamings, .31" thick, riveted to deck with 2½x2½ angle.
<u>After Deck:-</u>	8- " " " " " " " " " "
	1-8" vent to tunnel.
<u>Bridge Deck:-</u>	2-18" vents. / 18" coamings, .31" thick, riveted to deck with 2½x2½ angle.

All fitted with plugs and covers.


Particulars of Air Pipes in exposed positions on freeboard, raised quarter, or superstructure decks :-

	Forecastle Head:-
<u>Fore Deck:-</u> 4 (2p and 2s) 3" diameter with orifice 12" above deck.	1-3" with orifice 12" above deck.
<u>After Deck:-</u> 2 (1p and 1s) 3" diameter with orifice 12" above deck (s) and 19" above deck (p).	
<u>Bridge Deck:-</u> 2 (1p and 1s) 3" diameter with orifice 12" above deck.	

All fitted with plugs and covers.

Particulars of Gangway Cargo and Coaling Ports :—

Superstructure bulkheads, trunks, deckhouses, casings, cargo and coaling hatchways, extent and thickness of sheathing on the freeboard deck, gangway, cargo and coaling ports, and any other openings, etc., which would affect the seaworthiness of the ship are to be shewn on the following sketches:—

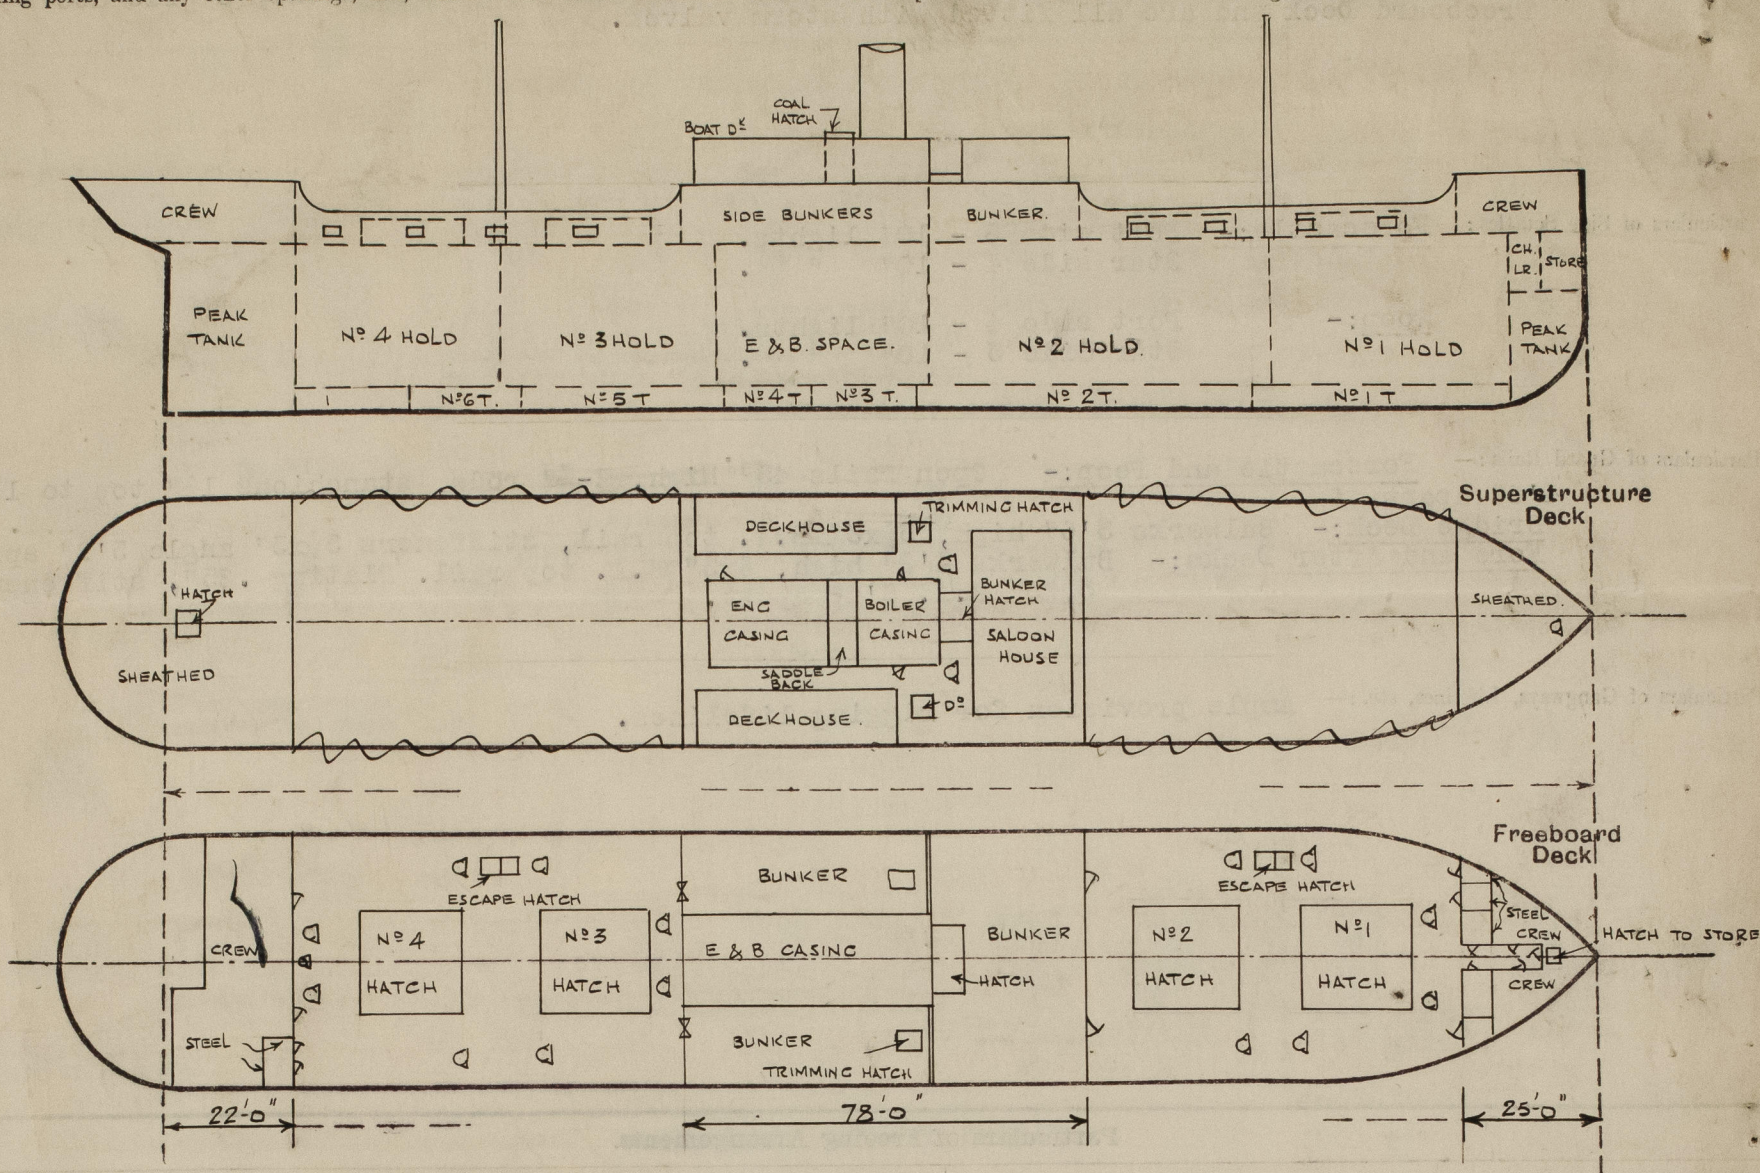

State any special features in the construction of the ship:— Engine Room Skylight:— Steel, 3 flaps each side with 2 Bulls-eyes in each flap.

Survey carried out afloat at Miramar Wharf, Wellington.

Builder's name and yard number Ramage and Ferguson Limited, Leith. No. 225.

Names of sister ships ----

Owners Union Steam Ship Company of New Zealand, Limited, Wellington.

Fee £ 9. : 7. : -. Received by me _____



© 2020

Register
SURVEYOR TO LLOYD'S REGISTER
WELLINGTON, N.Z.