

20.10.10



Side plating .54


Size frame ?  
5' x 3' x .40' ✓

Sketch showing Bridge Side

Plating fitted in one stroke

S. S. No 225

Scale: - 1/2" = 1 Foot

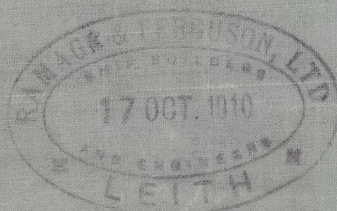

C.B.  
20.10.10



© 2020  
Lloyd's Register  
Foundation



S.S. 4:225

Sketch showing  

Wm. Ramage - Engineer  
Leith



© 2020

Lloyd's Register  
Foundation

007506 - 007817 - 0367