



14.9.10

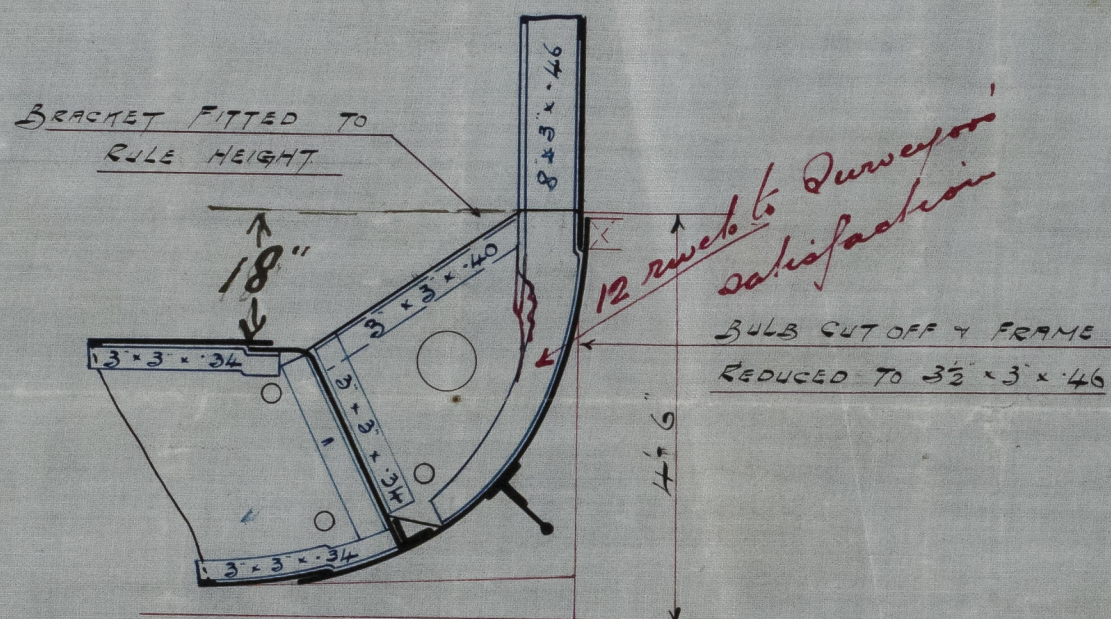

SKETCH OF WING BRACKET
AS FITTED.

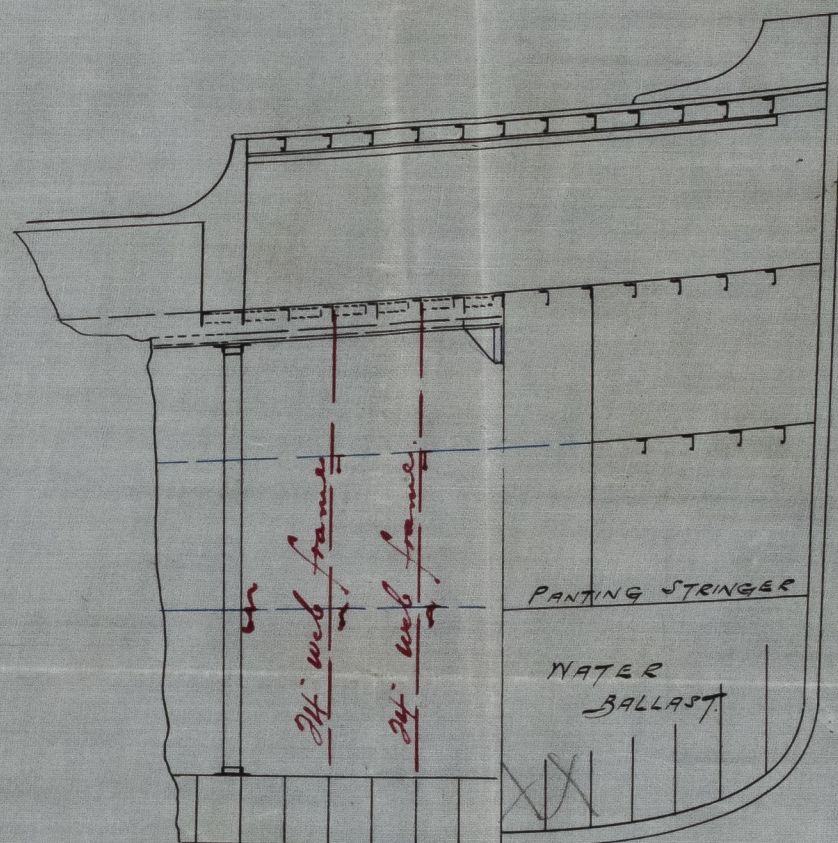

AS SIDE STRINGERS ARE BEING FITTED,
BEAMS IN RED ARE BEING DISPENSED WITH.
OWNER DOES NOT WISH TO FIT SAME, AS
THEY OCCUPY VALUABLE HOLD SPACE

S. S. N° 225


Scales:- 1/2" & 1/8" = 1 Foot

AS.

14.9.10



1910.
Manager Ferguson's
S.S. N° 225
Proposed Alterations
in
Side Stringers
and beams
Leith

 

89300-715700-905400



© 2020
Lloyd's Register
Foundation