
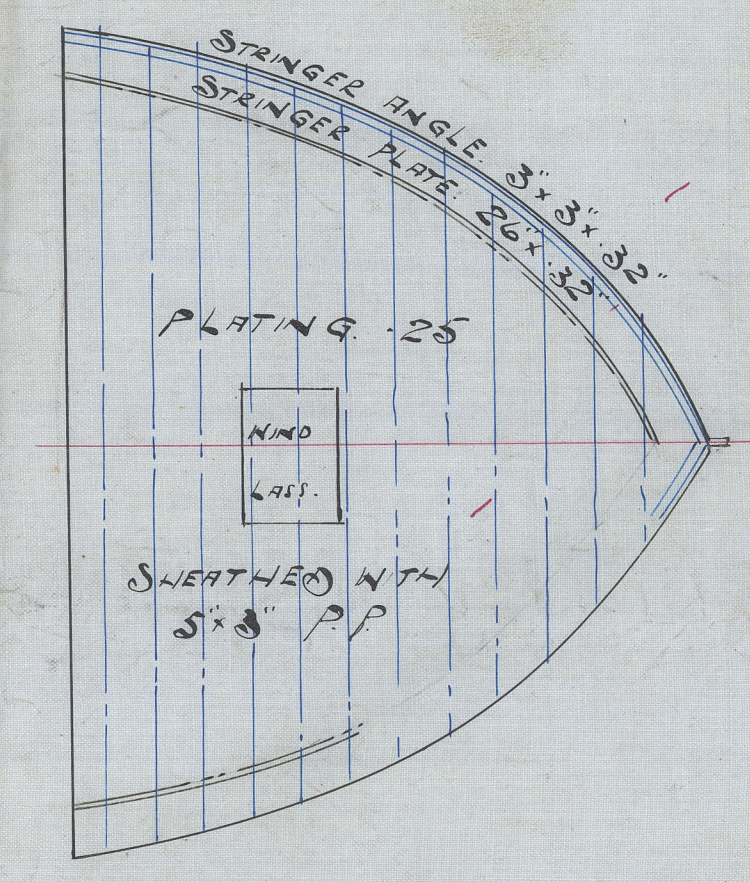
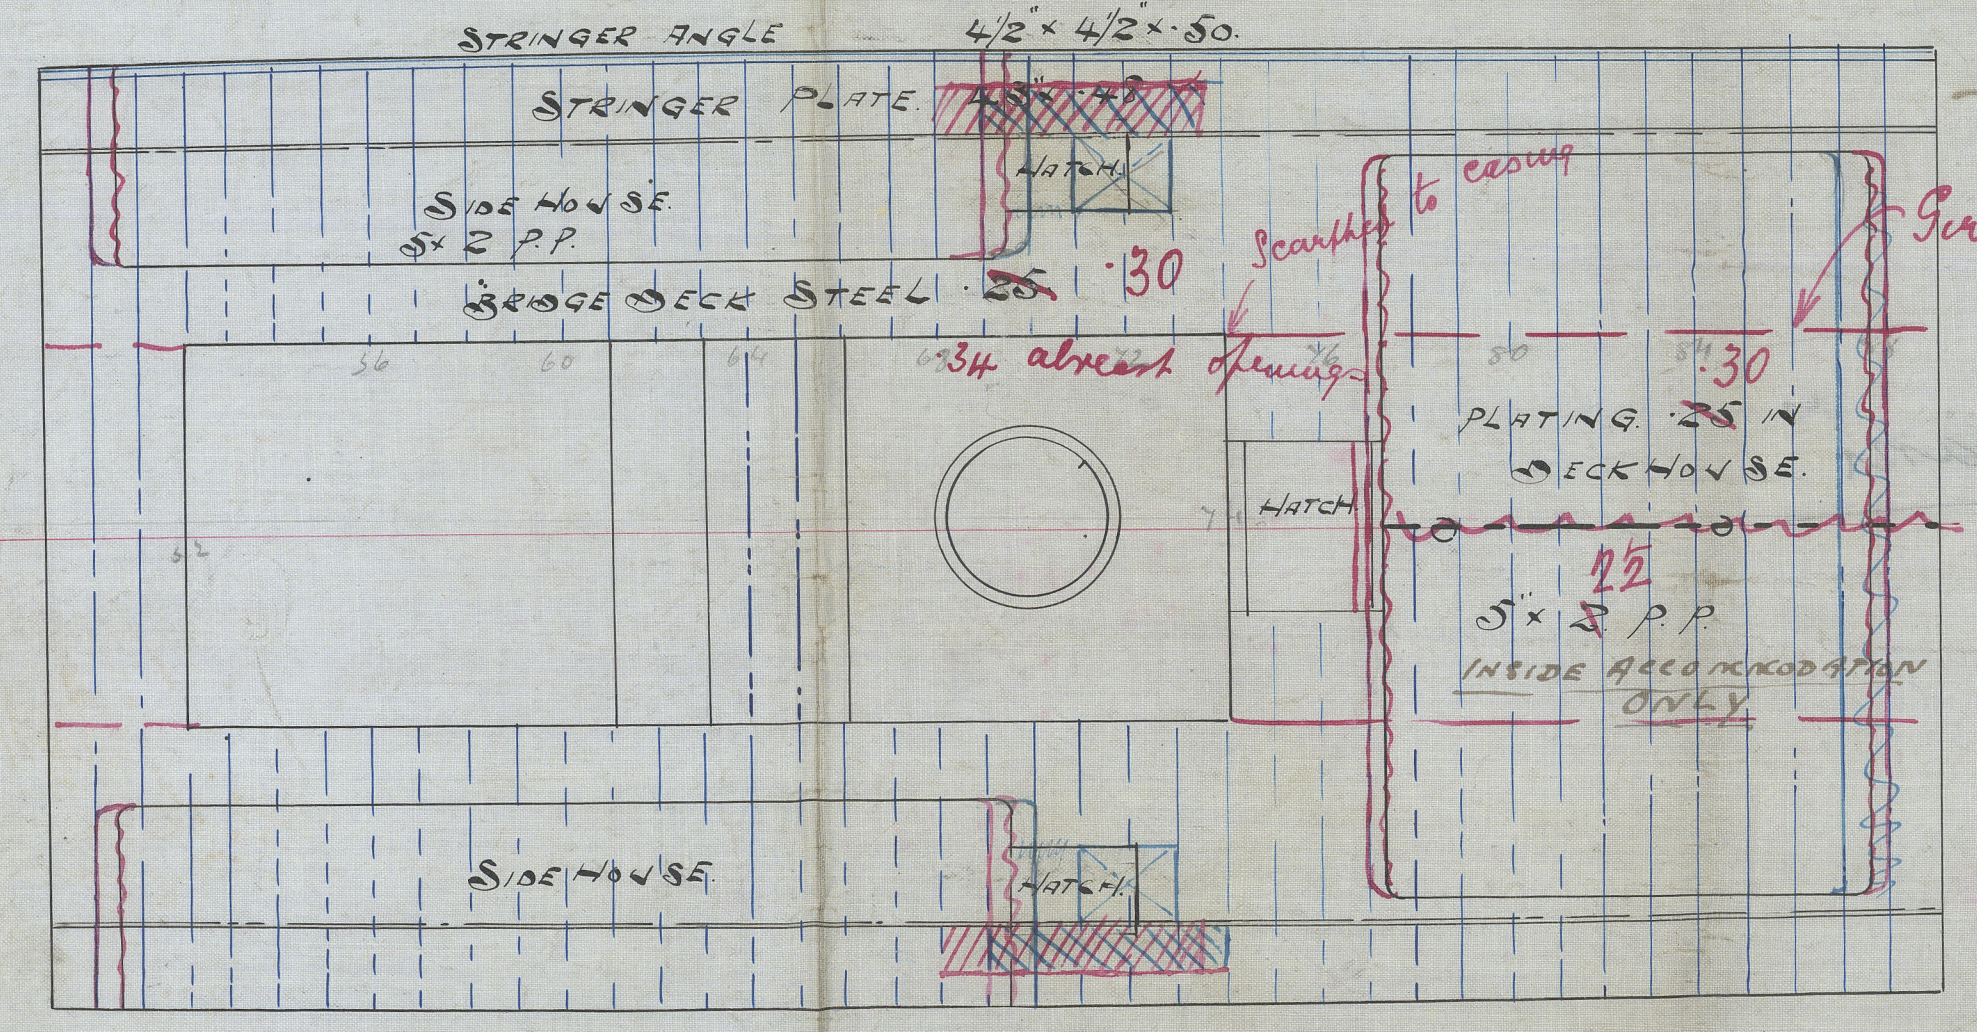


5-9-10.
14-9-10
21-9-10
7-10-10
17-10-10
20-10-10
2-11-10
11-5-11

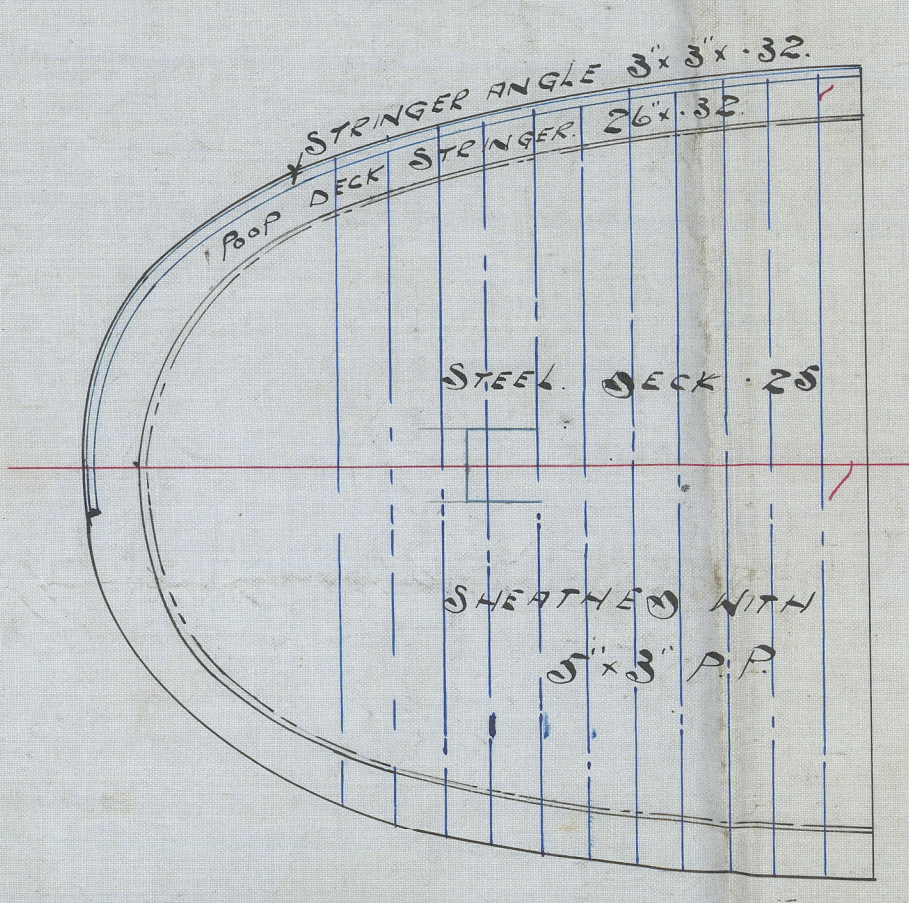

For Scantlings of Beams on this section





LLOYDS PROFILE.

S.S. No 225.

SCALE 1/8" = 1 FT.

CLASS 100/1 AT LLOYDS


ONS. 27' 5" x 4' 0" x 19' 10"

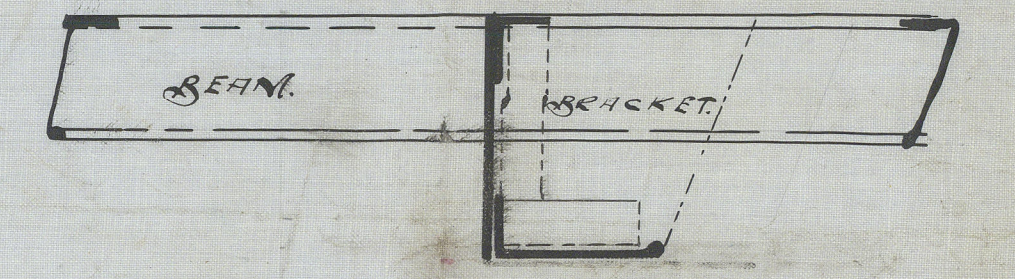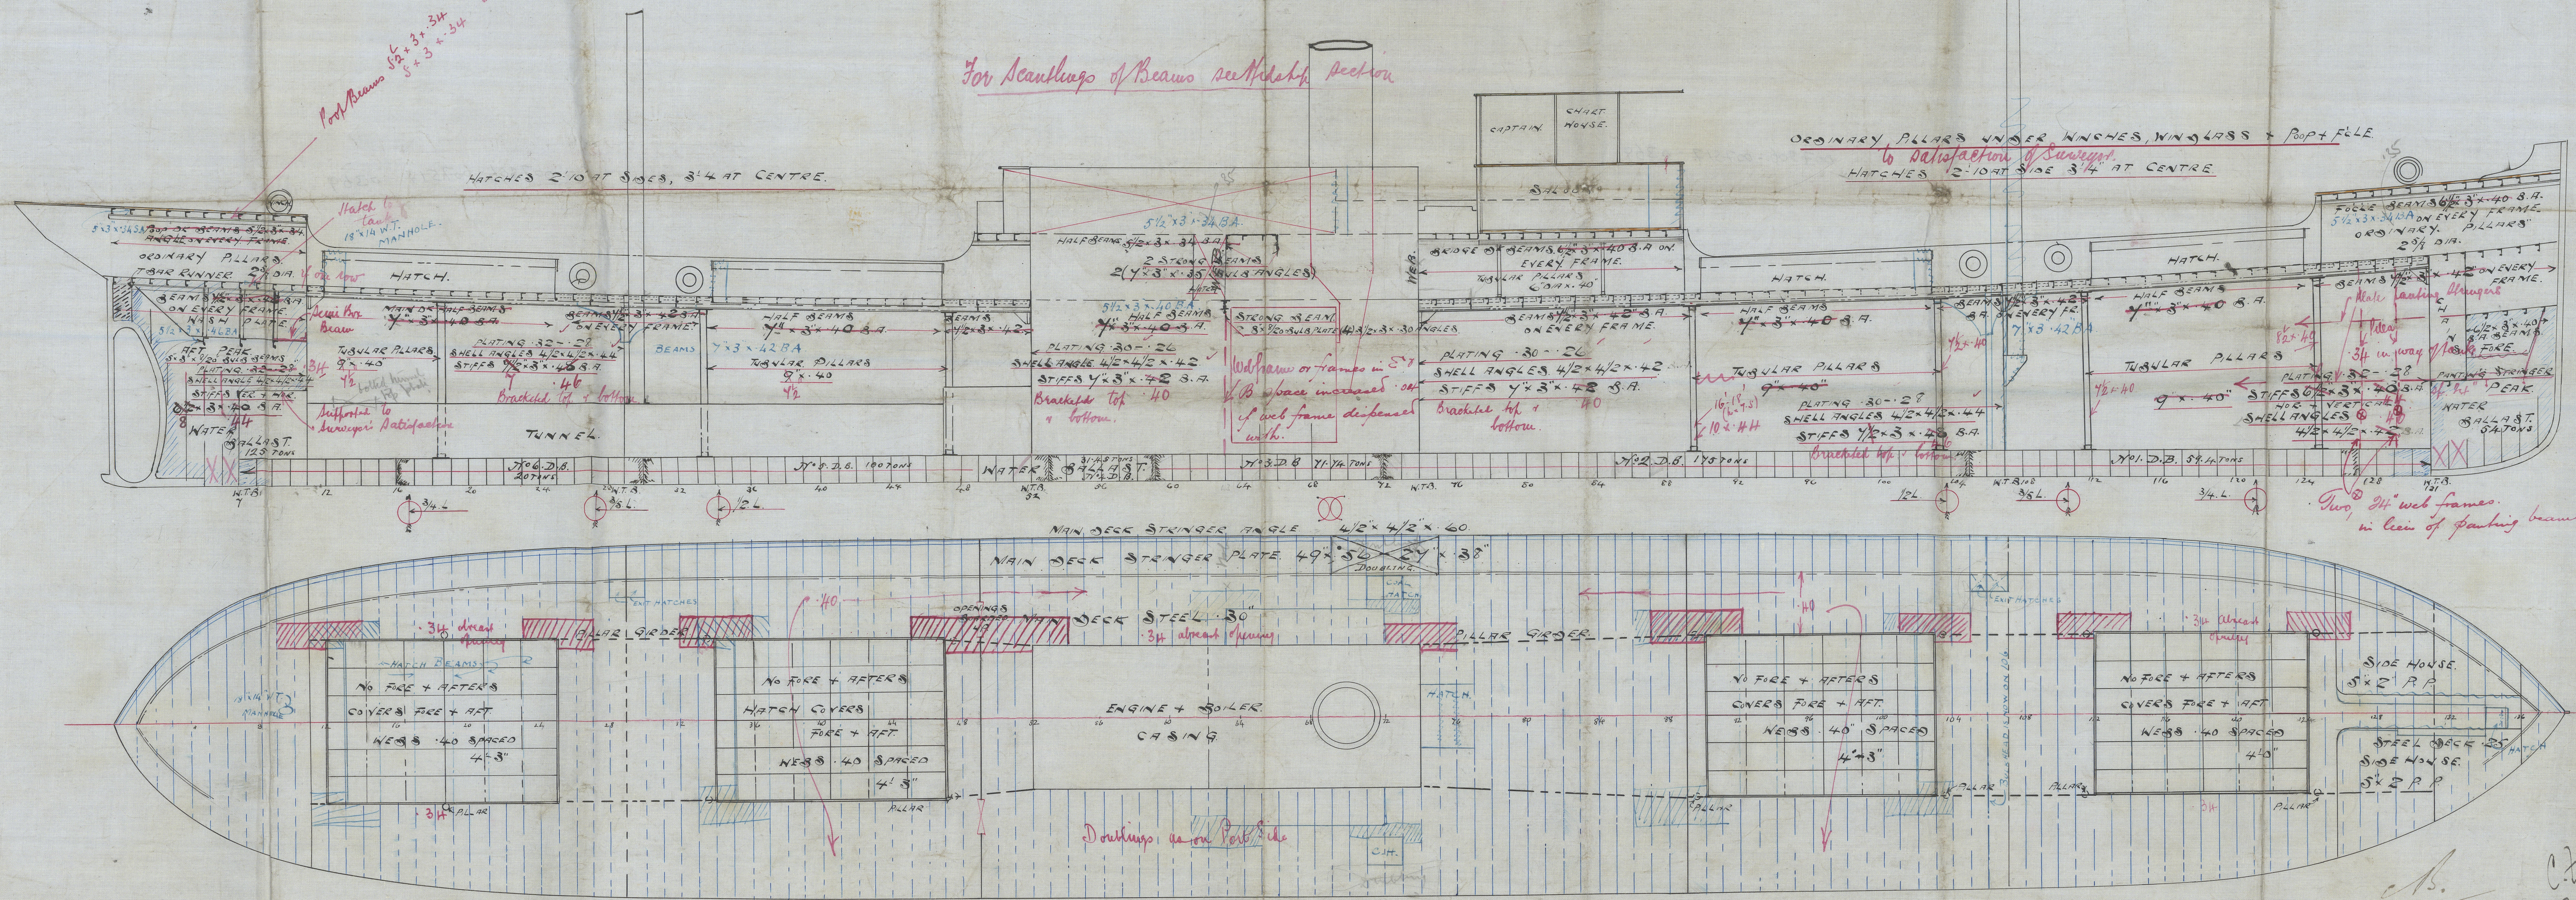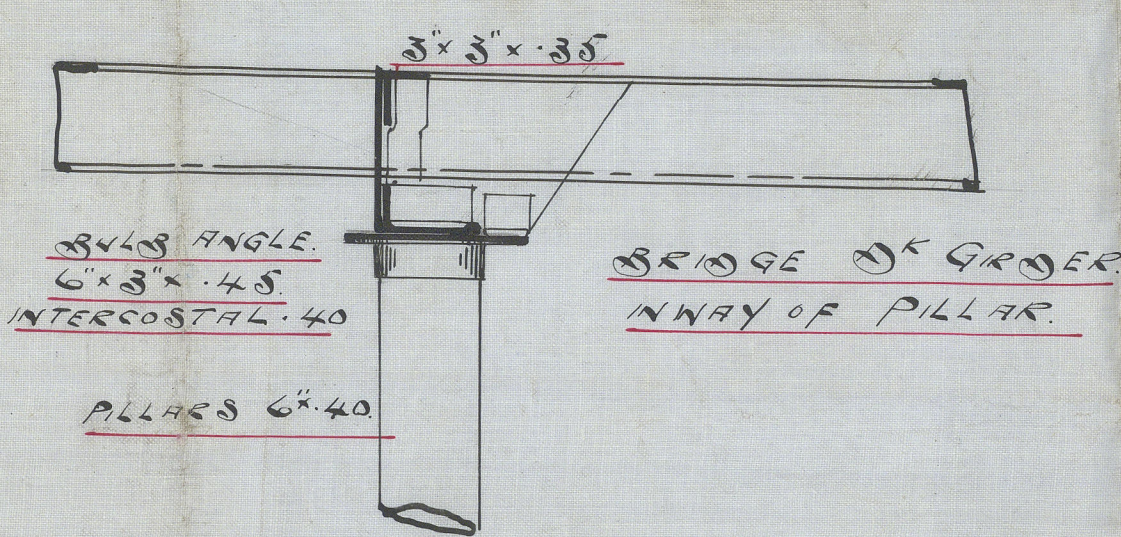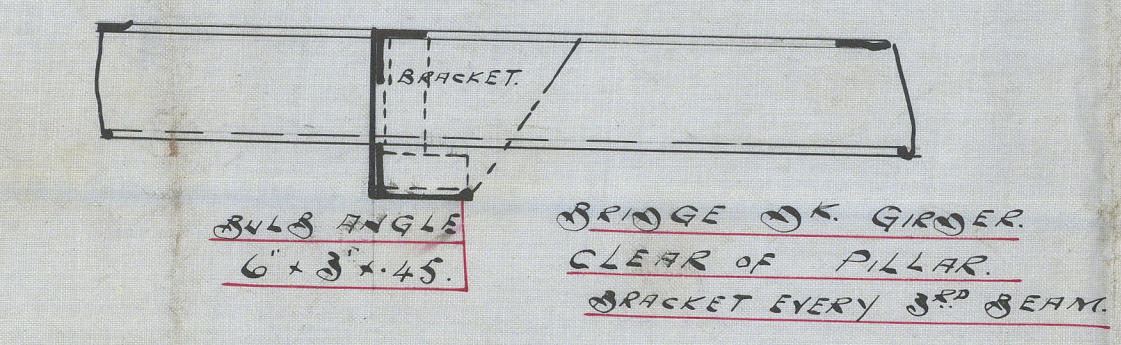


NOTE:- ALL BULKHEAD STIFFENERS TO BE INCREASED IN THICKNESS .02" AND NO BRACKETS FITTED TO DECKS OR TANK TOP AS PER PROFILE.

11.9.10

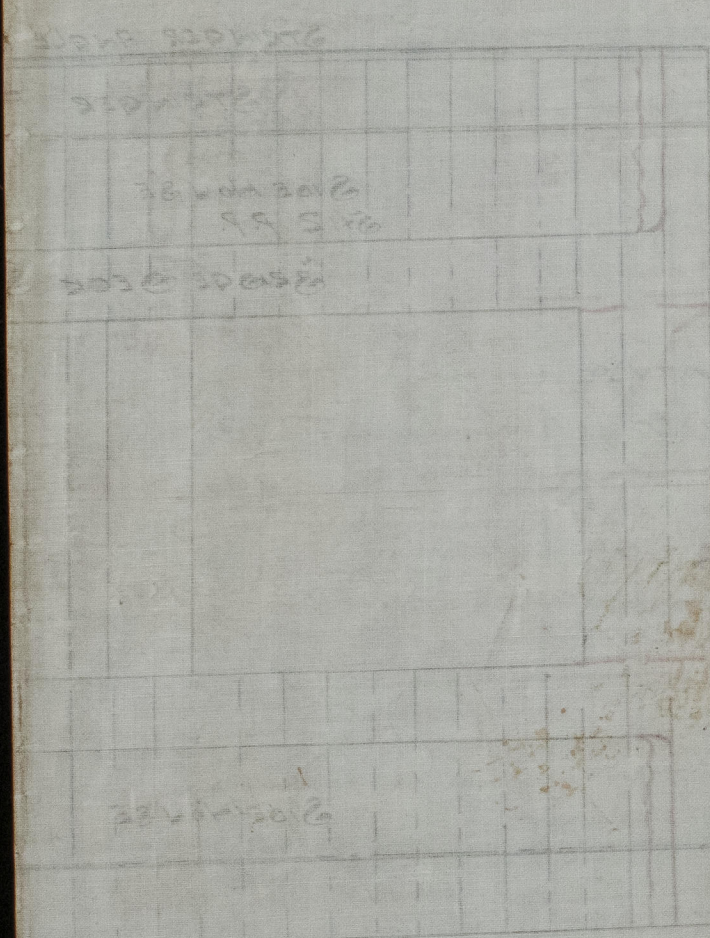


007806-007517-0369

Ramage & Ferguson's
S S N° 225

Profile Plan.

Leith

N^o 1
M^o Seian Man^o

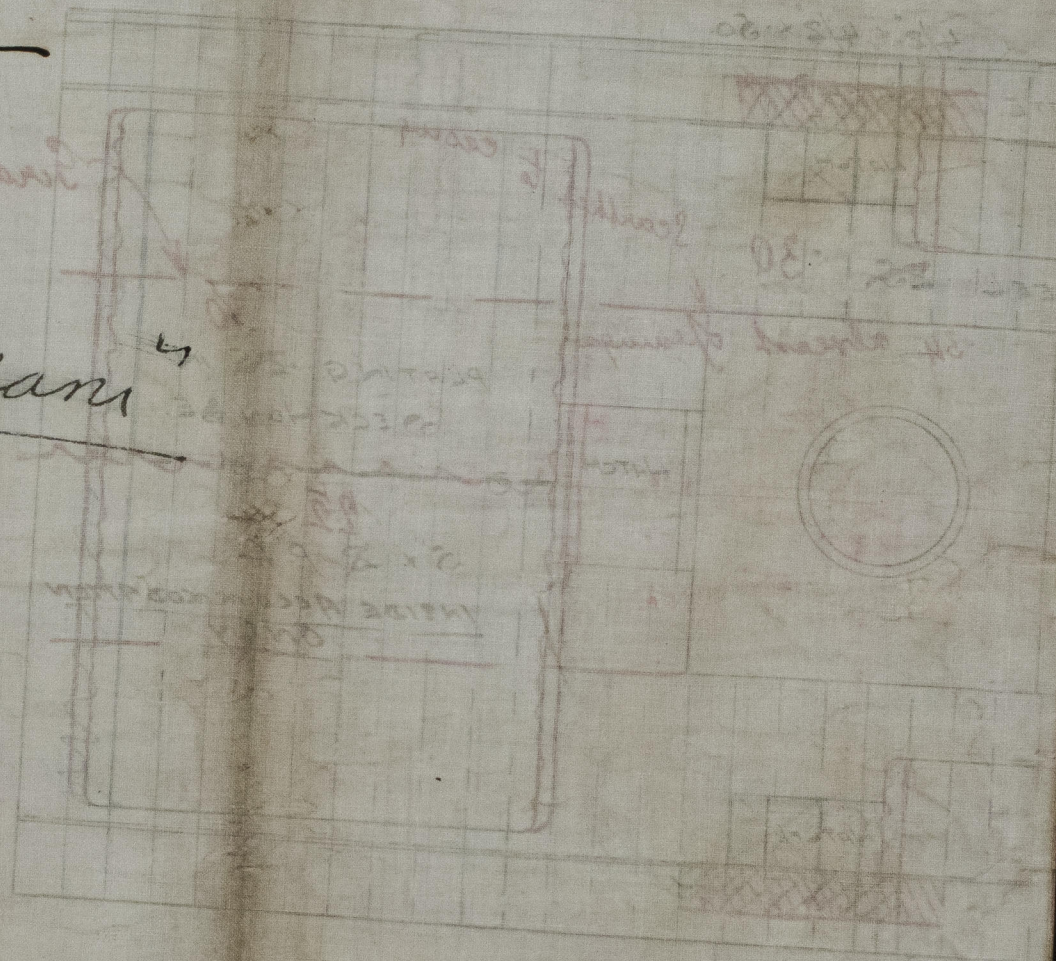

© 2020

Lloyd's Register
Foundation

007506-007517-0369