
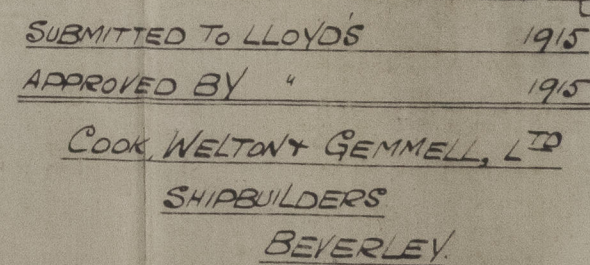
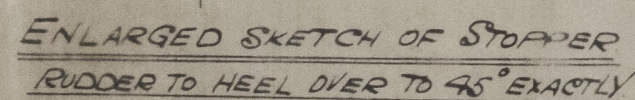


SCALE $\frac{3}{4}'' = 1 \text{ FOOT.}$



HOLES DRILLED 5 DIA² APART FOR $\frac{3}{4}$ " RIVETS
NUMERAL FOR RUDDER = 53 59
SPEED 10-12 KNOTS
THICKNESS OF SIDE PLATES = 31

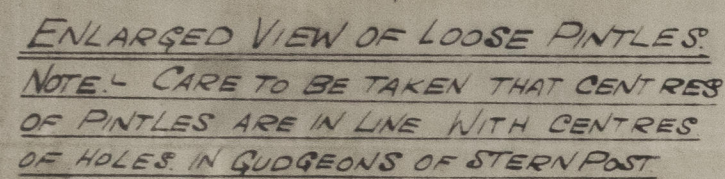

STERN FRAME.

SCALE $\frac{3}{4}'' = 1 \text{ FOOT}$

HOLES DRILLED FOR 1" RIVETS 5 DIA^s APART.

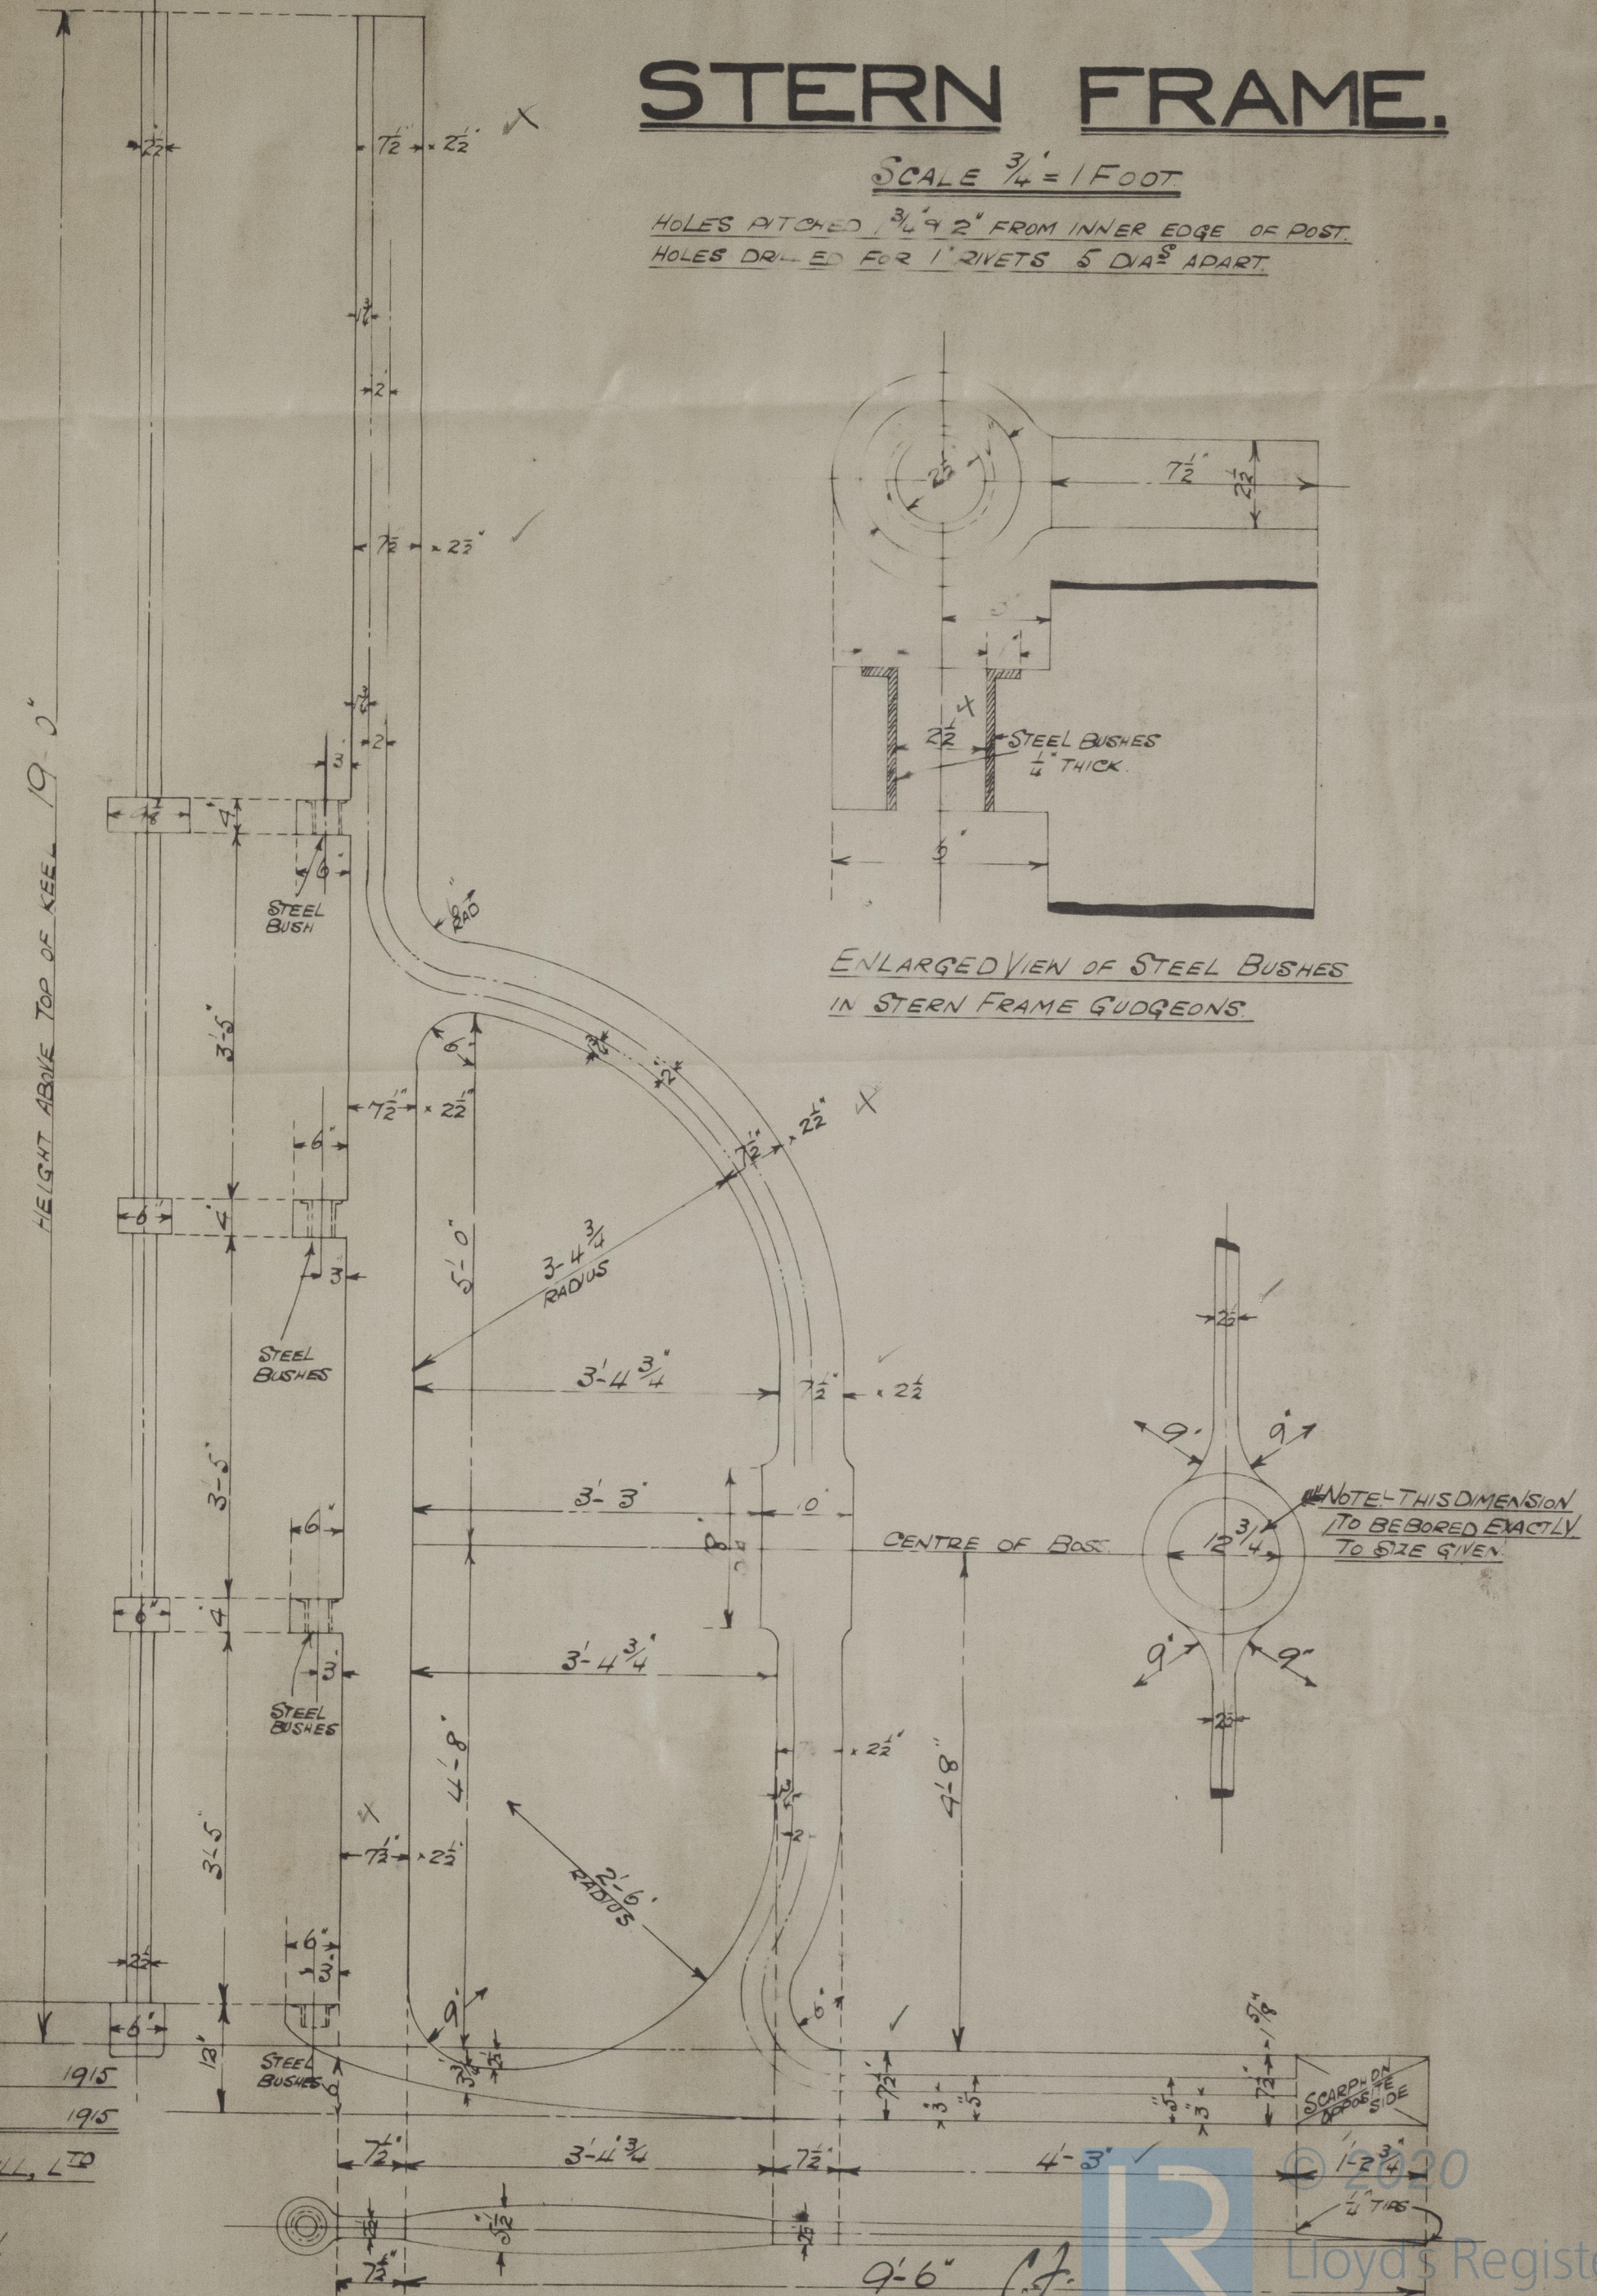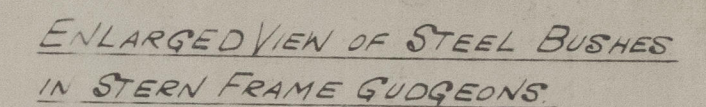


N^{os} 329-30-1-2-3+4

COOK WELTON & GEMMELL

STERN FRAME & RUDDER



S. H. R. S. Hull Rpt No. 28988.

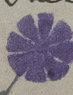 $\frac{1}{2}$ Regards " " " 29019.
 $\frac{1}{3}$ Recono " " " 29211
 $\frac{1}{5}$ Riskato " " " 29358
 $\frac{1}{5}$ Respark " " " 29434
 $\frac{1}{5}$ Royals " " " 29488.



© 2020

Lloyd's Register
Foundation

007518-007527-0012