
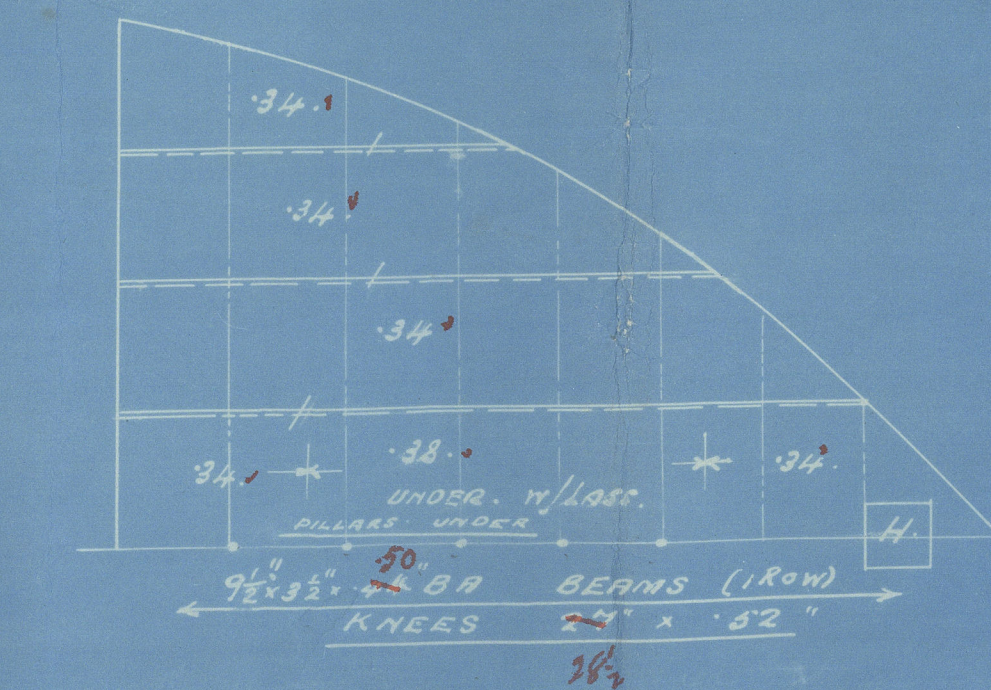


STEEL DECKS

S. S. Nos 7 AND 8.

SCALE. 1/8" = 1 FOOT.

Lengths of Latches as fitted
as shown in black ink.

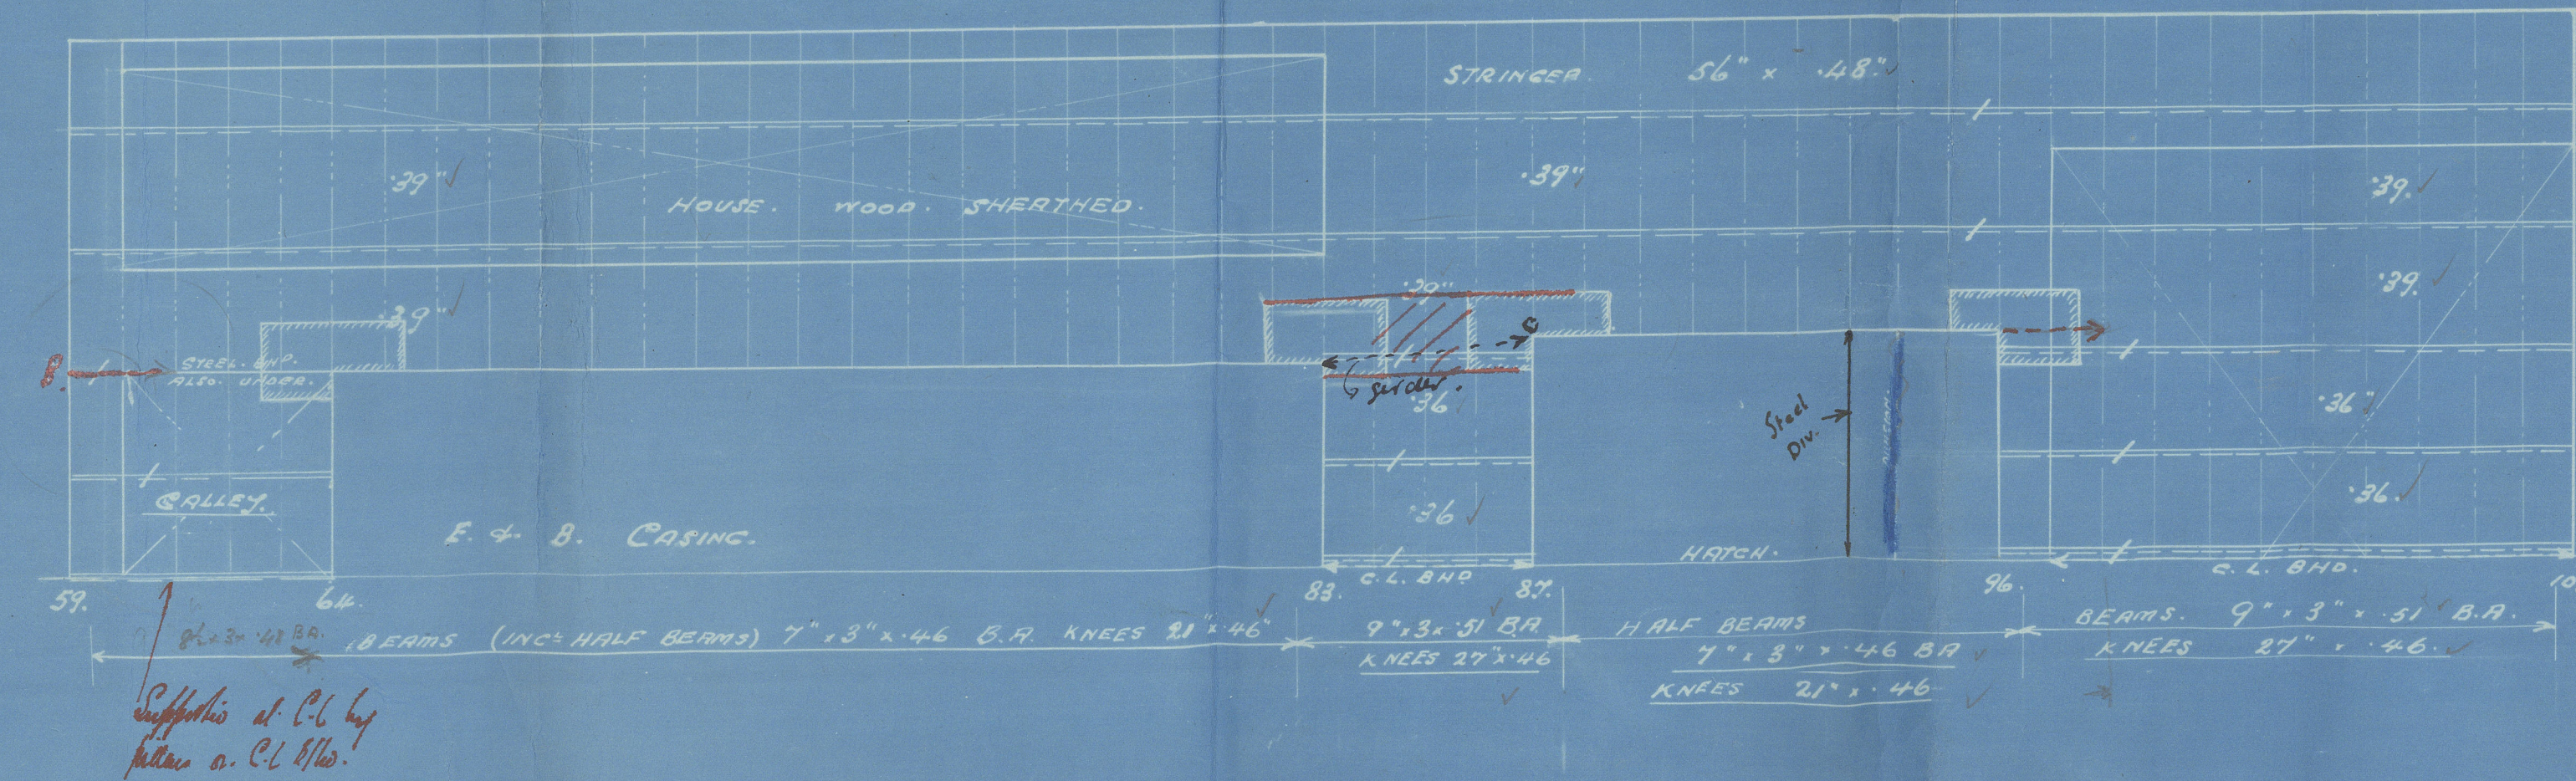

UPPER DECK.

NOTE: 1" Rivets thro. butts and seams of plating outside bridge (over 72")
3/8" (under 72" over 5")
3/16" in remainder between brackets and each end.

NOTE FOR ARR. OF PILLARS & GIRDERS.
SEE PROFILE.

APPROVED
LLOYD'S REGISTER OF SHIPPING
DATE 28.2.23

Blythswood 7 + 8

Deck Plans

GLASGOW REPORT No. 43966

7 "Jarnworth" *

8 "Warkworth"

Glasgow Rps 44210

"AQUITANIA"