


M.V. "UYO MARU"

Nagasaki Report No. 1916.

4 Sinanogawa. Mari 7

M.S. UYO-MARU
STERN FRAME
& RUDDER
(FINISHED PLAN)
SCALE 1/2 INCH TO 1 FT

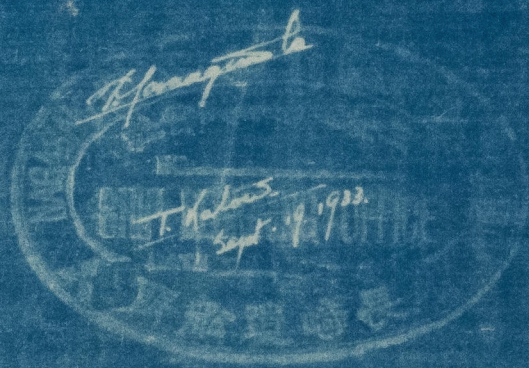

007553-007562-0260

007553-007562-0260

© 2020
Lloyd's Register
Foundation