
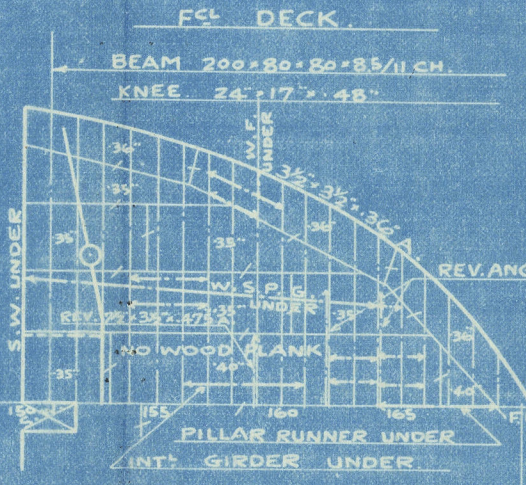
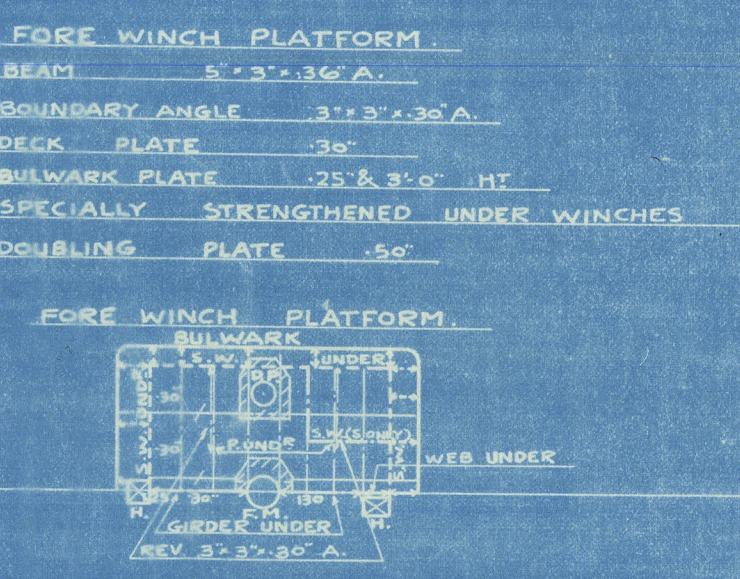


FORE WINCH PLATFORM
SPECIALLY STRENGTHENED UNDER WINCHES

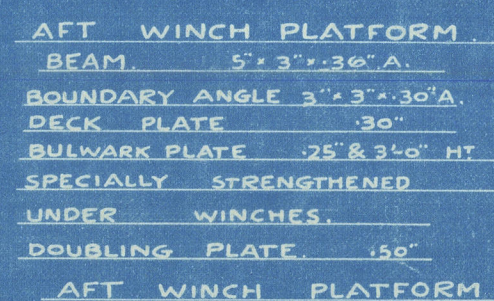

"Sinanoyawa Maru"
M.V. "UYO MARU"

Nagasaki Report No.1916.


"M.S. UYO-MARU"

CONSTRUCTION PROFILE
& DECK PLAN

(FINISHED PLAN)

SCALE $\frac{1}{6}$ INCH TO 1 FOOT

(435'-0" x 58'-6" x 32'-10")

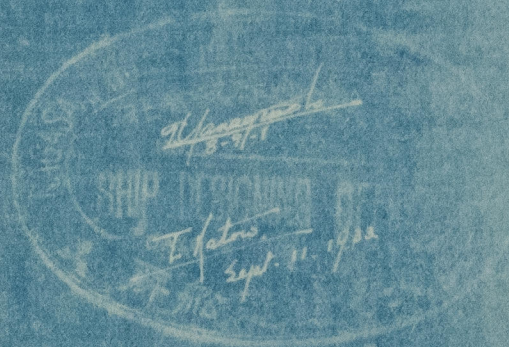

© 2020

Lloyd's Register
Foundation

007553-007562-0261

007553-007562-0261