
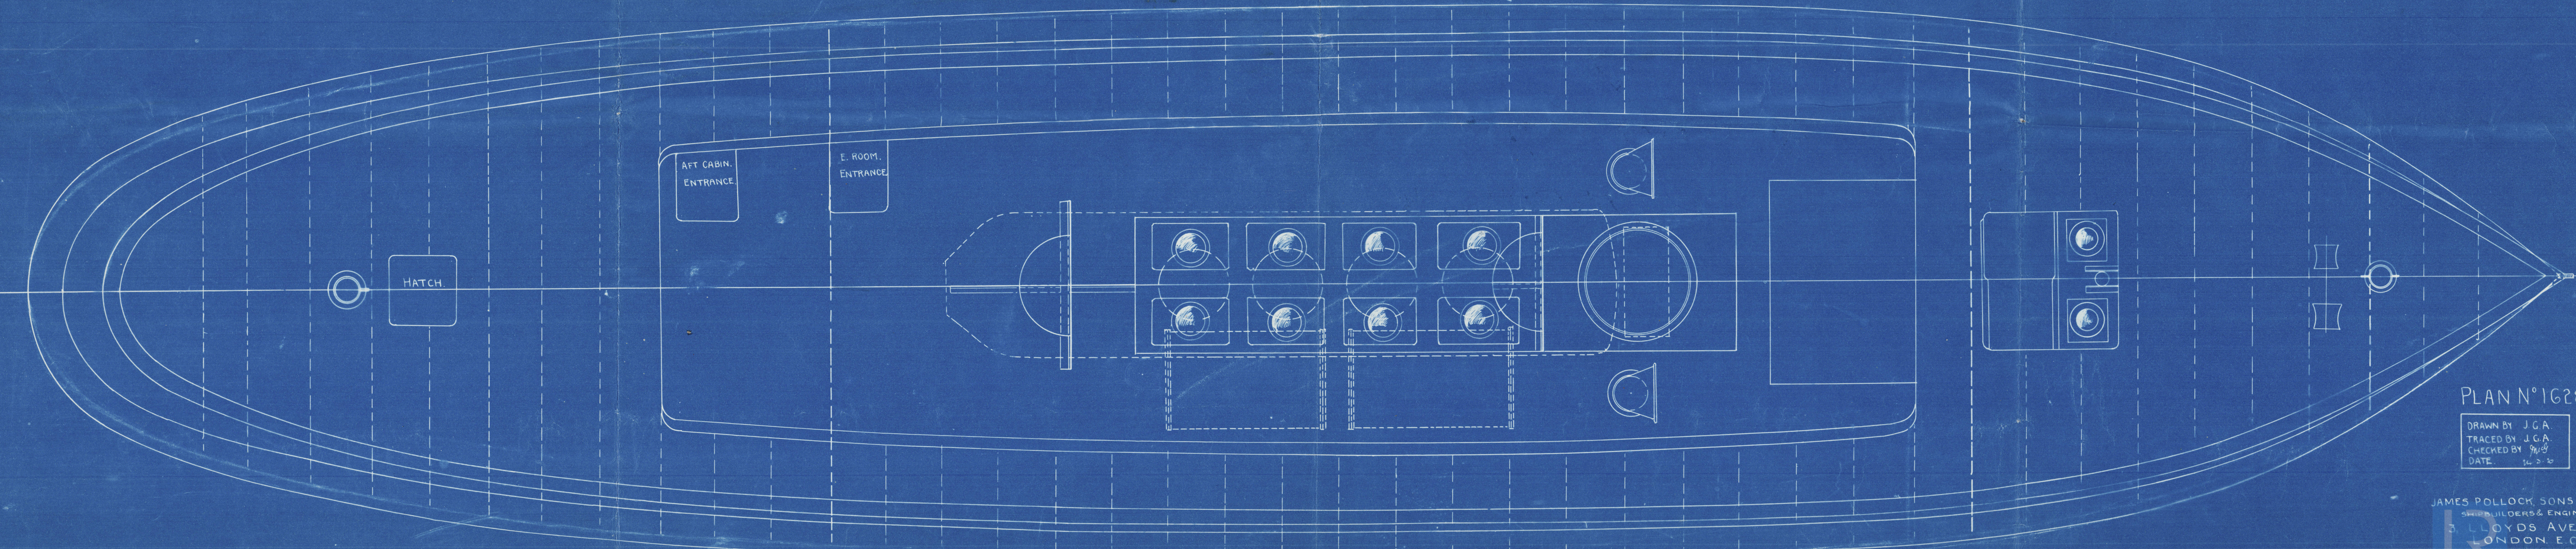


GENERAL ARRANGEMENT NEW MOTOR TUGS. SHIP N^o 939/40.

SCALE $\frac{1}{2}$ " = 1 FOOT.
DIMENSIONS: 70'-0" BP 75'-0" OA x 16'-3" MLD x 8'-6" MLD

TRANSVERSE N^o 25-25
LONGITUDINAL N^o 17-6-5.

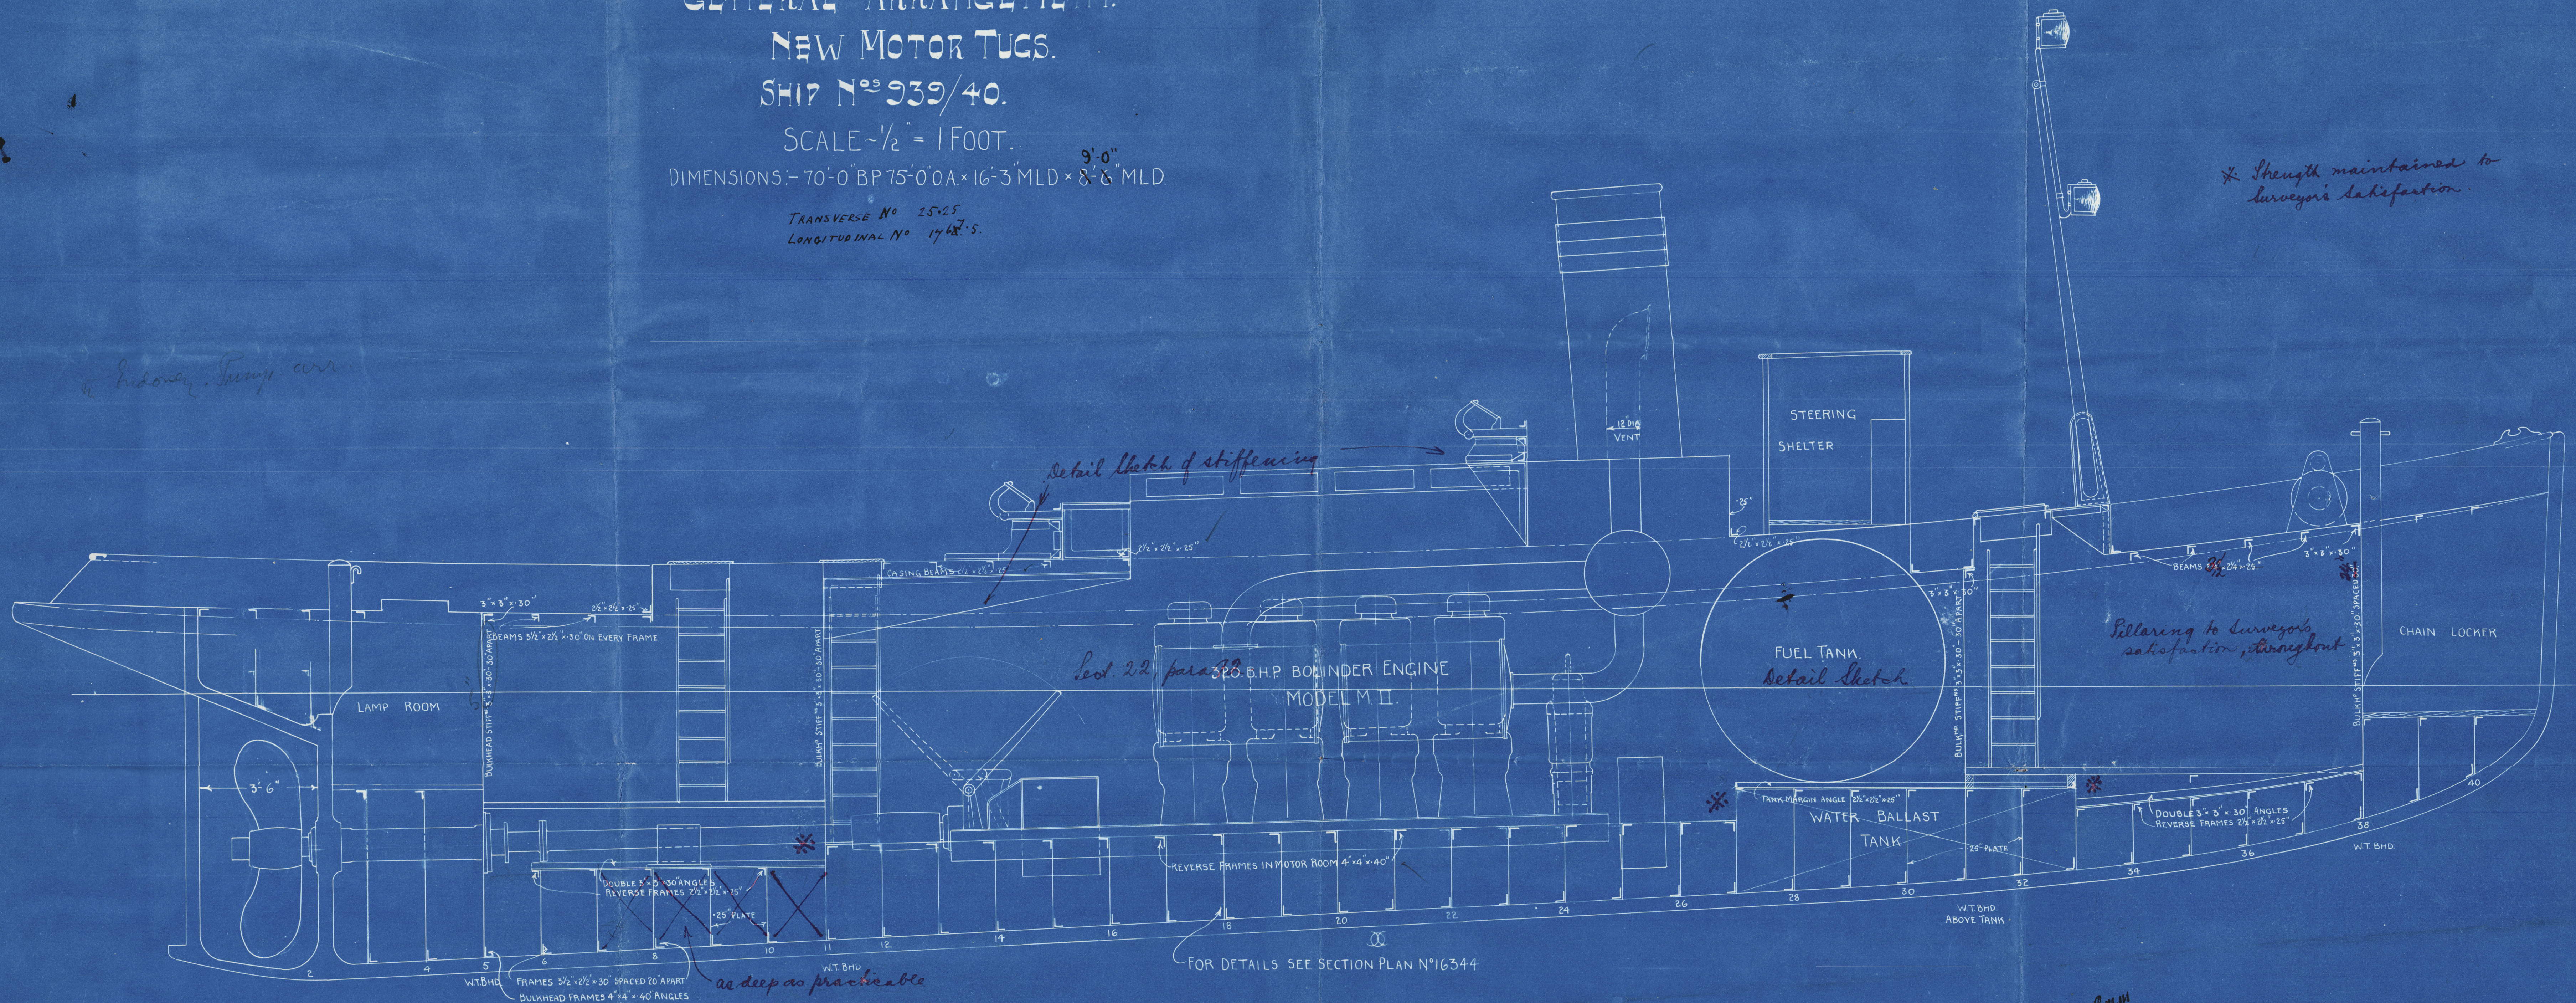

PLAN N^o 16288.
 DRAWN BY J.C.A.
 TRACED BY J.C.A.
 CHECKED BY J.C.A.
 DATE 14.5.50
 JAMES POLLOCK, SONS & CO. LTD.
 SHIPBUILDERS & ENGINEERS
 3 LLOYDS AVENUE
 LONDON E.C.3.

James Pollock & Sons
No 939/CD
Profile & Seal

Office copy
Gen Box 3147
Lloyd

M/V "Hanchford"

James Pollock & Sons No 939.
London Rpt 84545.



© 2020

Lloyd's Register
Foundation

007563-007571-0146