

Lloyd's Register
Foundation

- Profile -

Cochrane & Sons


Selby

- No 401 -

of Peking

Hull Report No. 19758

23-1-07


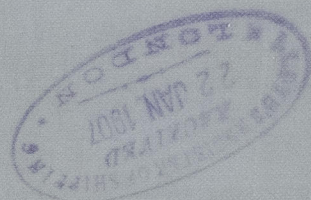


PROFILE

STEEL

DIM 120' 0"

TO SURVEYORS
SATISFACTION.

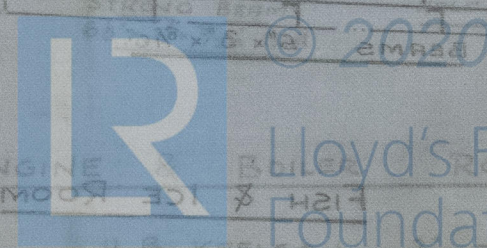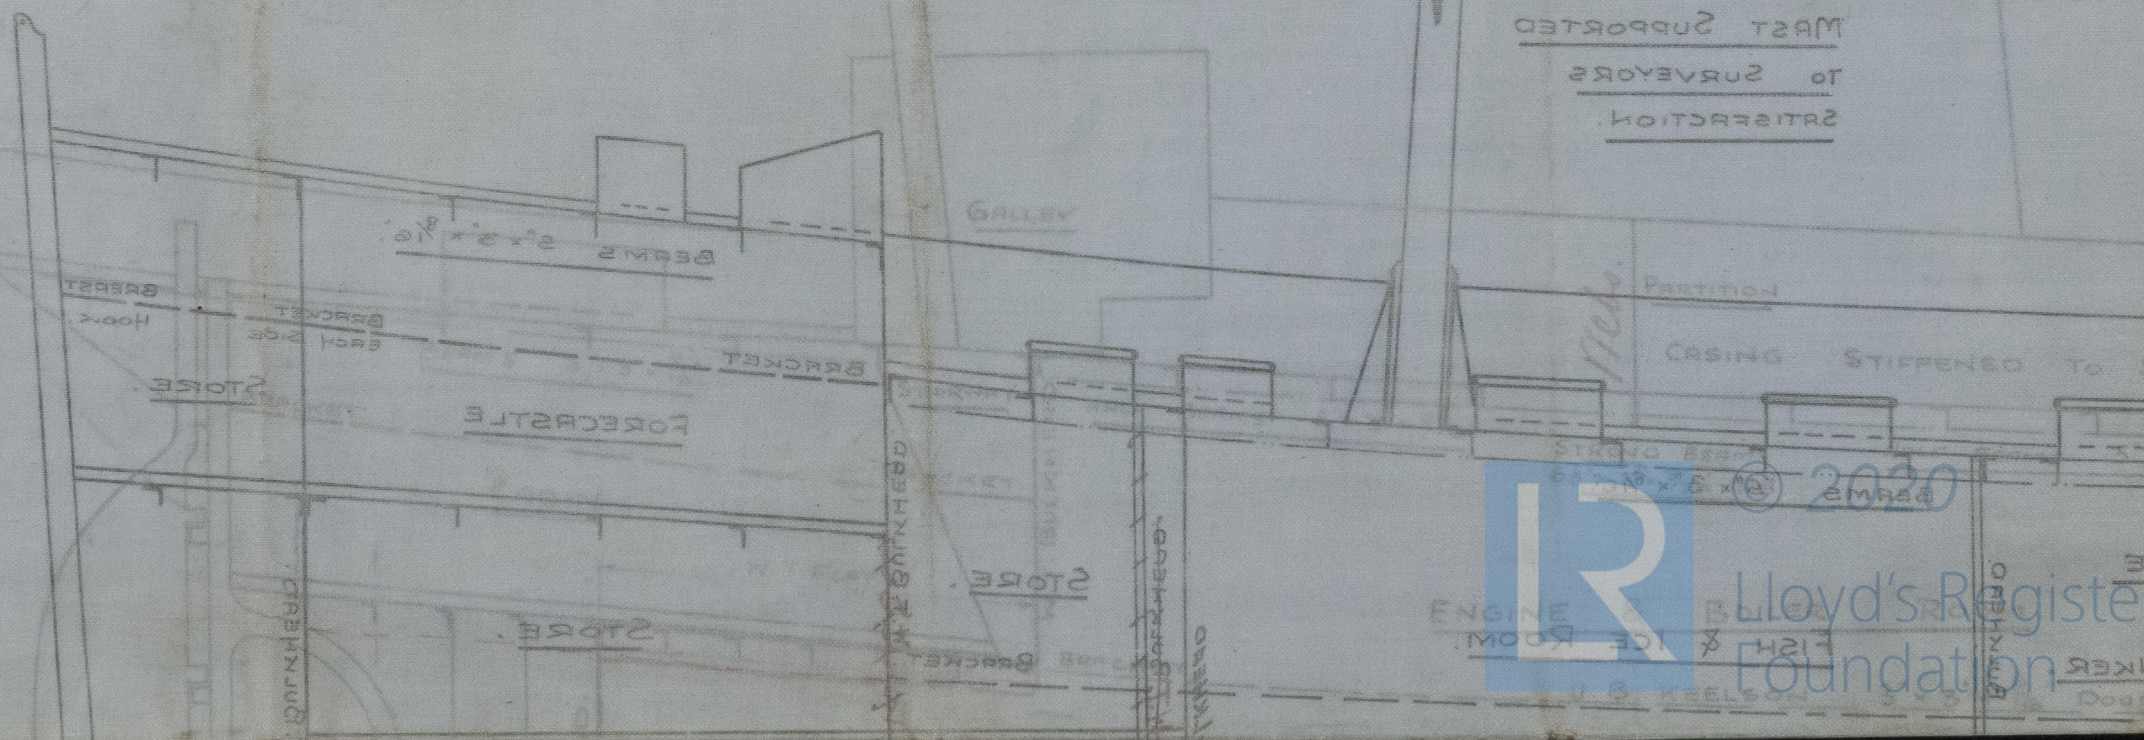

Lloyd's Register
Foundation