



S.S. No 84.  
ELEVATION  
 DIMS: 125'-0" BP x 22'-6" x 12'-6" MLD.  
 SCALE 1/4" = 1 FT.

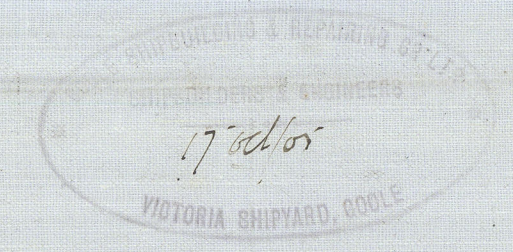

*Handwritten notes in red and black ink:*  
 16 ft 4 in  
 21.10.05

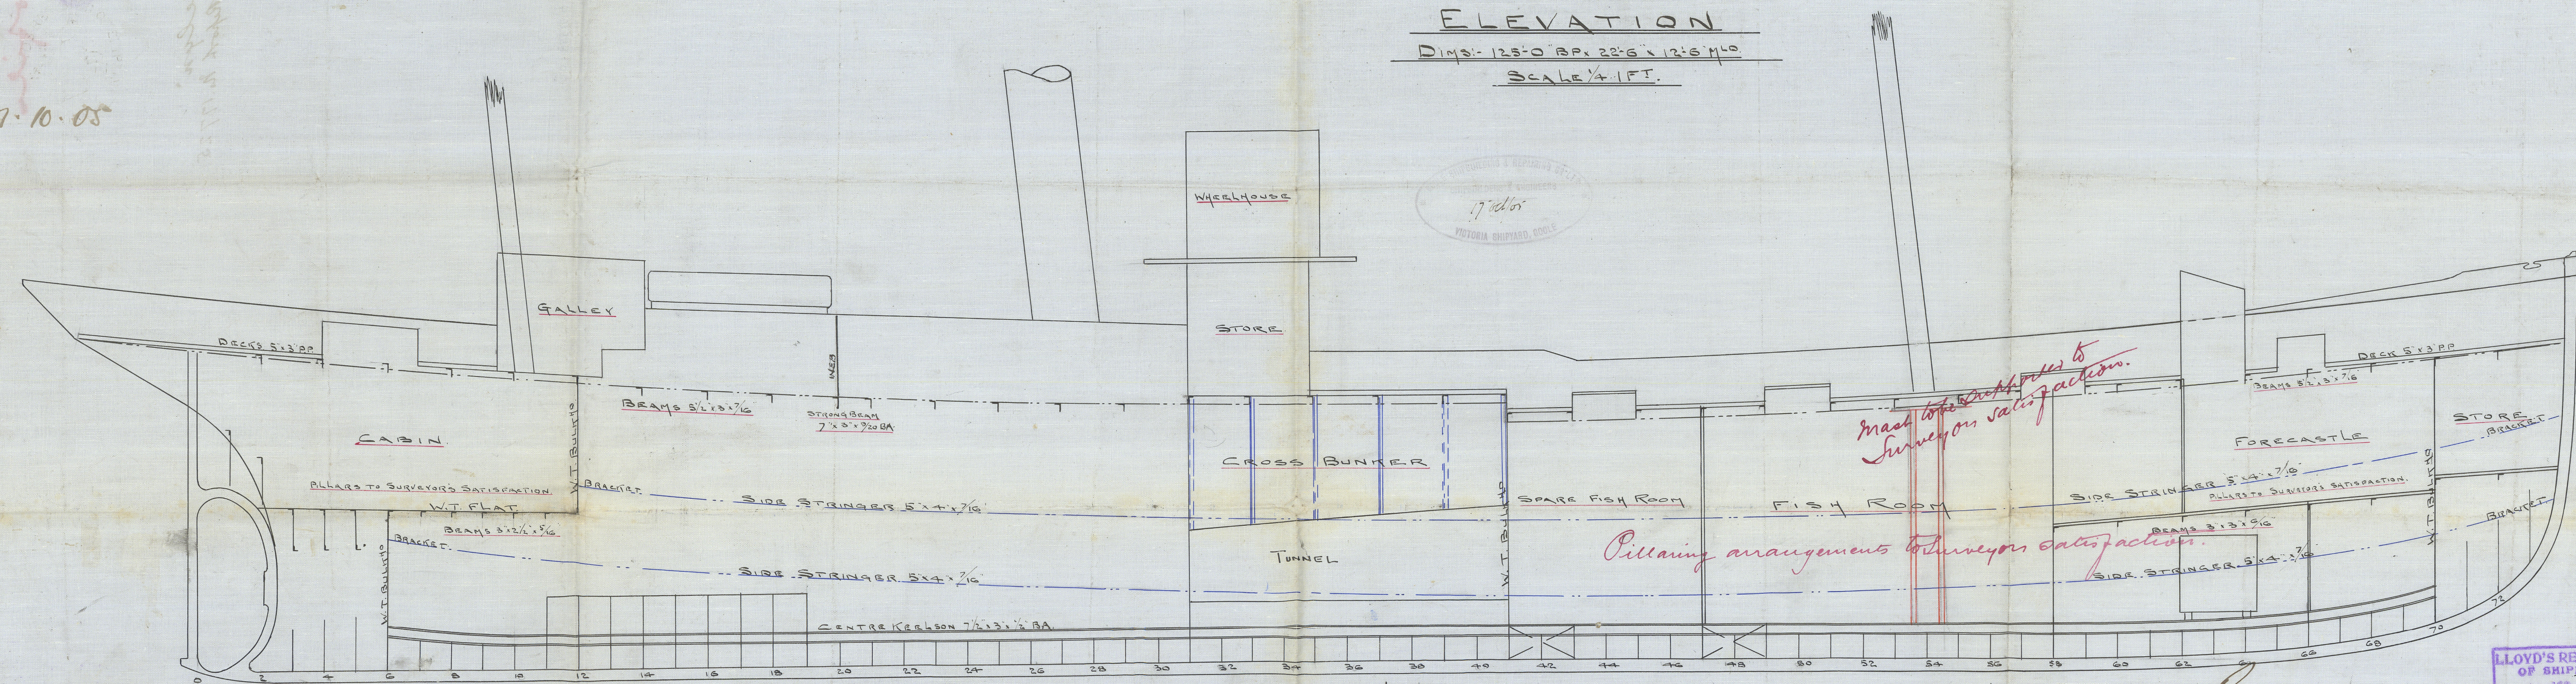

*Handwritten in red:*  
 Mast to be cut off to Surveyor's satisfaction.

*Handwritten in red:*  
 Pillaring arrangements to Surveyor's satisfaction.

*Handwritten signature and date:*  
 C.B.  
 20.10.05.

LLOYD'S REGISTER  
 OF SHIPPING.  
 18 OCT 1905  
 1012020

Lloyd's Register  
 Foundation  
 007572-007589-0195



Wool S.R.C.

No 84.

Profile



of Evelyn

Hull Report No. 17725



© 2020

Lloyd's Register  
Foundation

007572-007589-0195