

# 'Foam' & 'Fogbreak' Nos 445 & 6 MIDSHIP SECTION.

SHewing Modifications Required To Equip  
VESSEL READY TO PURSUE HER NORMAL TRADE,  
AS AN ENGLISH FISHING DRIFTER.

STEEL SCREW DRIFTER.

"OCEAN" CLASS.


CLASS B.S. " STEAM DRIFTER.

DIMENSIONS.

LENGTH BETWEEN PERPS 86'-0" TRANSVERSE N° (B+D) =  
BREADTH MOULDED 18'-6" 18'-5" + 10'-0" 28'-5"  
DEPTH MOULDED 10'-0" LONGITUDINAL N° (B+D) x L  
" TOP OF FLOOR TO DECK AT SIDES 10' 28' x 5' 86' = 2451.  
 $\frac{L}{B} = 4.6$   $\frac{L}{D} = 8.6$

EQUIPMENT.

1 ANCHOR EX STOCK 5 1/2 C. 1 ANCHOR EX STOCK 2 C.  
1 ANCHOR " " 2 1/2 C. 60 FATHOMS 3/4 CHAIN (STUD).  
TO BE SUPPLIED BY ADMIRALTY.  
60 FATHOMS 5 1/2 HAWSER 60 FATHOMS 3 WARP.

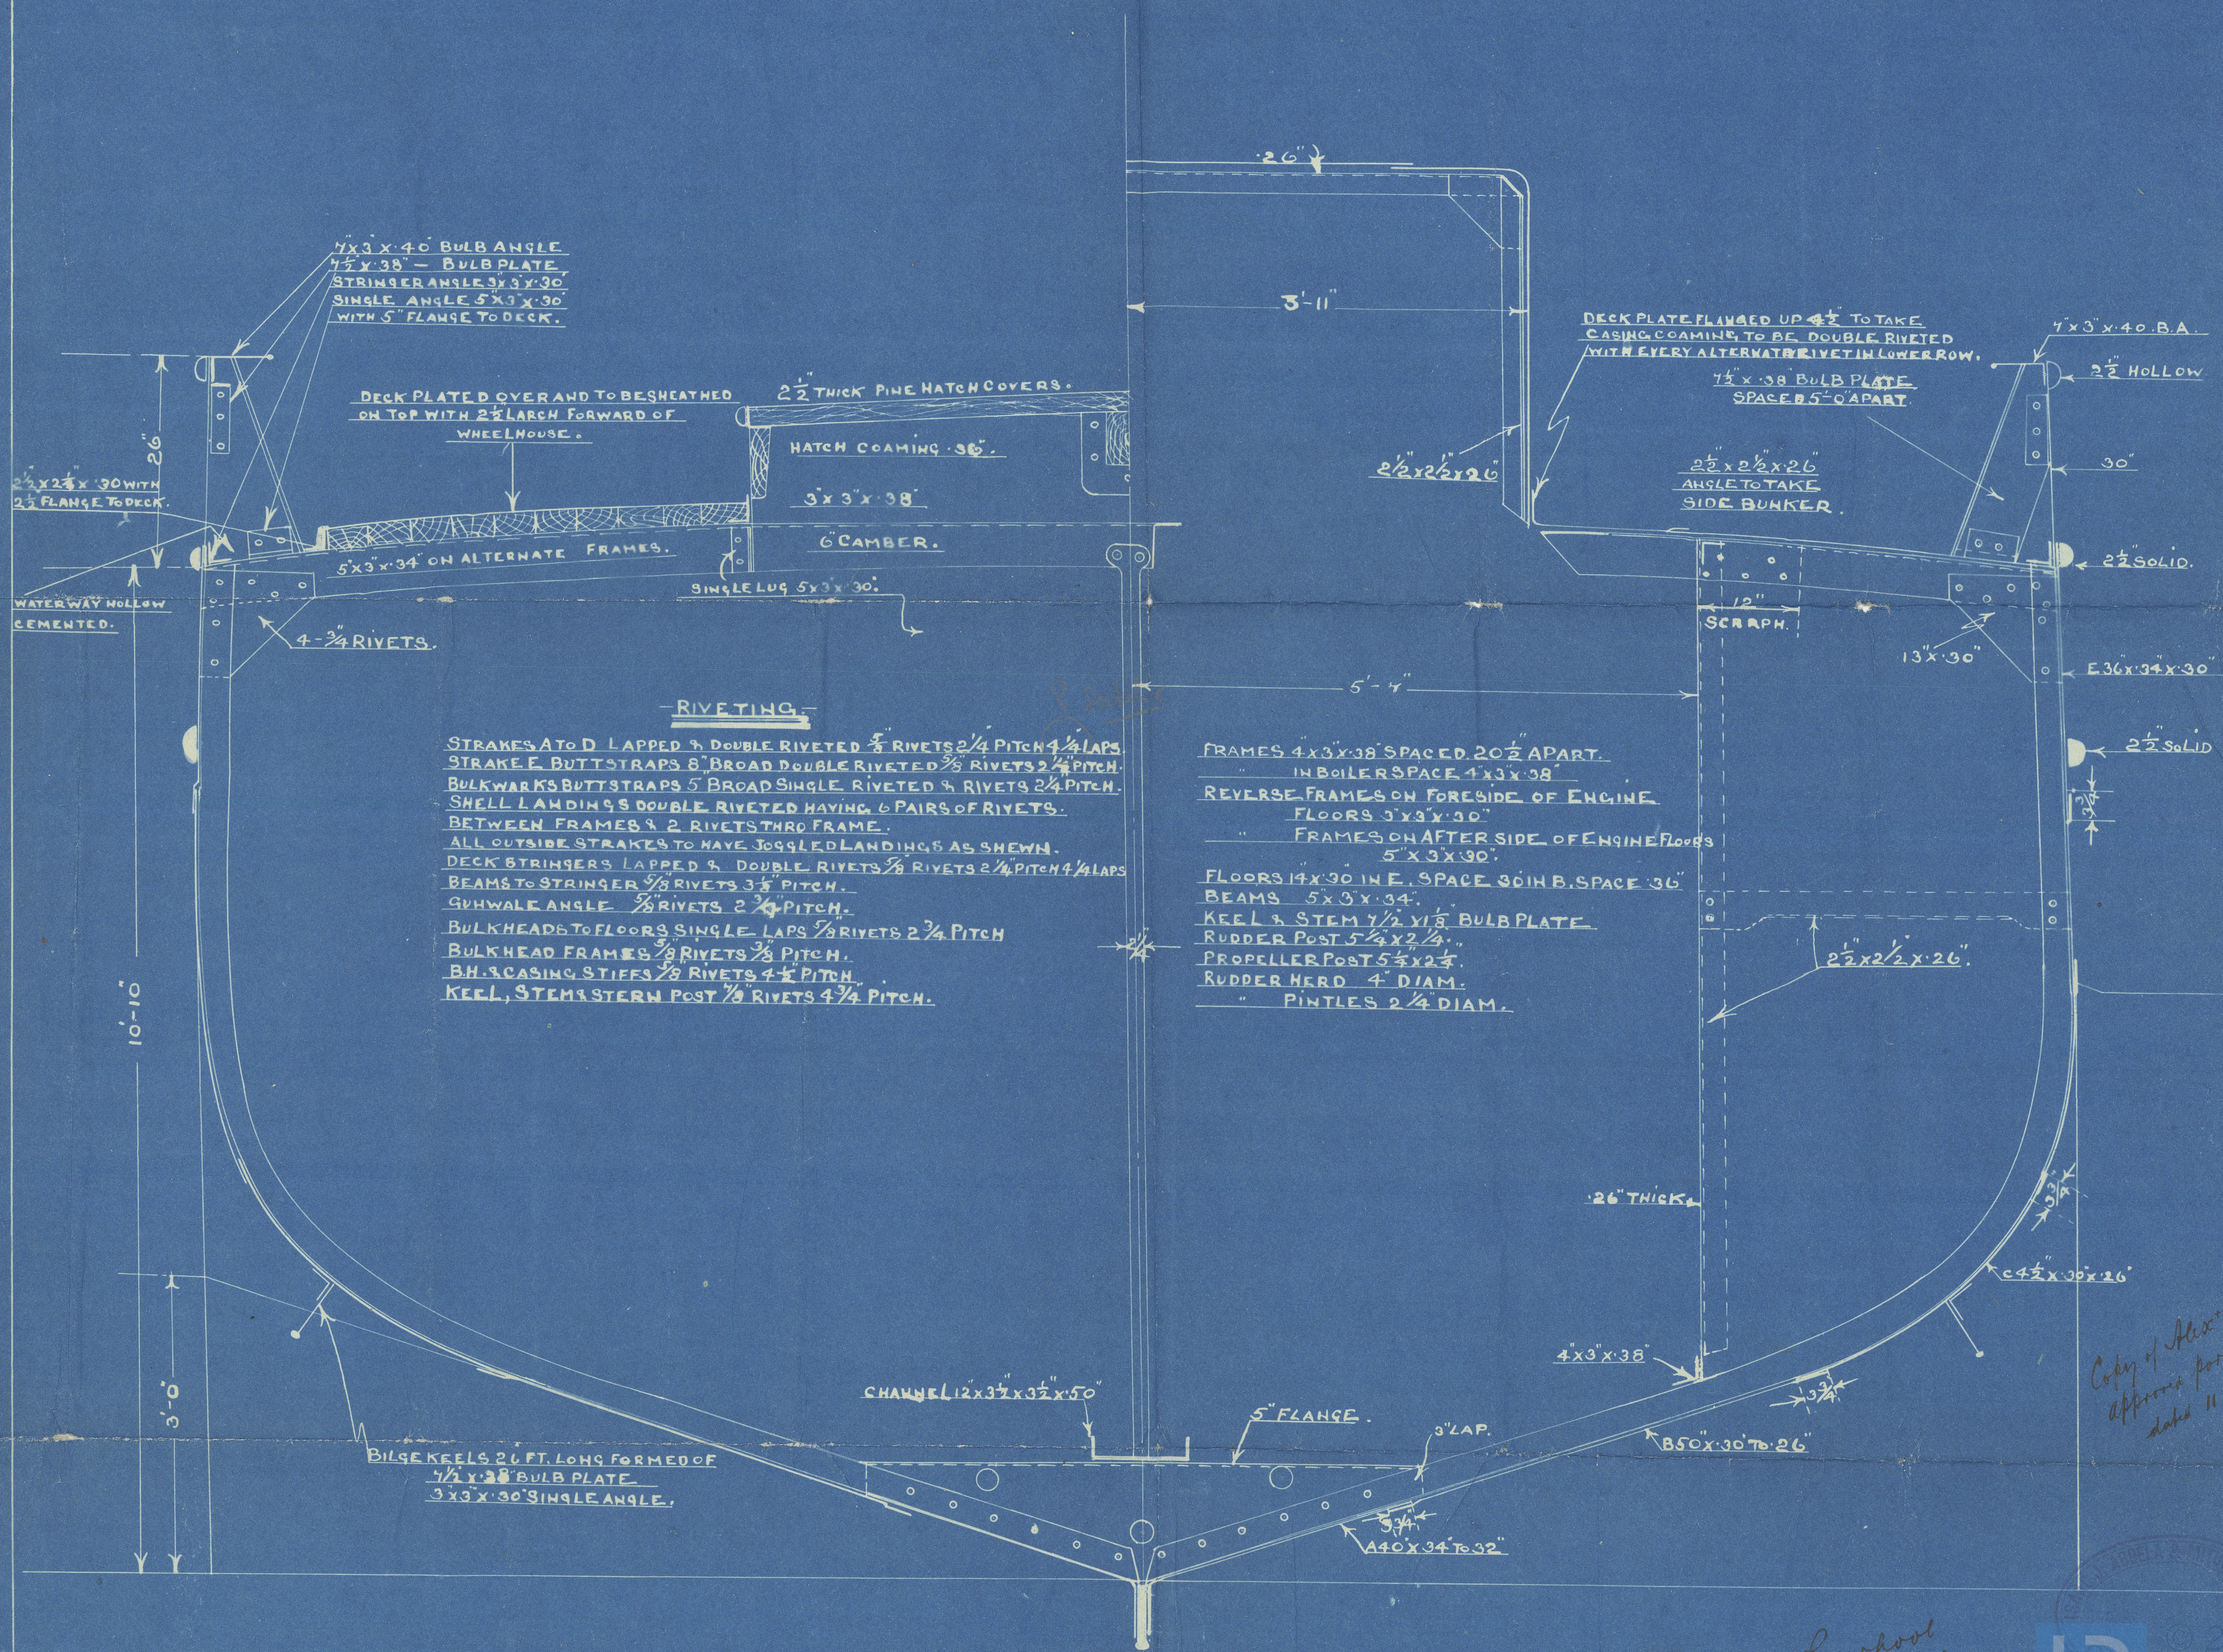



Messrs. Abdela & Mitchell & Co.  
Queensferry.

Midship Section

Steel Screw Drifters

Nos. 445 & 46.

'Foam' & 'Fogbreak'

19. 10. 20

S.S. "Foam"

LIVERPOOL

Report No. 81376

S.S. "Fogbreak"

LIVERPOOL

Report No. 81745

Lloyd's Register  
Foundation