


11.6.09
30.6.09
2.7.09.

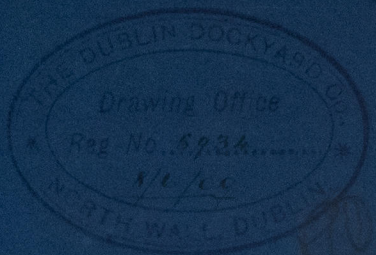

MIDSHIP SECTION.

— T.S.T. N°68. —


DIMENSIONS - 105'-0" B.P. x 22'6" B.M. x 11'-0" D.M.L.D.

SCALE 1/2" = ONE FOOT.

To class A.1. at Lloyds for River and Towing Purposes.

Equipment.

- 2 Bower Anchors 54 cwt each stockless
- 120 Fathoms short round link chain
- on 15 fathom lengths with shackles
- 2 - 6 inch manilla ropes each 25 fathoms long
- 2 - 5 "
- 2 heaving lines (Carotte pumps)
- 1 Lead line.



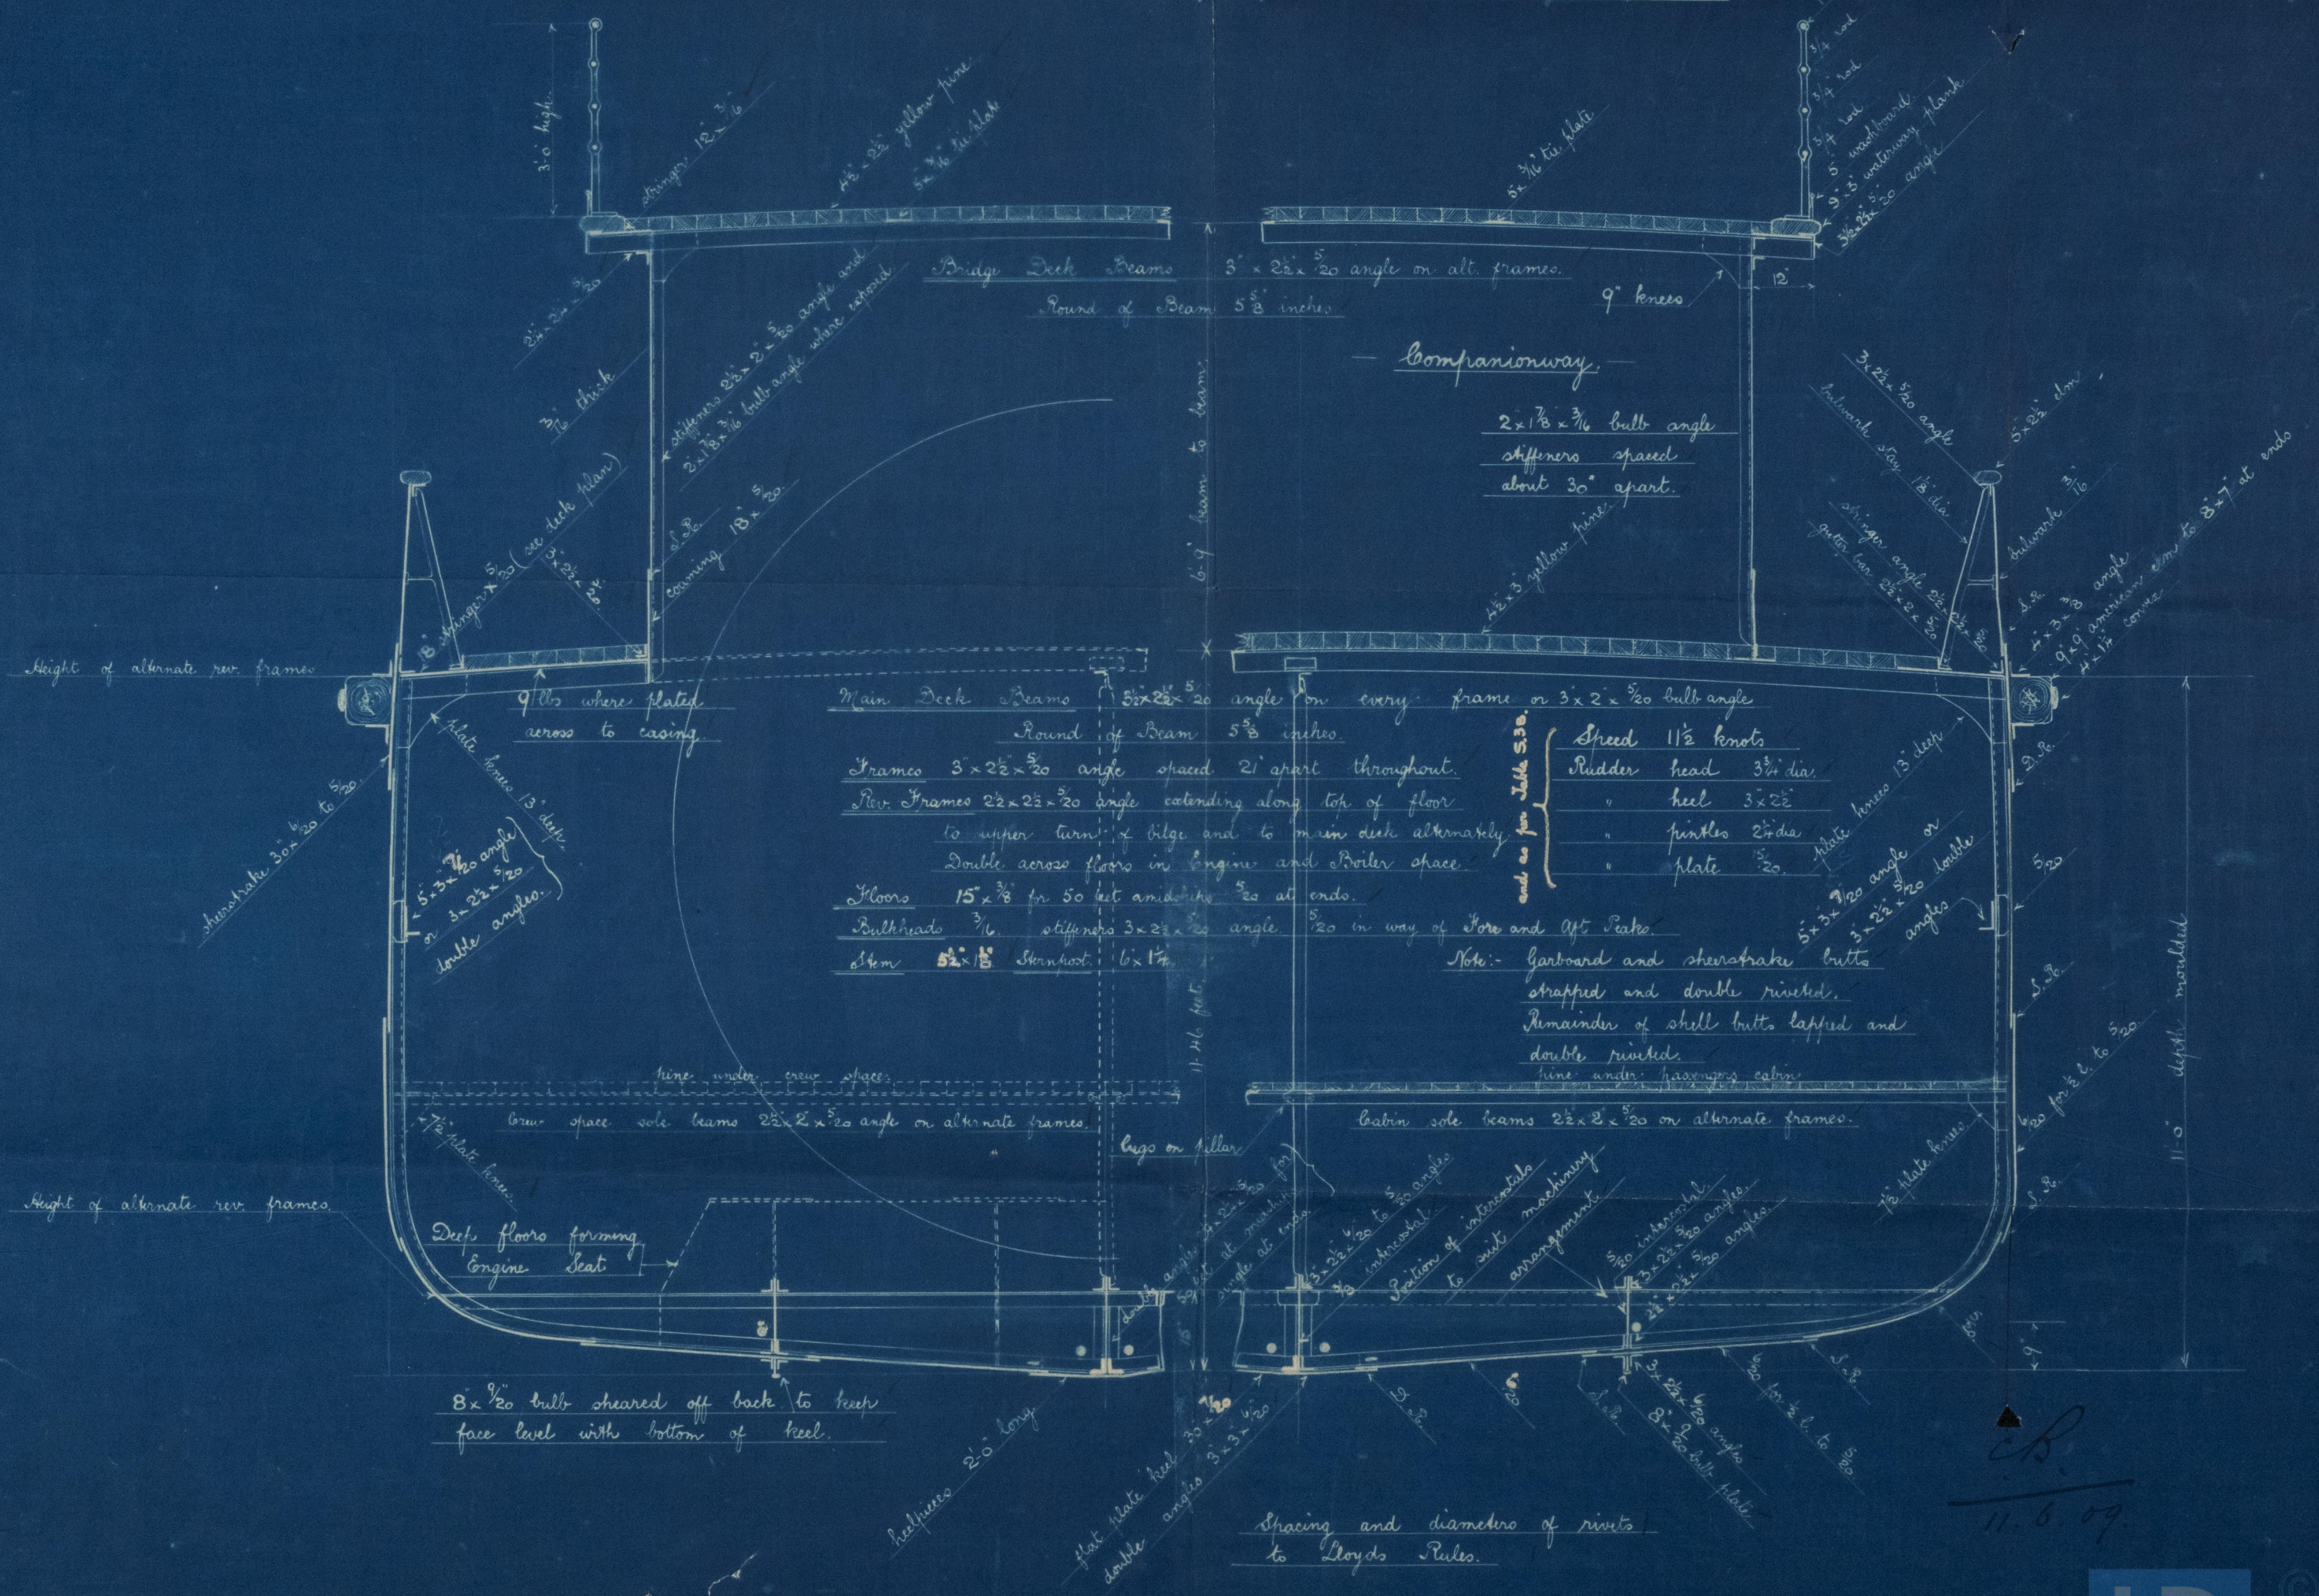


© 2020

Lloyd's Register
Foundation

Midship Section
68.

"Lord Stalbridge"
Dublin Report 2895.
Gmu

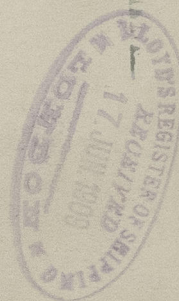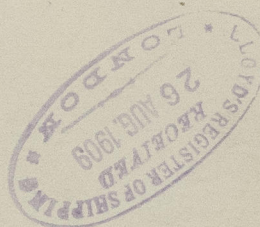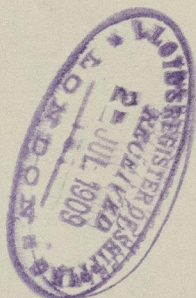

28/10/09.

© 2020

Lloyd's Register
Foundation

007590-007607-0228