



S. S. No 1283.
PROFILE & DECK.

SCALE: 1/8"=1 FOOT.


DIMENSIONS: 335'-0" B.P. x 47'-6" B.M. x 26'-3" D.M.

TO CLASS LLOYDS 100 A.I. WITH FREEBOARD, DRAFT 19'-10" M.P.
& BRITISH CORPORATION B.S. & B.O.T. FOR PASSAGE VESSELS.

DETAIL PLAN OF HATCH END BEAMS TO BE SUBMITTED.

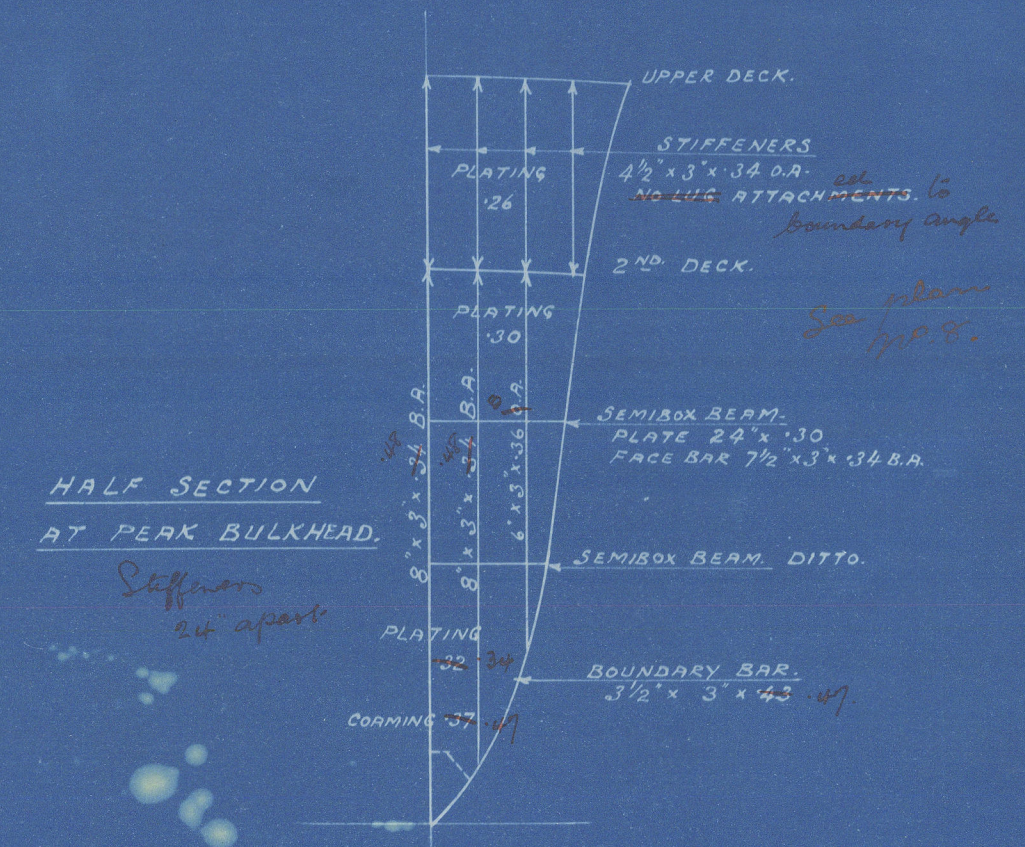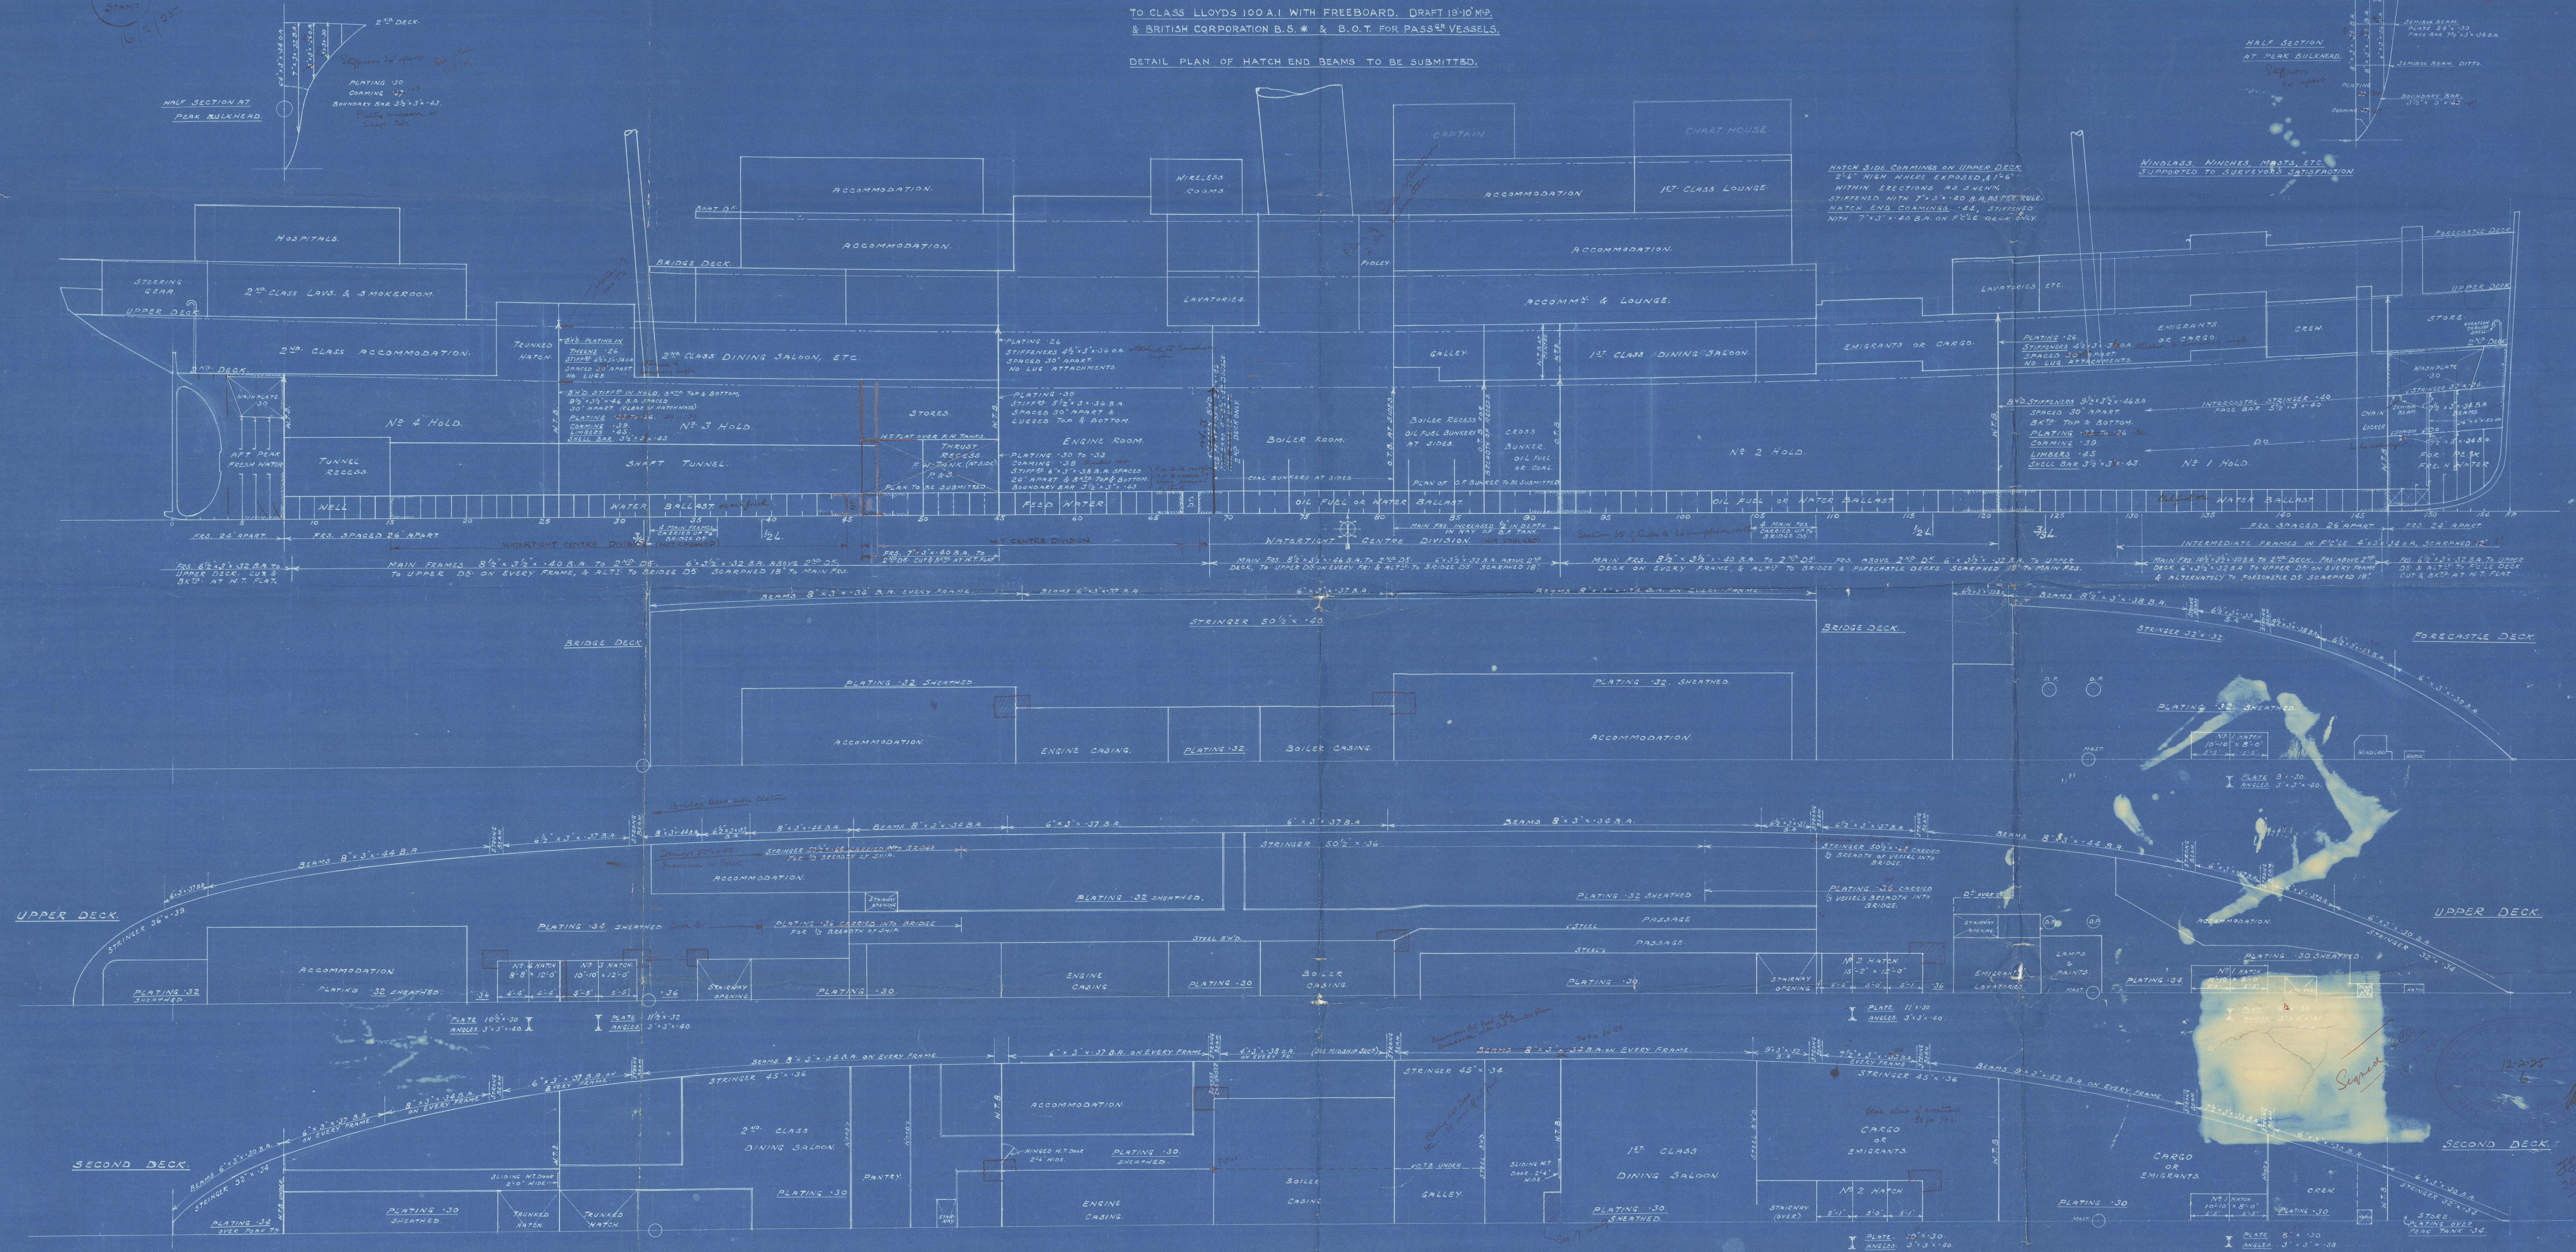

HALF SECTION AT PEAK BULKHEAD

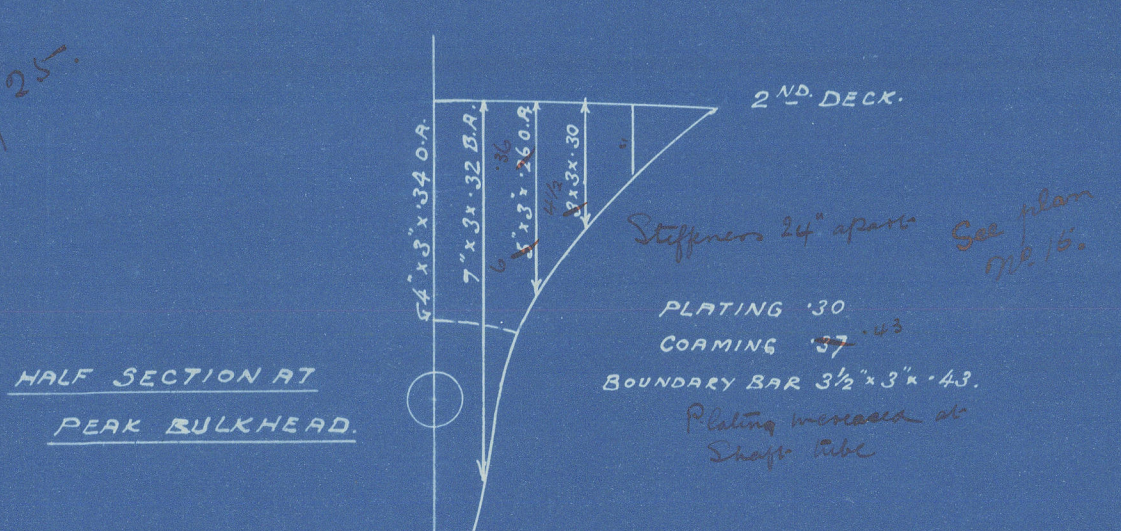

HALF SECTION AT PEAK BULKHEAD

12-25
100
338
20-10-20

(2)

Swan & Hunter.

No. 1283.

Profile & Deck,

"Patricia"

ex.

S. S. PATRIS. II
NEWCASTLE ON TYNE.

Report No. 80084.




© 2021

Lloyd's Register
Foundation

007608-007619-0190

130
195

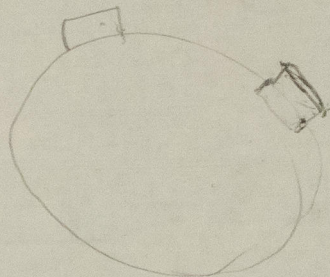

© 2021

Lloyd's Register
Foundation