


# D. N. 499.

## PROFILE & DECK PLANS.




SCALE  $\frac{1}{8}$  INCH TO ONE FOOT.

CANT FRAME 42"x30" A. SPACED  
24" APART AT KNUCKLE.  
CANT BEAM 32"x30" TO ALTERNATE FRAME.

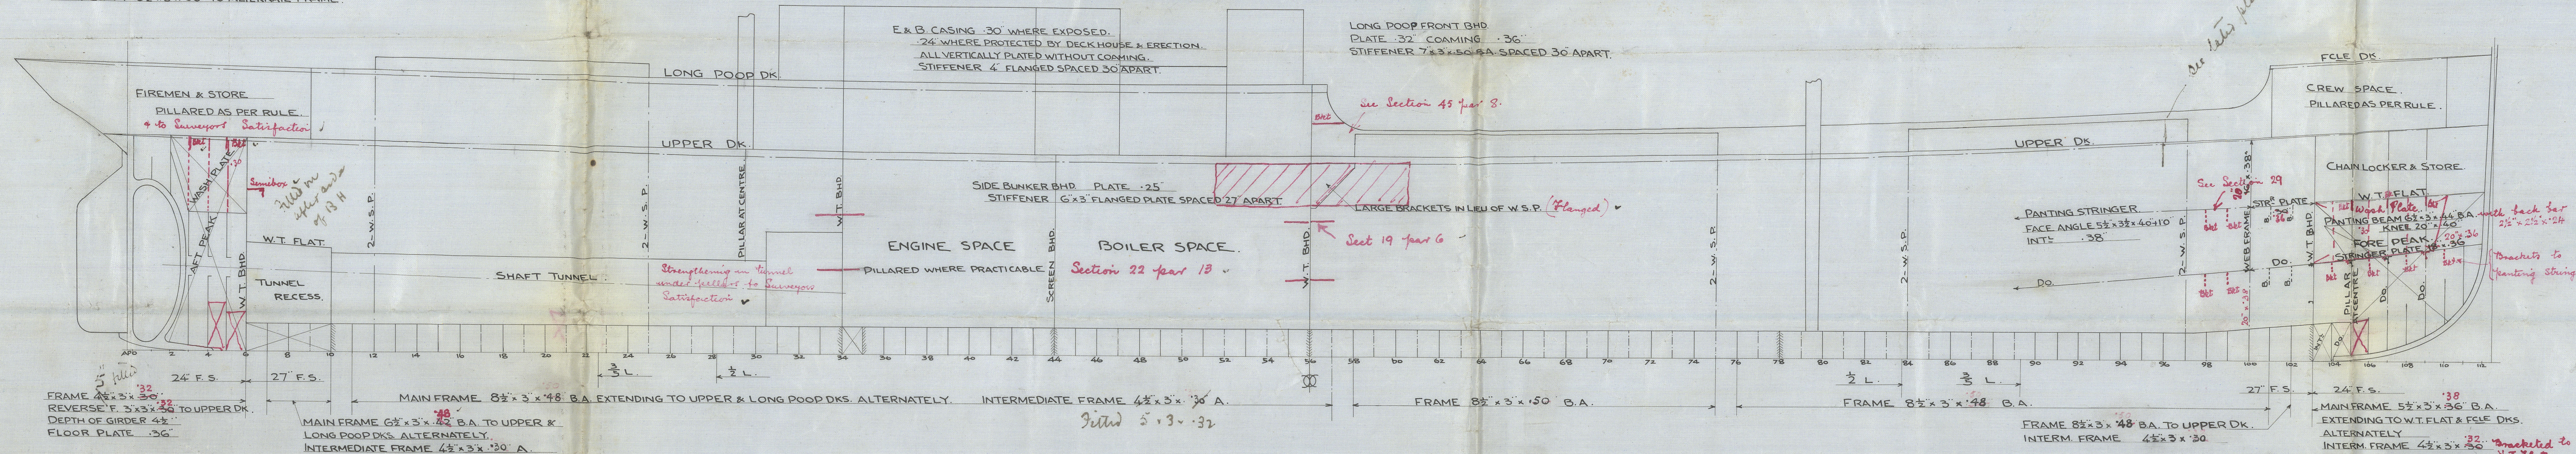



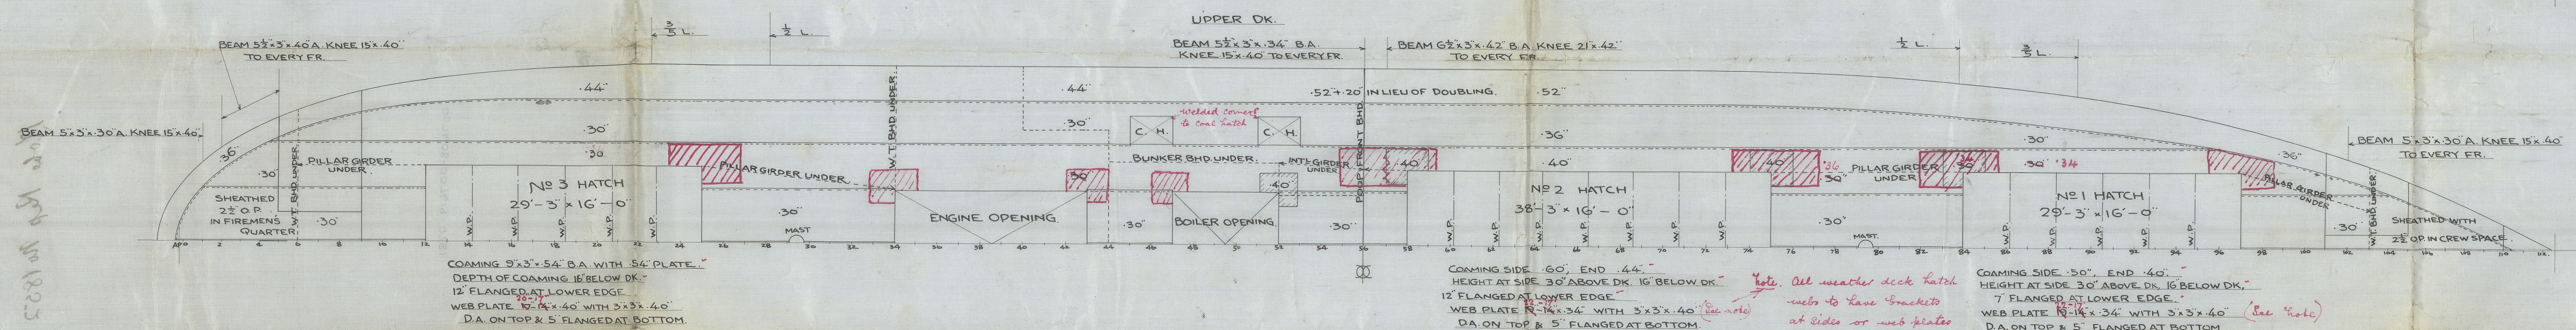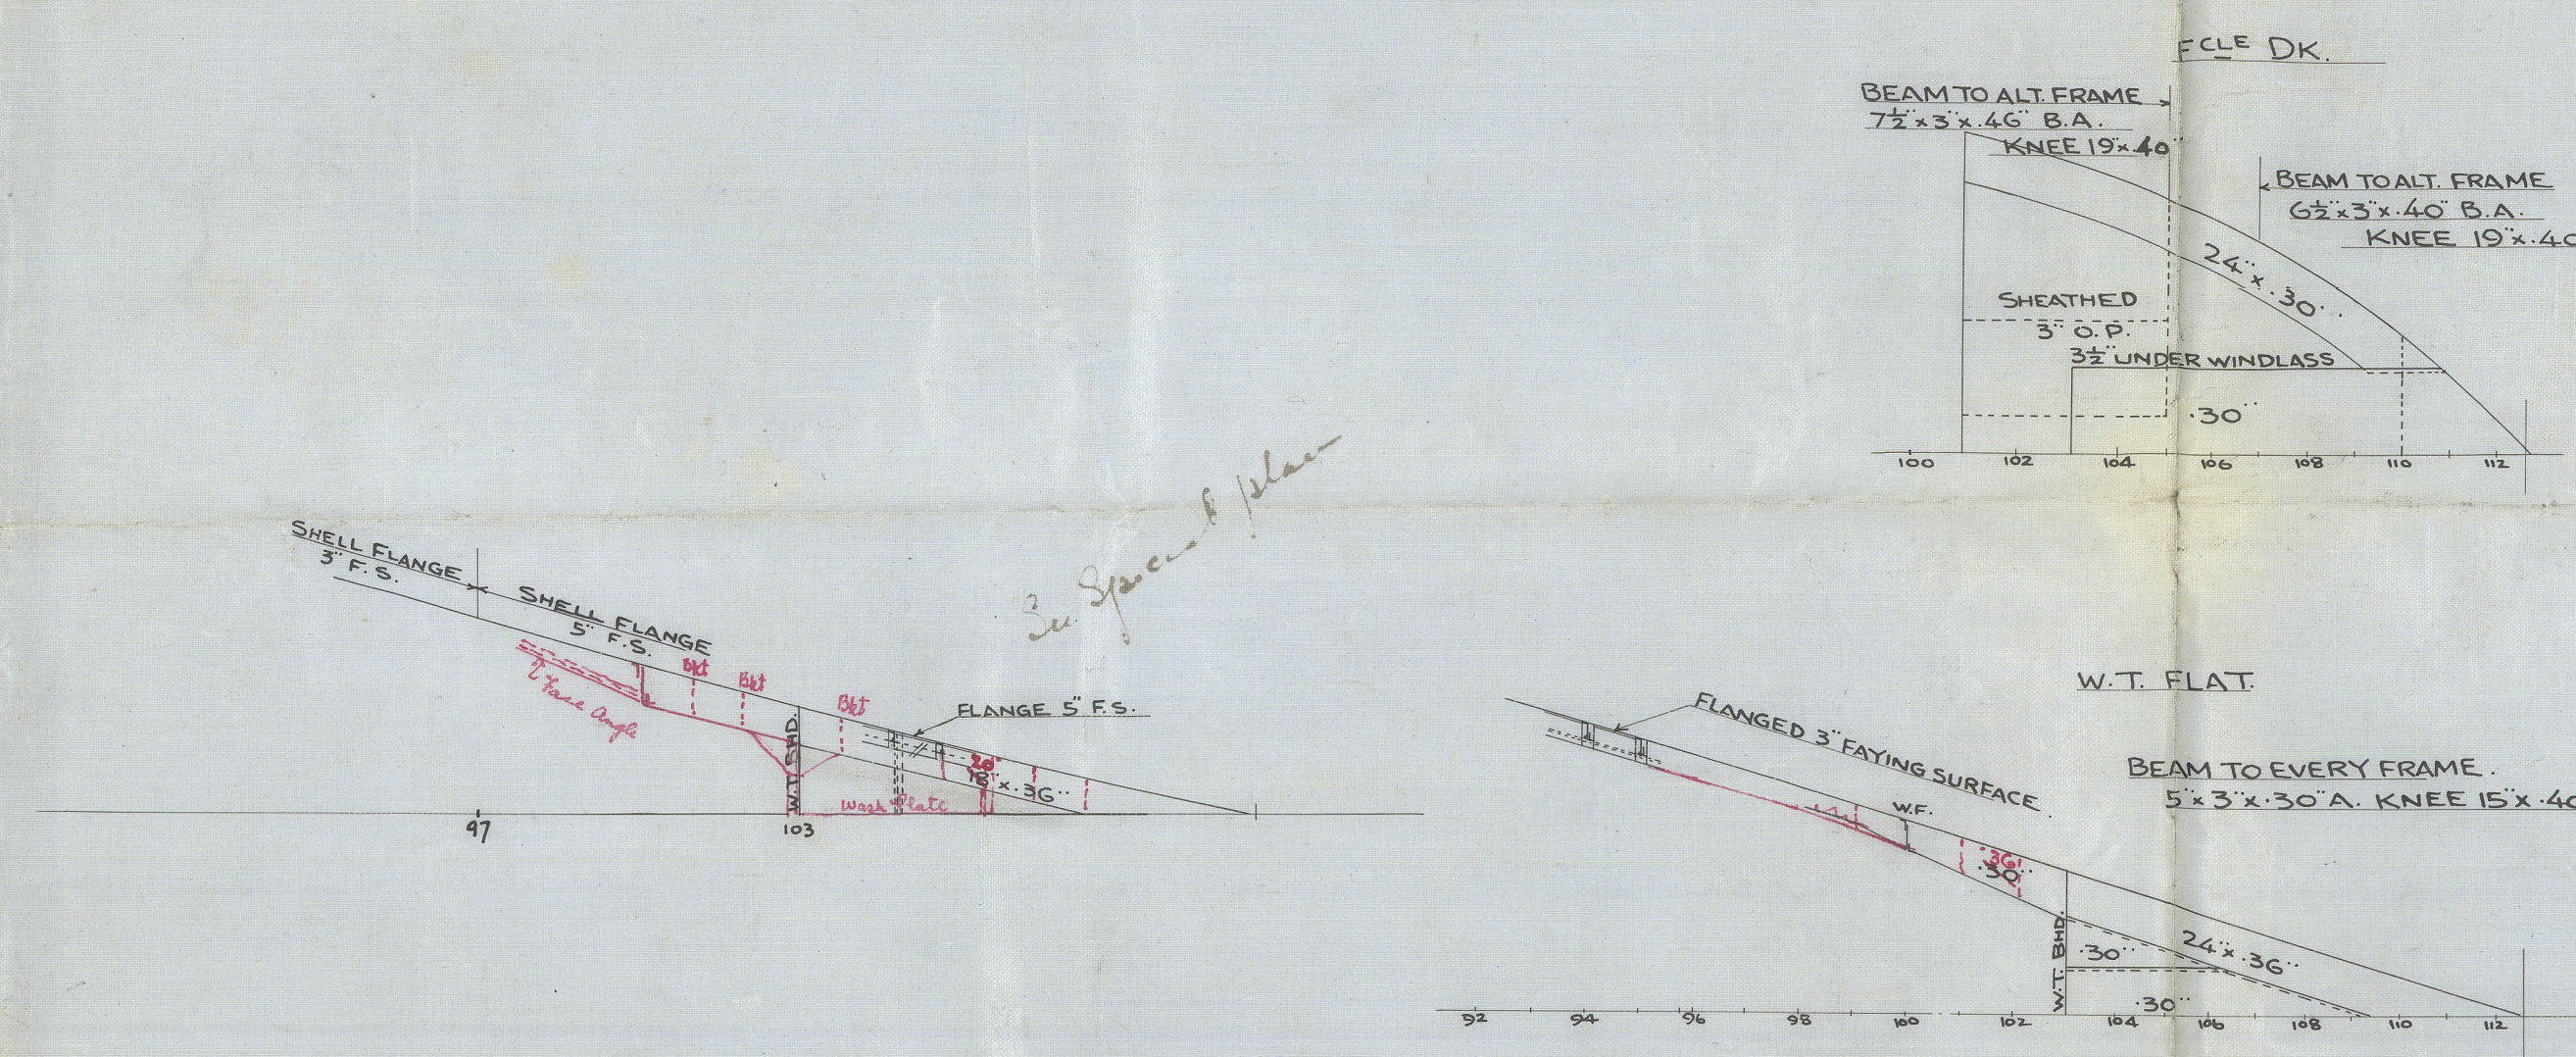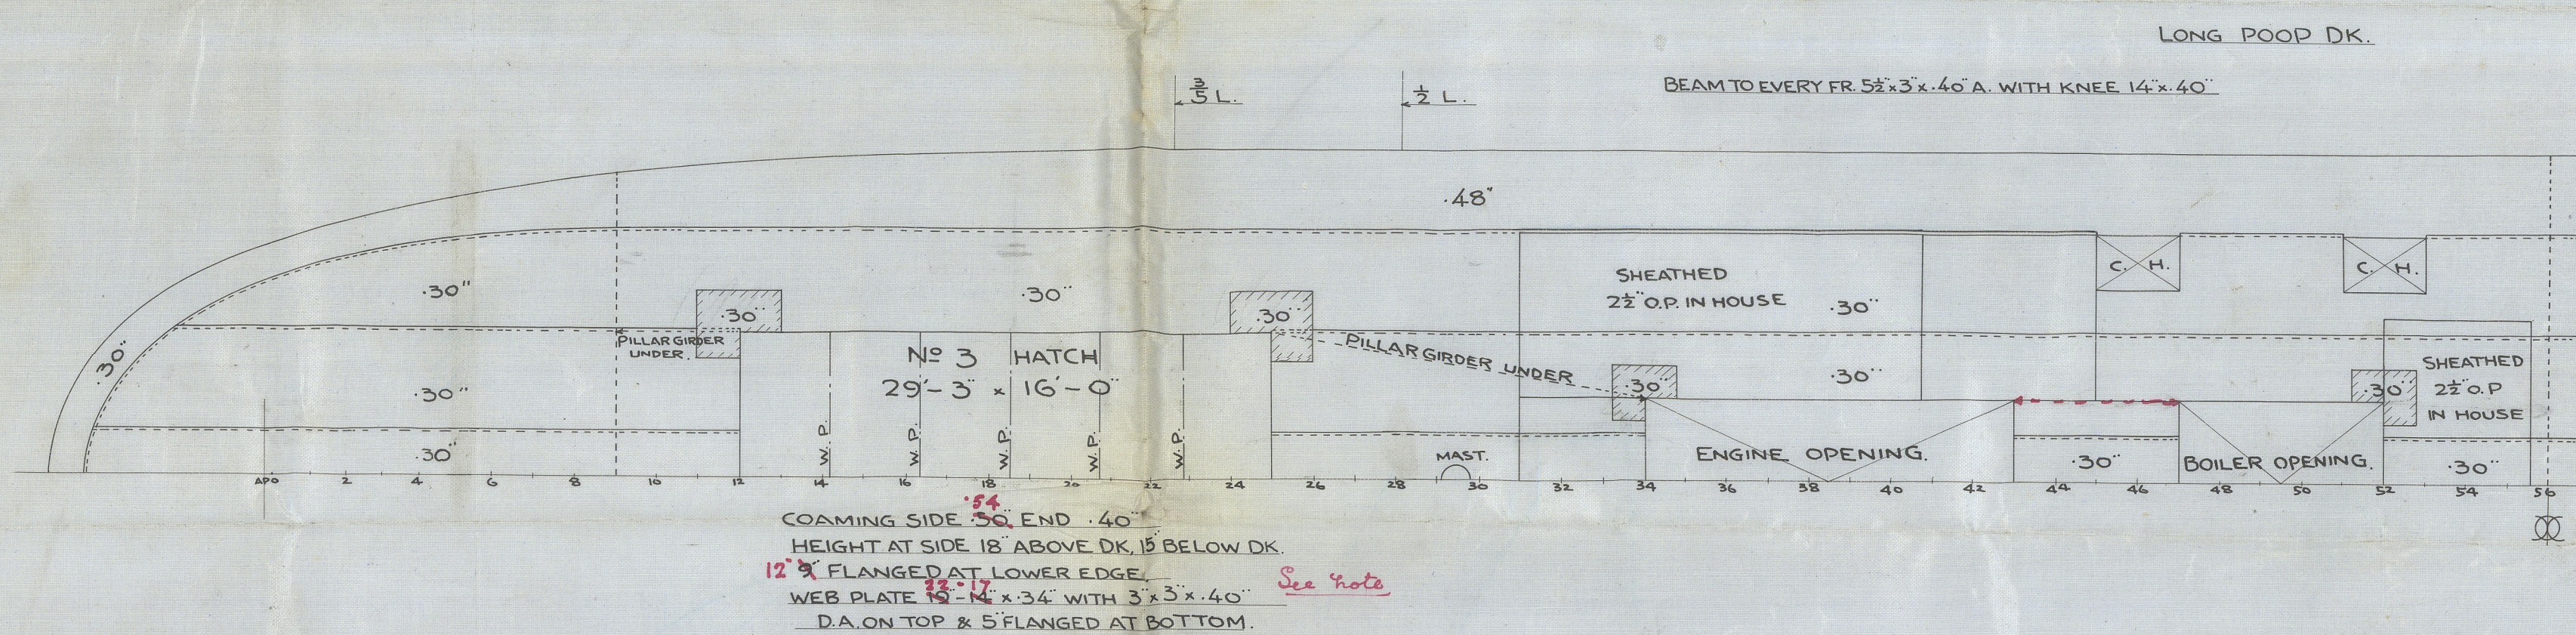

MITSUBISHI  
DOCK YARD & ENGINE WORKS  
NAGASAKI

DRAWN BY: [Signature]  
TRACED BY: [Signature]  
CHECKED BY: [Signature]  
APPROVED BY: [Signature]  
DRAWING OFFICE NO.: [Blank]  
DATE: [Blank]

22.3.15

2.2.15





Profile  
D<sup>n</sup> N<sup>o</sup> 499  
Nagasaki

No 6 MB Gard No 63

S. S. Katsuno.

Maru

Yoko Rep No 1852

007608-007619-0281

DONOR: GILBERT S. B.  

© 2021

Lloyd's Register  
Foundation