





[illegible]

"J. S. Watson
 1882
 [] []

NOTE :- NUMBERS IN LARGE LETTER CORRESPOND TO NO OF PARA. IN ANNEXED SHEET.

(2 a.)

(2 b.)

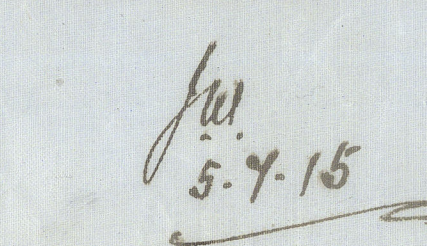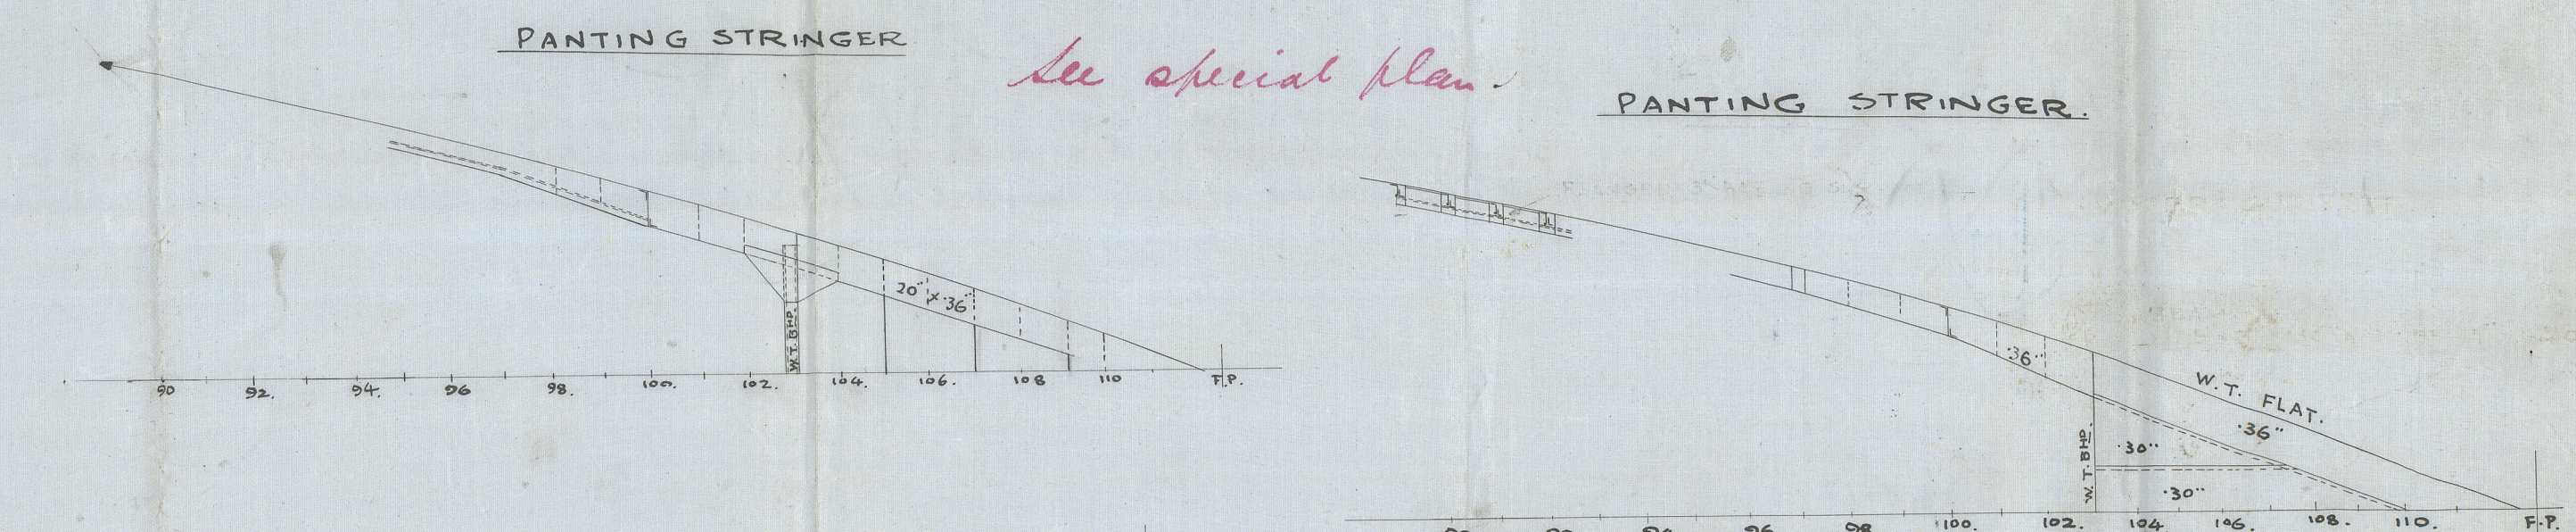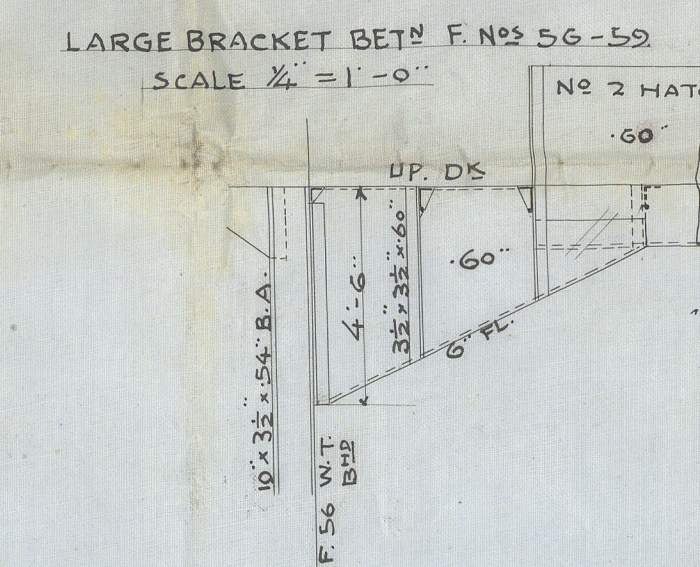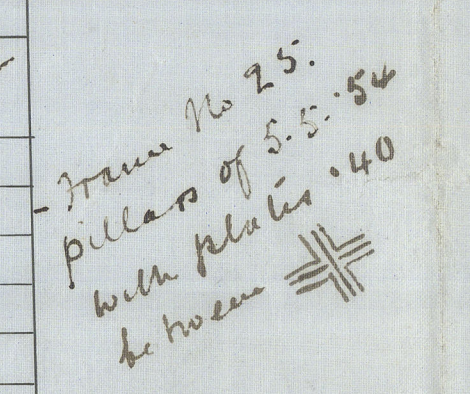

(1)

Mitsui Bishi. Kobe

No 63 1/2 (Design 499)
Nagasaki

Profile & Deck

Kobe let. 29.5.15

S. S. Katsura Maru

• Kobe Rep No 1852



© 2021

Lloyd's Register
Foundation

007608-007619-0282