

27.5.15


PROFILE AND DECK PLANS.

T. S. S. No 377.






DIMS: 350'-0" x 49'-9" x 27'-3"


SCALE 1/8" = 1 FOOT.

Figures in black as filled.

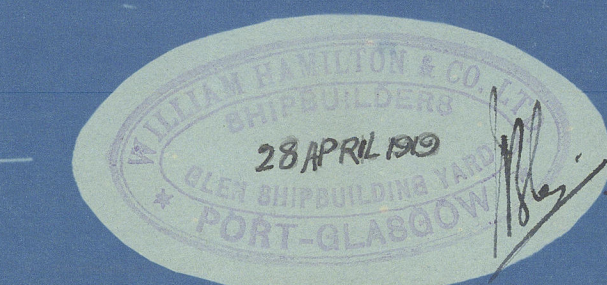


Note Where long B.A. stiffens on hatch coaming as omitted, vertical angles to be filled as shown 6x6 deck angles at corners of openings on upper deck

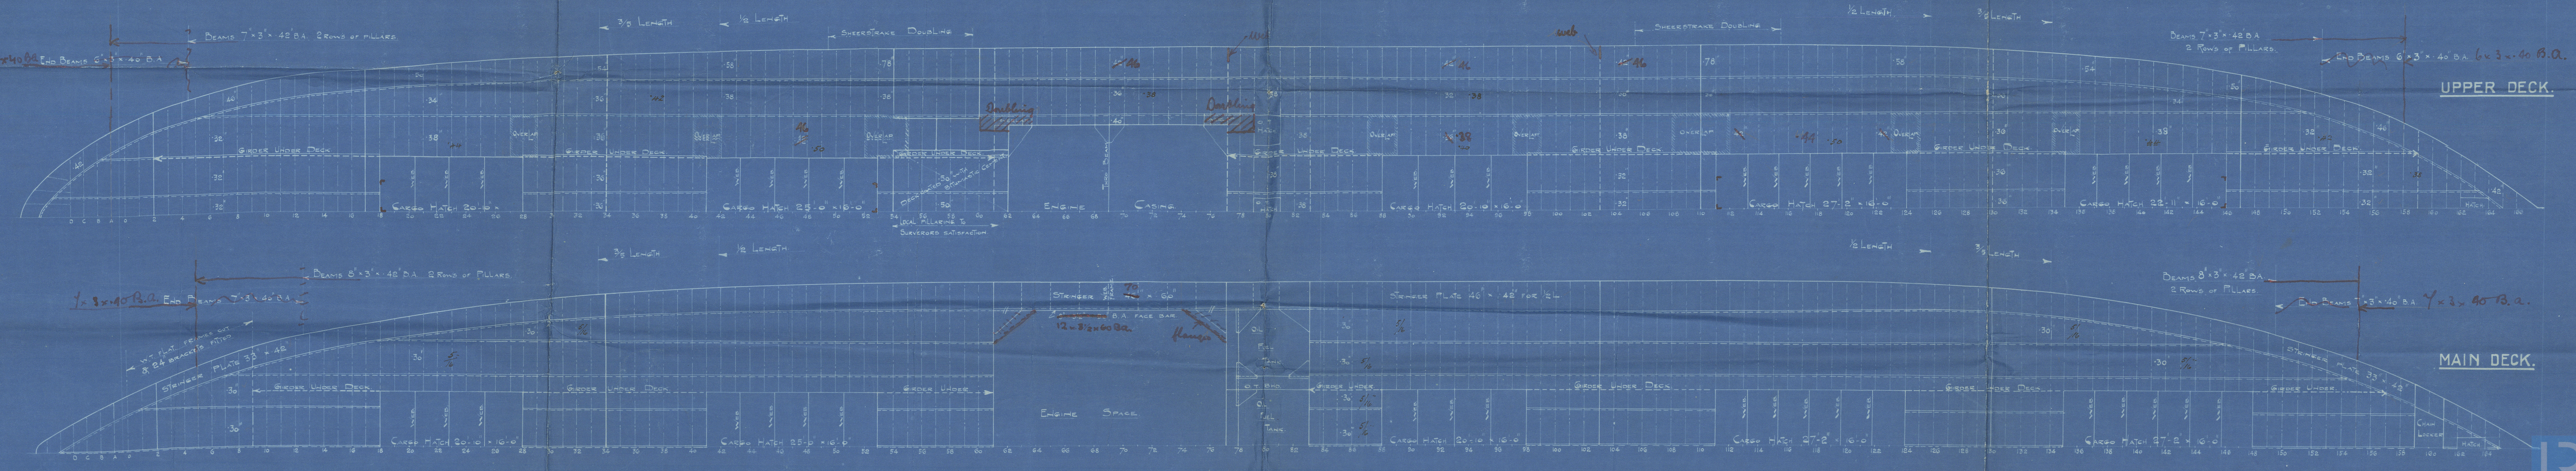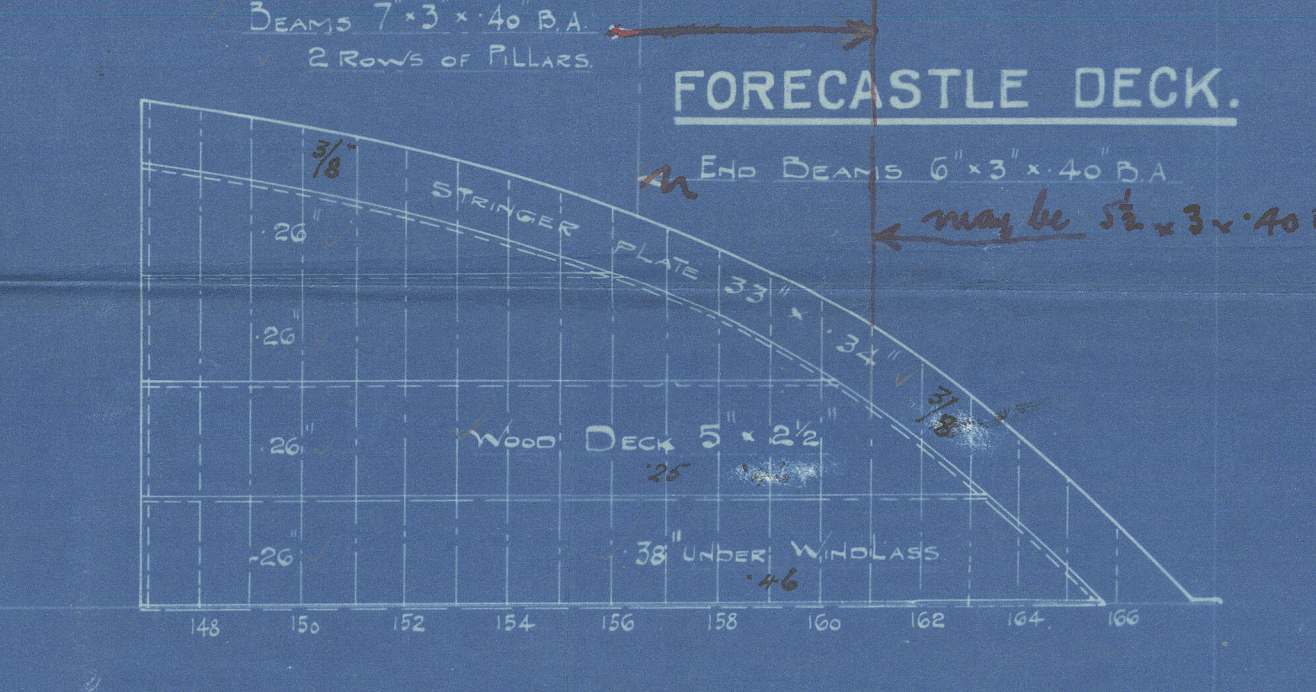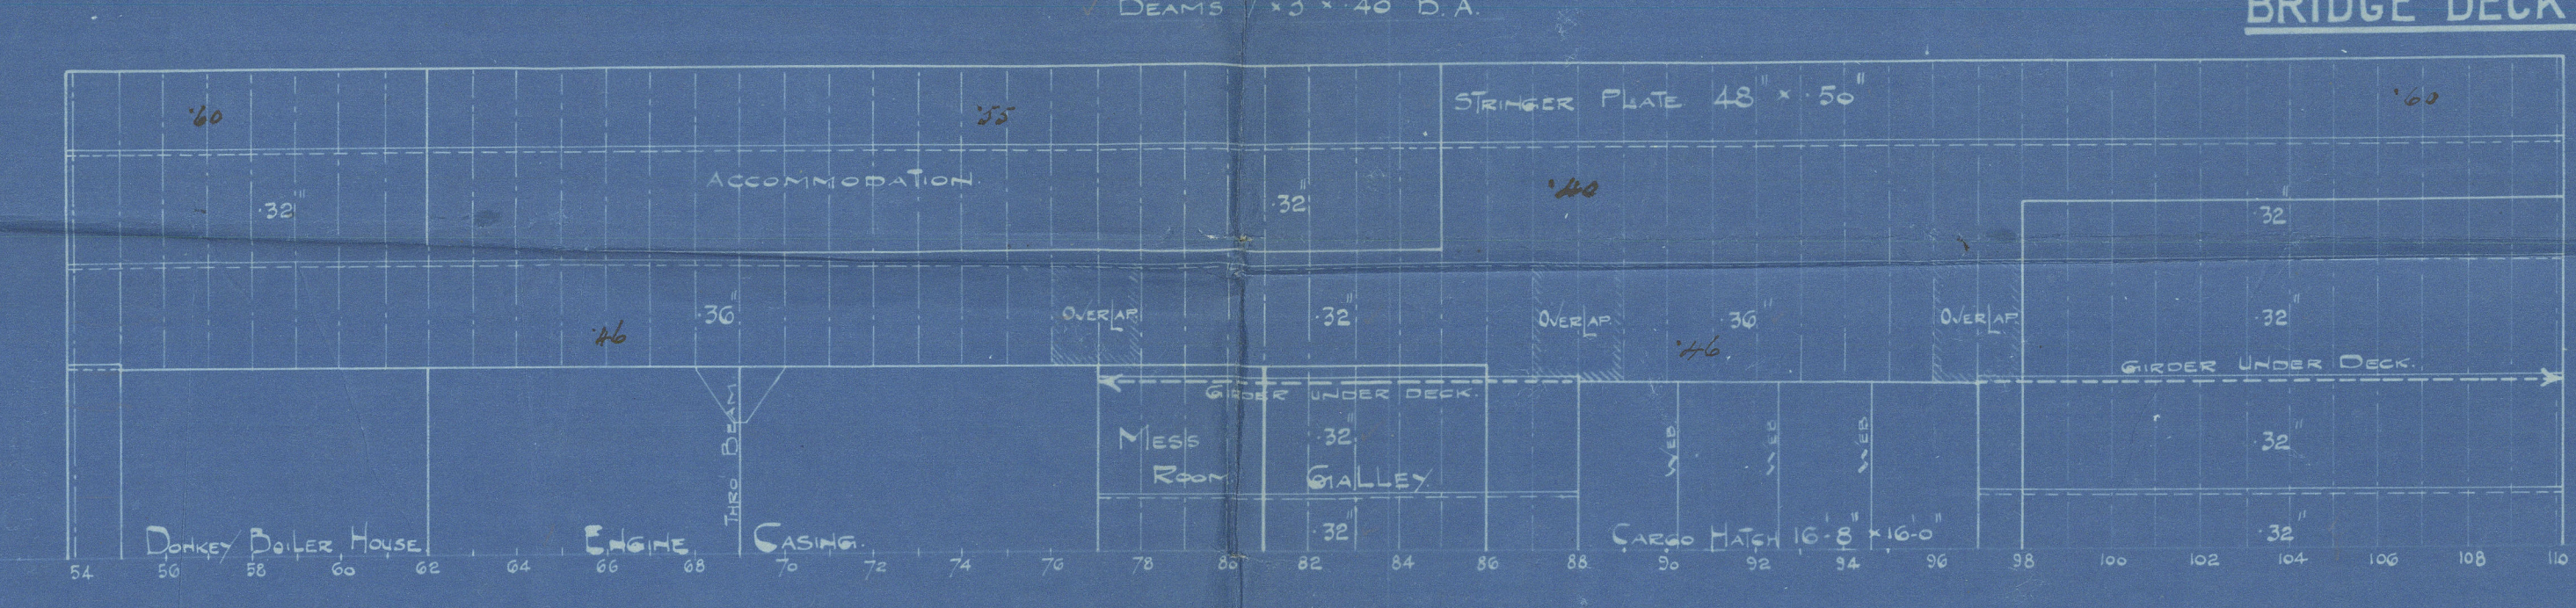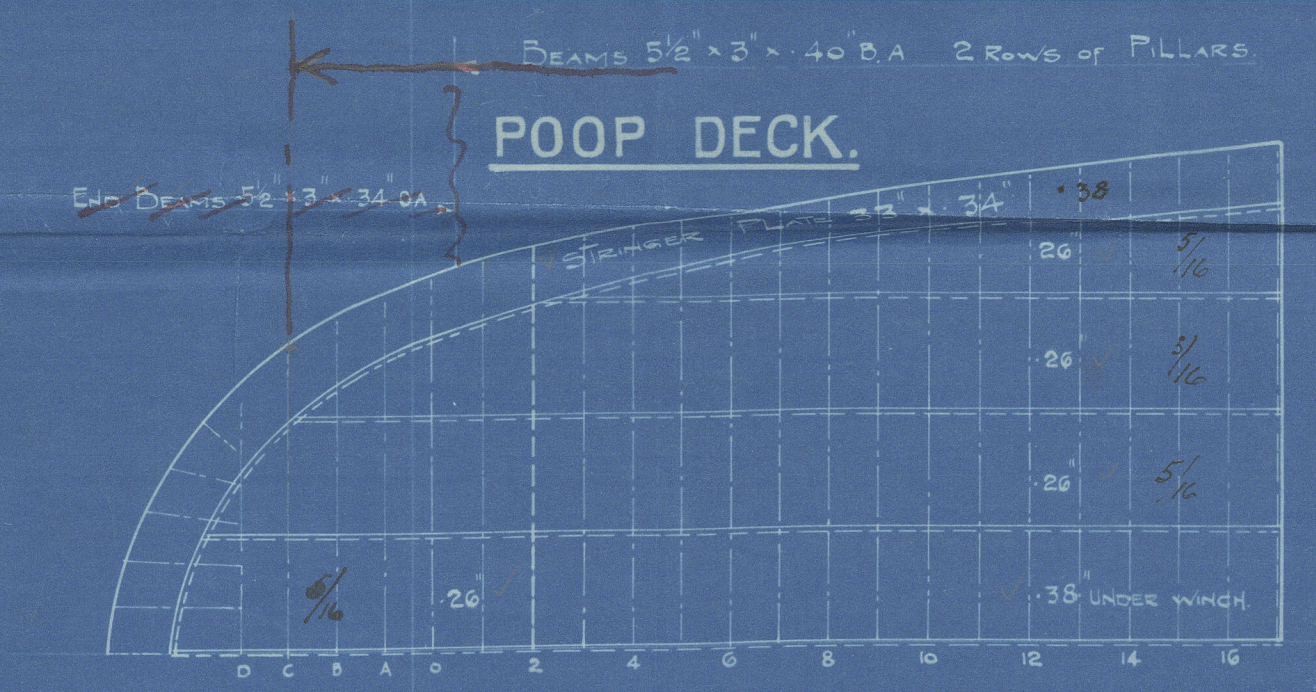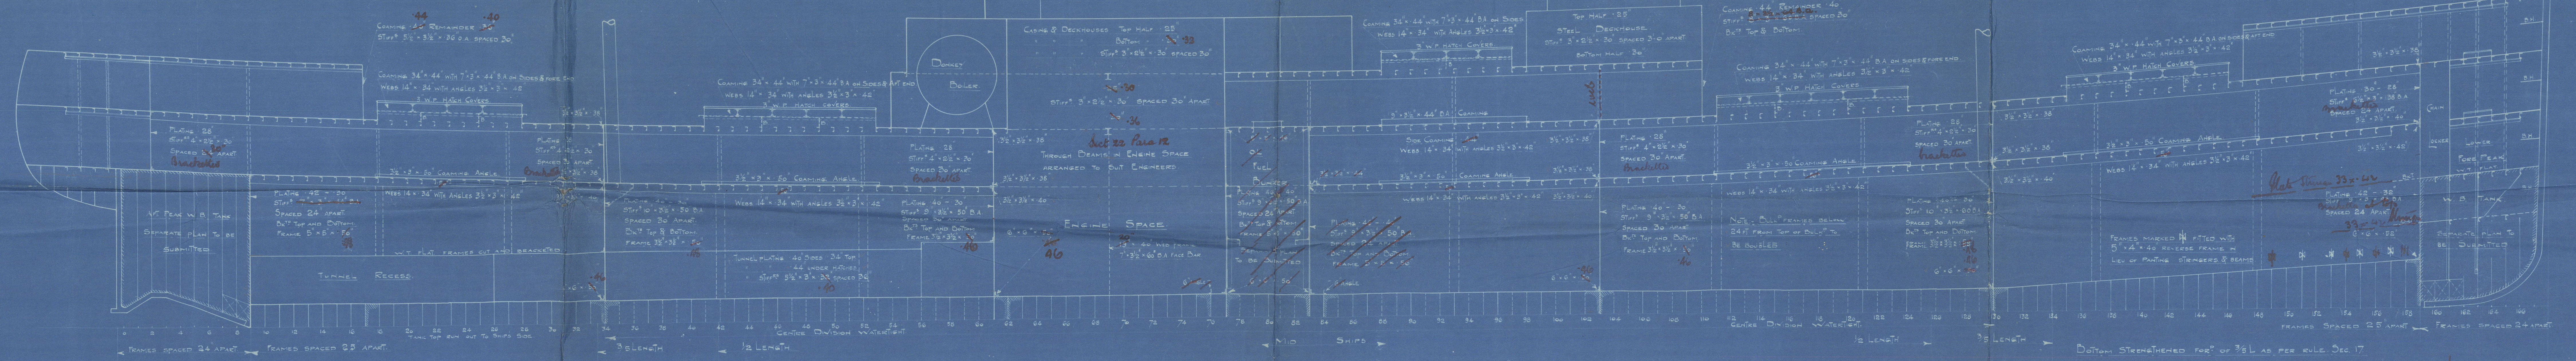

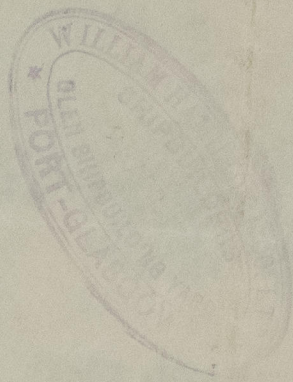

© 2020

Lloyd's Register
Foundation

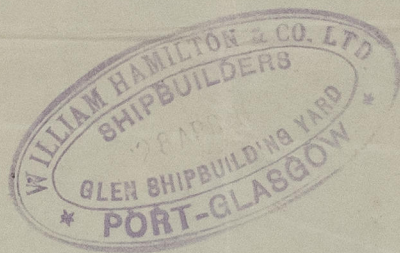

© 2020

Lloyd's Register
Foundation

007620-007625-0125

Profile and deck plans
Messrs W^m Hamilton & Co
No 377


J.S.B. "Maria".

Greenock Kpt. No 17887.

377

007620-007625-0125

007620-007625-0125

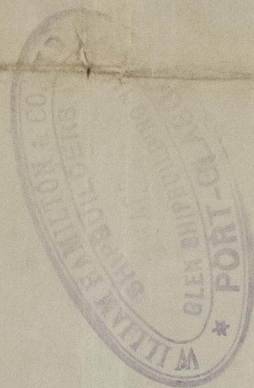

© 2020

Lloyd's Register
Foundation