



- S.S. HOLMENGRÄ. -

SKETCH OF BRIDGE FRONT BULKHEAD SHOWING STIFFENING AS FITTED IN SHIP.

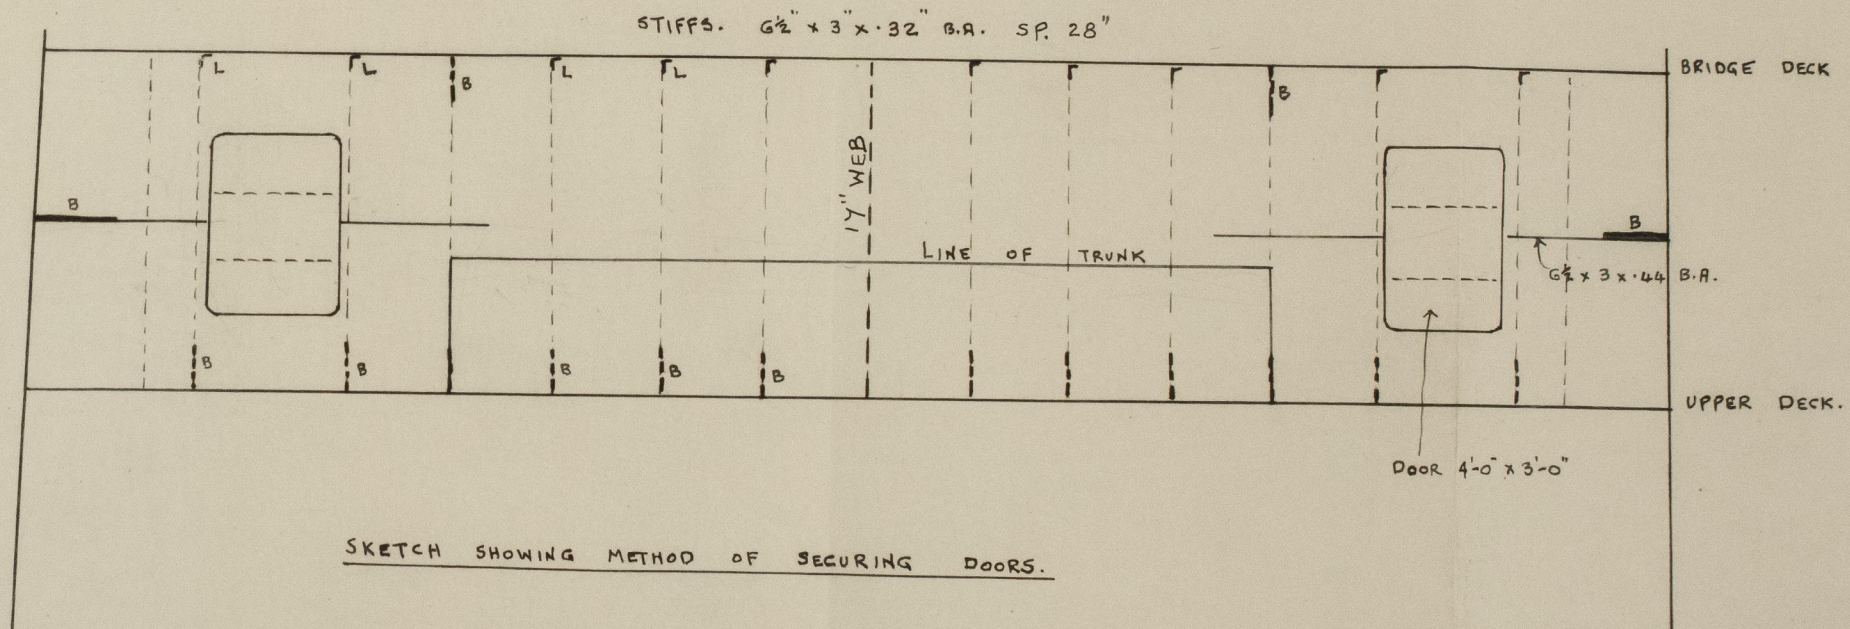

SKETCH SHOWING METHOD OF SECURING DOORS.

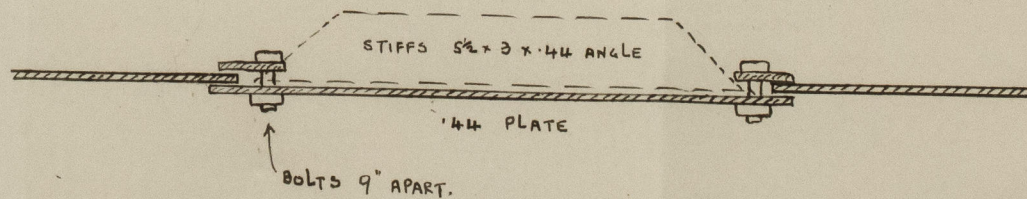

Class B



© 2020

Lloyd's Register

057626-007658-0195