


— S.S. HOLMENGRÄ —

SKETCH OF HATCH WEBS AS FITTED IN SHIP.

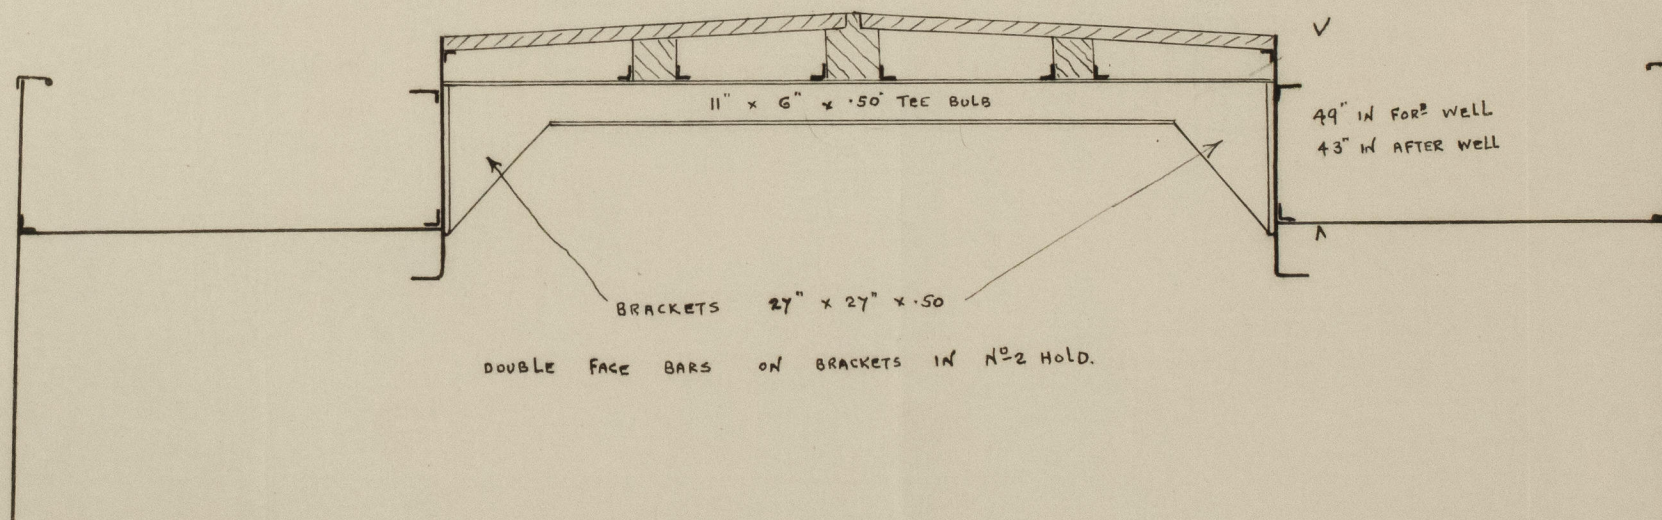

© 2020

Lloyd's Register

607626-007638-0196