

TRACING N° 1510.

PROFILE AND DECK PLAN S.S. N° 190-

SCALE $\frac{1}{4}$ IN. = 1 FOOT.

LENGTH 120'0" BREADTH 22'0" DEPTH 10'0"


TO CLASS 100 A1 AT LLOYDS.

R. WILLIAMSON & SON.

SHIPBUILDERS.


WORKINGTON.

6. 11. 02
15. 12. 02
13. 6. 03
19. 8. 04
24. 9. 04
17. 9. 06



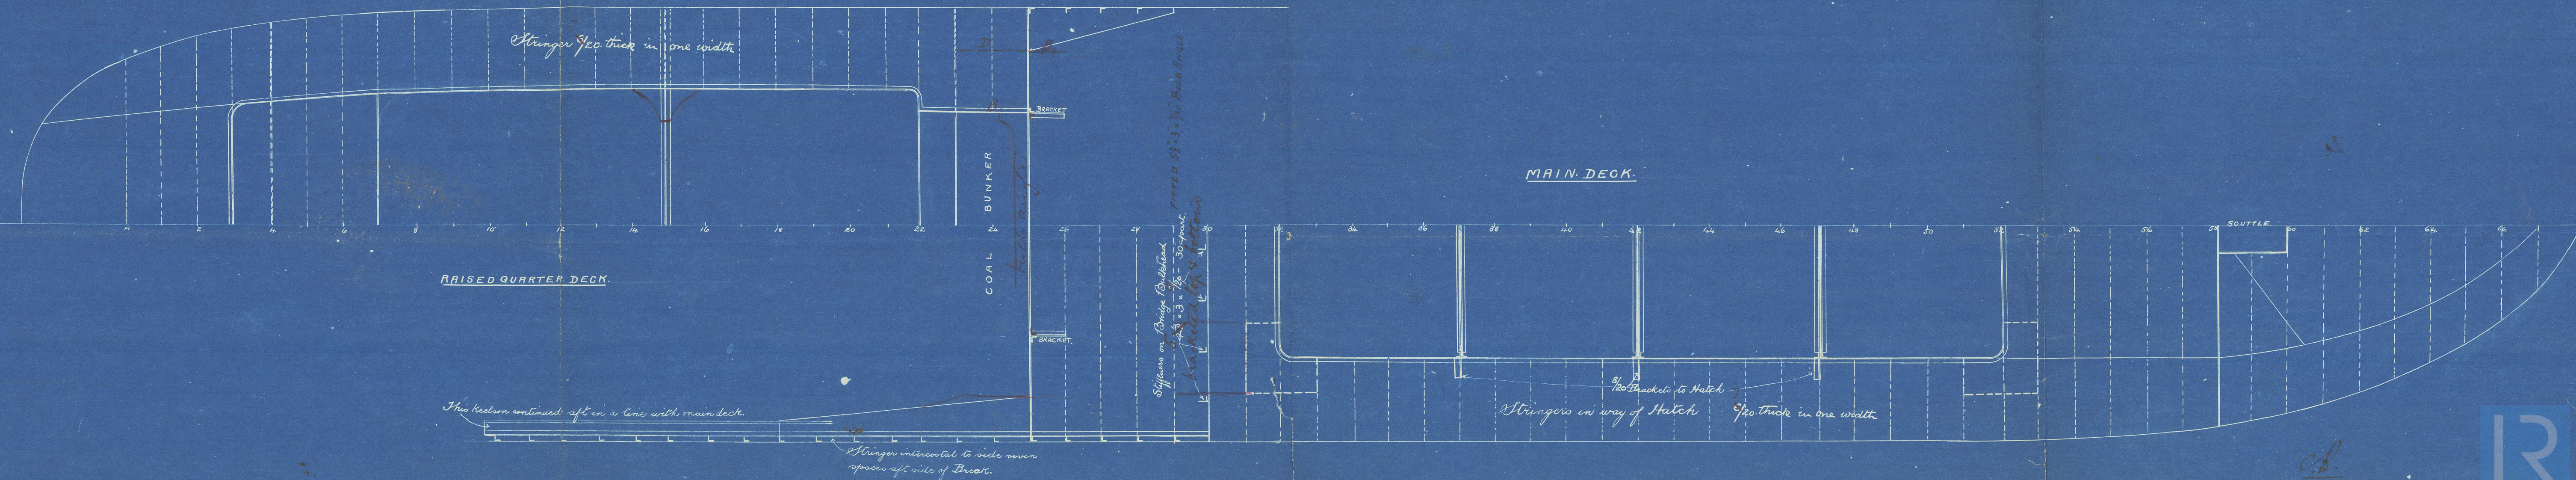


Bottoms strengthened as per rule

6. 11. 02.

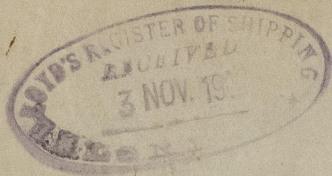

Wmson's 190-191

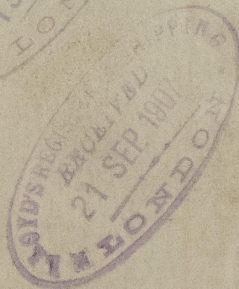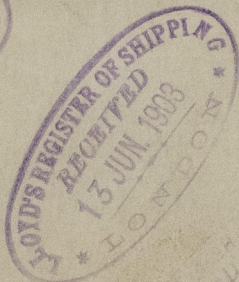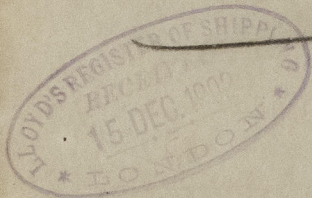


R. Williamson & Son


S. S. Nos 190-191

Profile & Deck Plan

S. S. "Guanche" 190

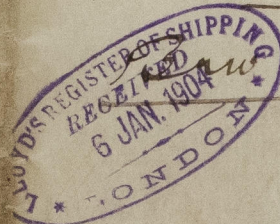

Rpt. 1164

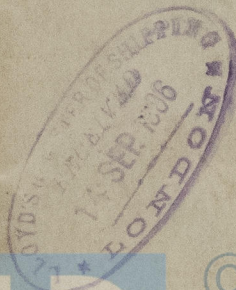

© 2020

Lloyd's Register

Foundation

007626-007658-00727