


# PROFILE & DECK PLANS.

S.S. WAR SEAGULL

Dim 400'-0" BP x 52'-0" MD x 31'-0" MD.

Scale 1/8" = 1 FOOT.

 

PLAN N° 55N-703.

8319

SHOOT BROTHERS LTD. SUNDERLAND

007639-05646-0202



SUNDERLAND


Messrs Short Bros L<sup>d</sup>

PROFILE & DECK PLAN (AS BUILT)

No 403  $\frac{1}{4}$ " Zingon Maru

S.S. "HINDUSTAN"

SUNDERLAND RPT. NO. 27445

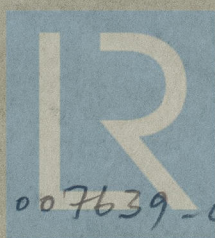

© 2020

Lloyd's Register  
Foundation

007639-007646-0207