

SCANTLING NUMBERS.

FIRST LONGITUDINAL NUMERAL	L x D = 3150
SECOND " "	L x D = 9870
4 (MAIN DECK) = 12.42 FT	
4 (R. 9. D) = 16.92 FT	
4 (MAIN DECK) = 14	
4 (R. 9. D) = 10.77	
4 (BRIDGE DECK) = 9.33	

SHEER FORW. AT STEM	5' 8 1/2"
" " AT 1/2 L	2' 9 1/4"
" " AT BREAK (FR 35)	2 3/4"
" " AFTER AT 1/2 L	1' 2 3/8"
" " AT RUDDERPOST 2' 7 1/4"	
LENGTH OF R. 9. D.	65' 11"
" " OF BRIDGE DECK 144' 1"	

SECTIONS.

SCALE 1:20.

SINGLE SCREW STEAMER.

No 536.

CLASS: 100.A.I. AT LLOYDS REG.



With Freeboard

EQUIPMENT.

SECOND LONGITUDINAL NUMERAL	9870
RAISED QUARTER DECK	65' 9 1/2" x 14' 5"
LETTERM.	NUMBER 112.61
2 BOWER ANCHORS	STOCKLESS 23 1/4 cwt
1 BOWER ANCHOR	STOCKLESS 20 1/2 cwt
1 STEAM ANCHOR	6 2 1/2 cwt EX STOCK
210 FMS.	1 1/2" STUD CHAIN CABLE

PRINCIPAL DIMENSIONS.

LENGTH OVER ALL	67.320 M. 220' 10 1/2"
LENGTH BETW. P.P.	64.000 M. 210' 0"
BREADTH MLD.	9.760 M. 32' 0"
DEPTH MLD. TO MAINDECK	4.572 M. 15' 0"
R. 9. D. ABOVE MAINDECK	1.372 M. 4' 6"
BRIDGE DECK	2.286 M. 7' 6"

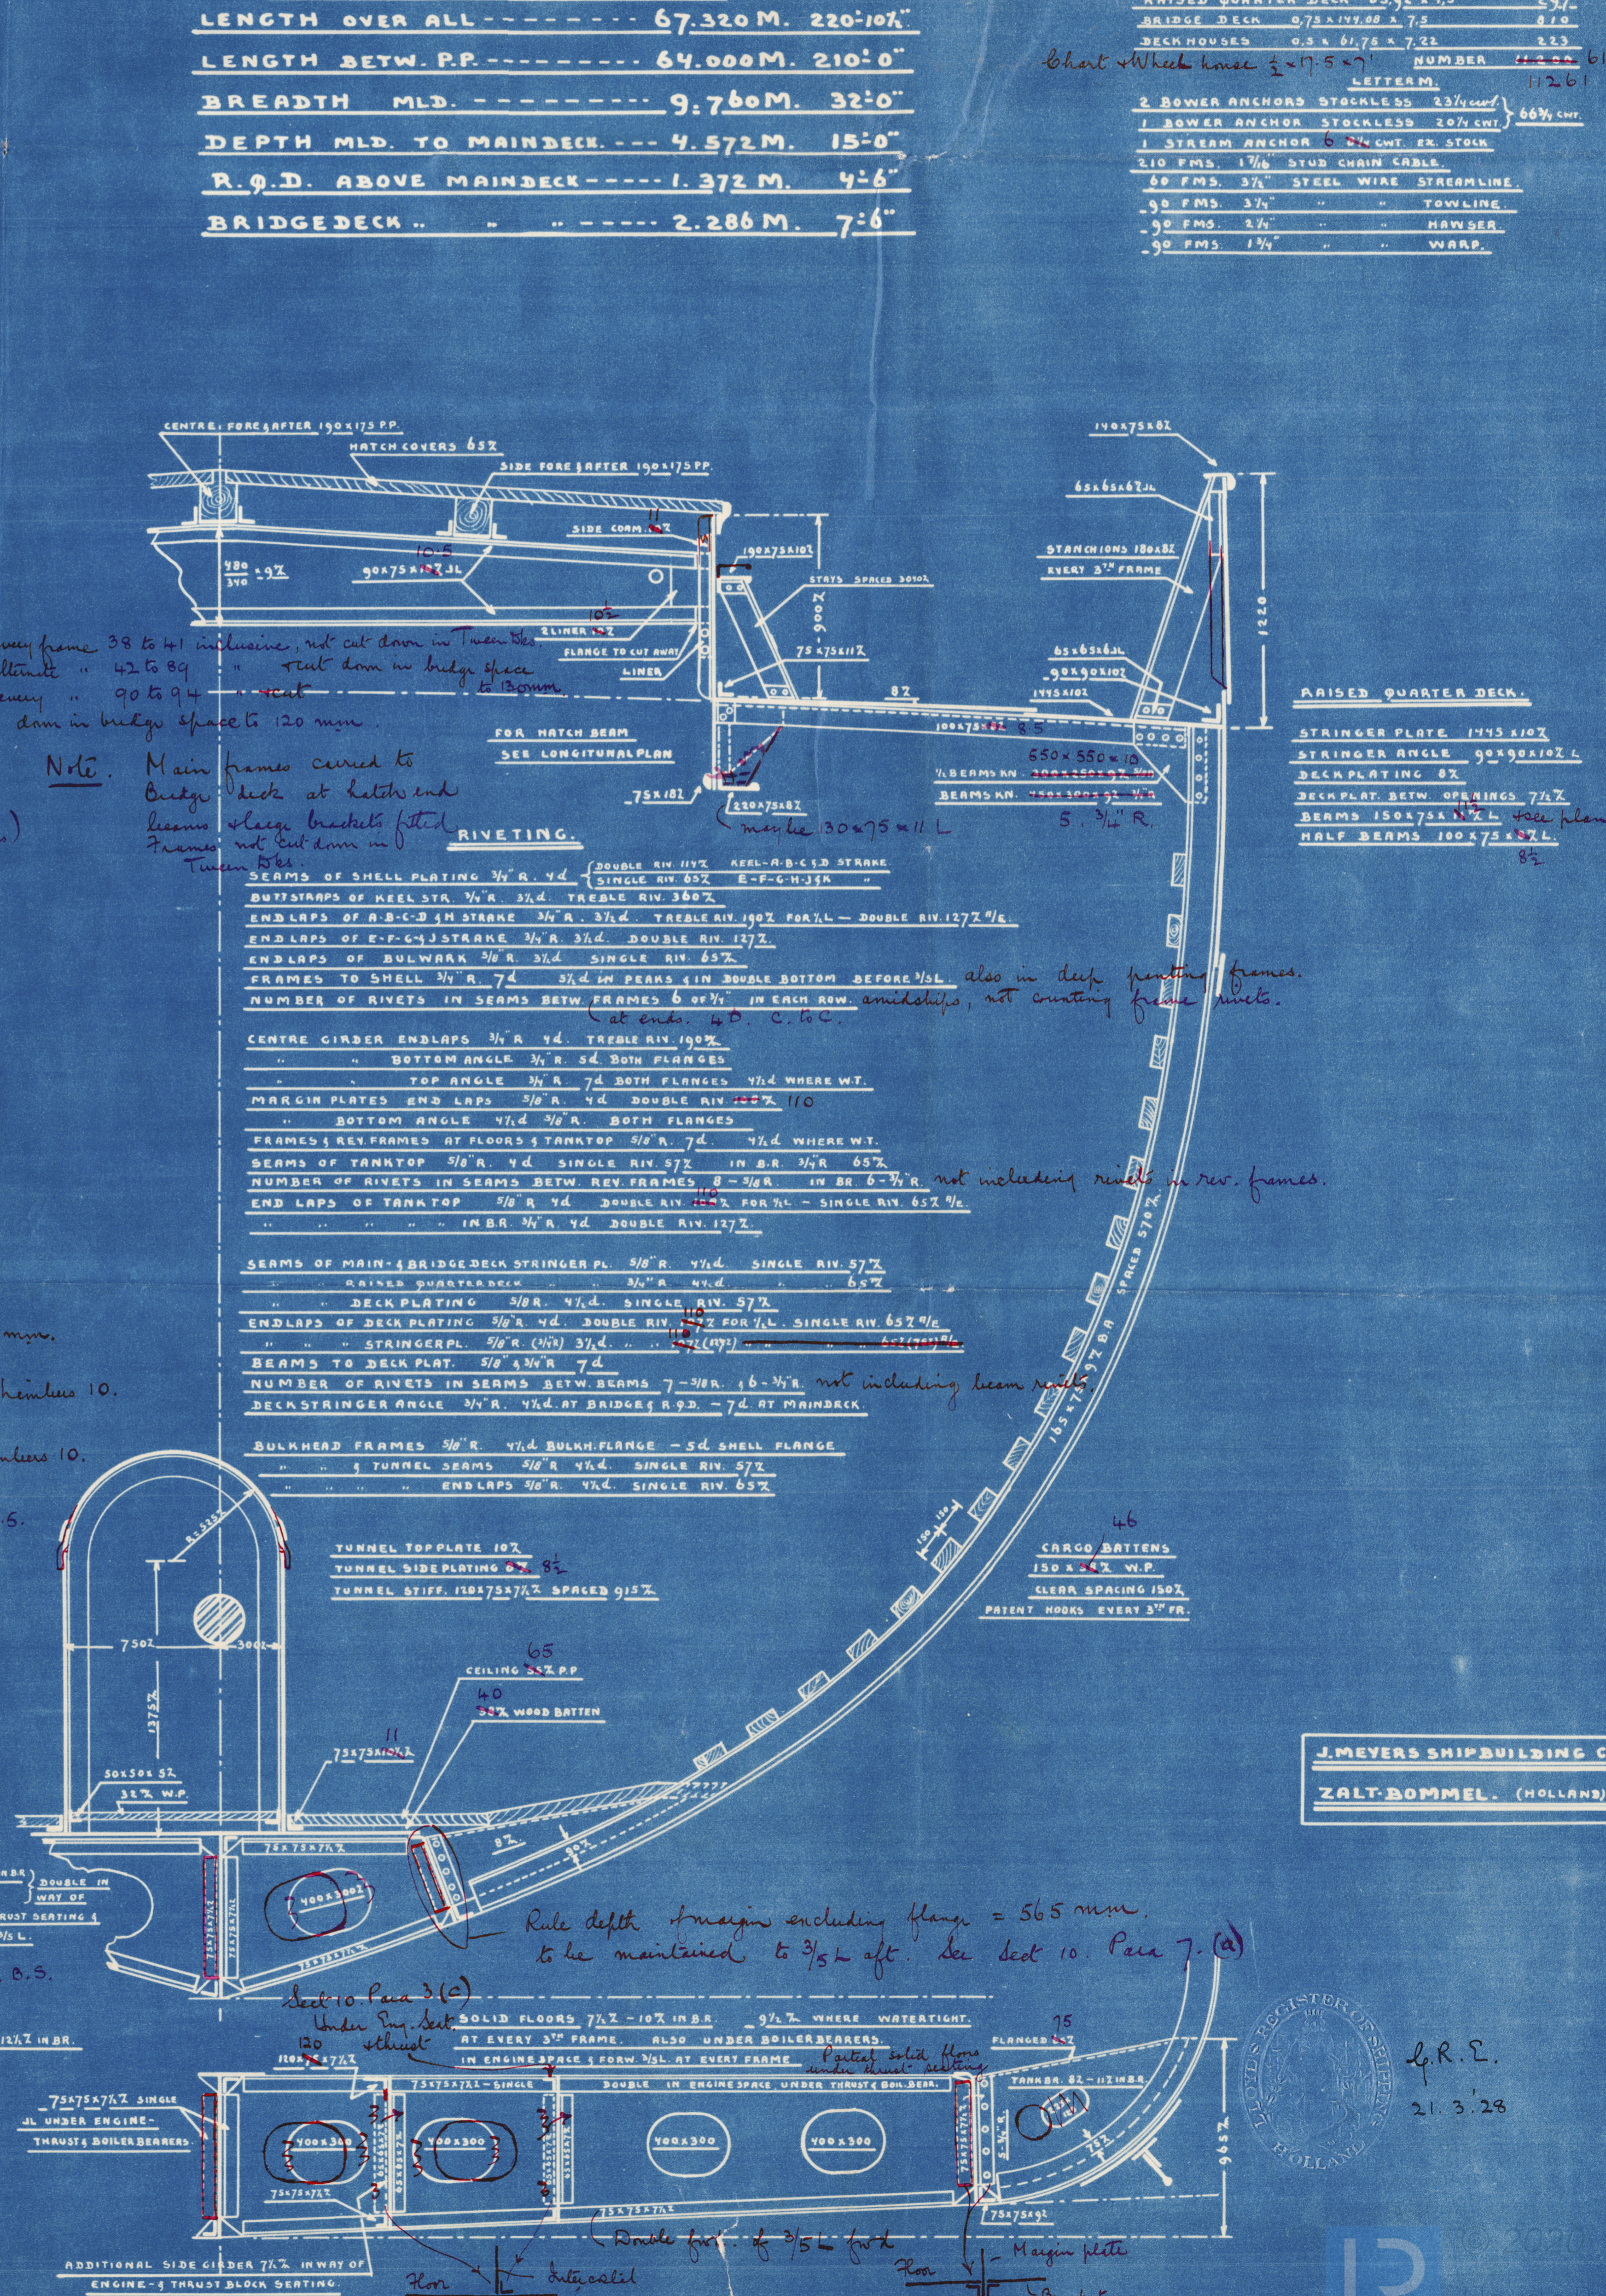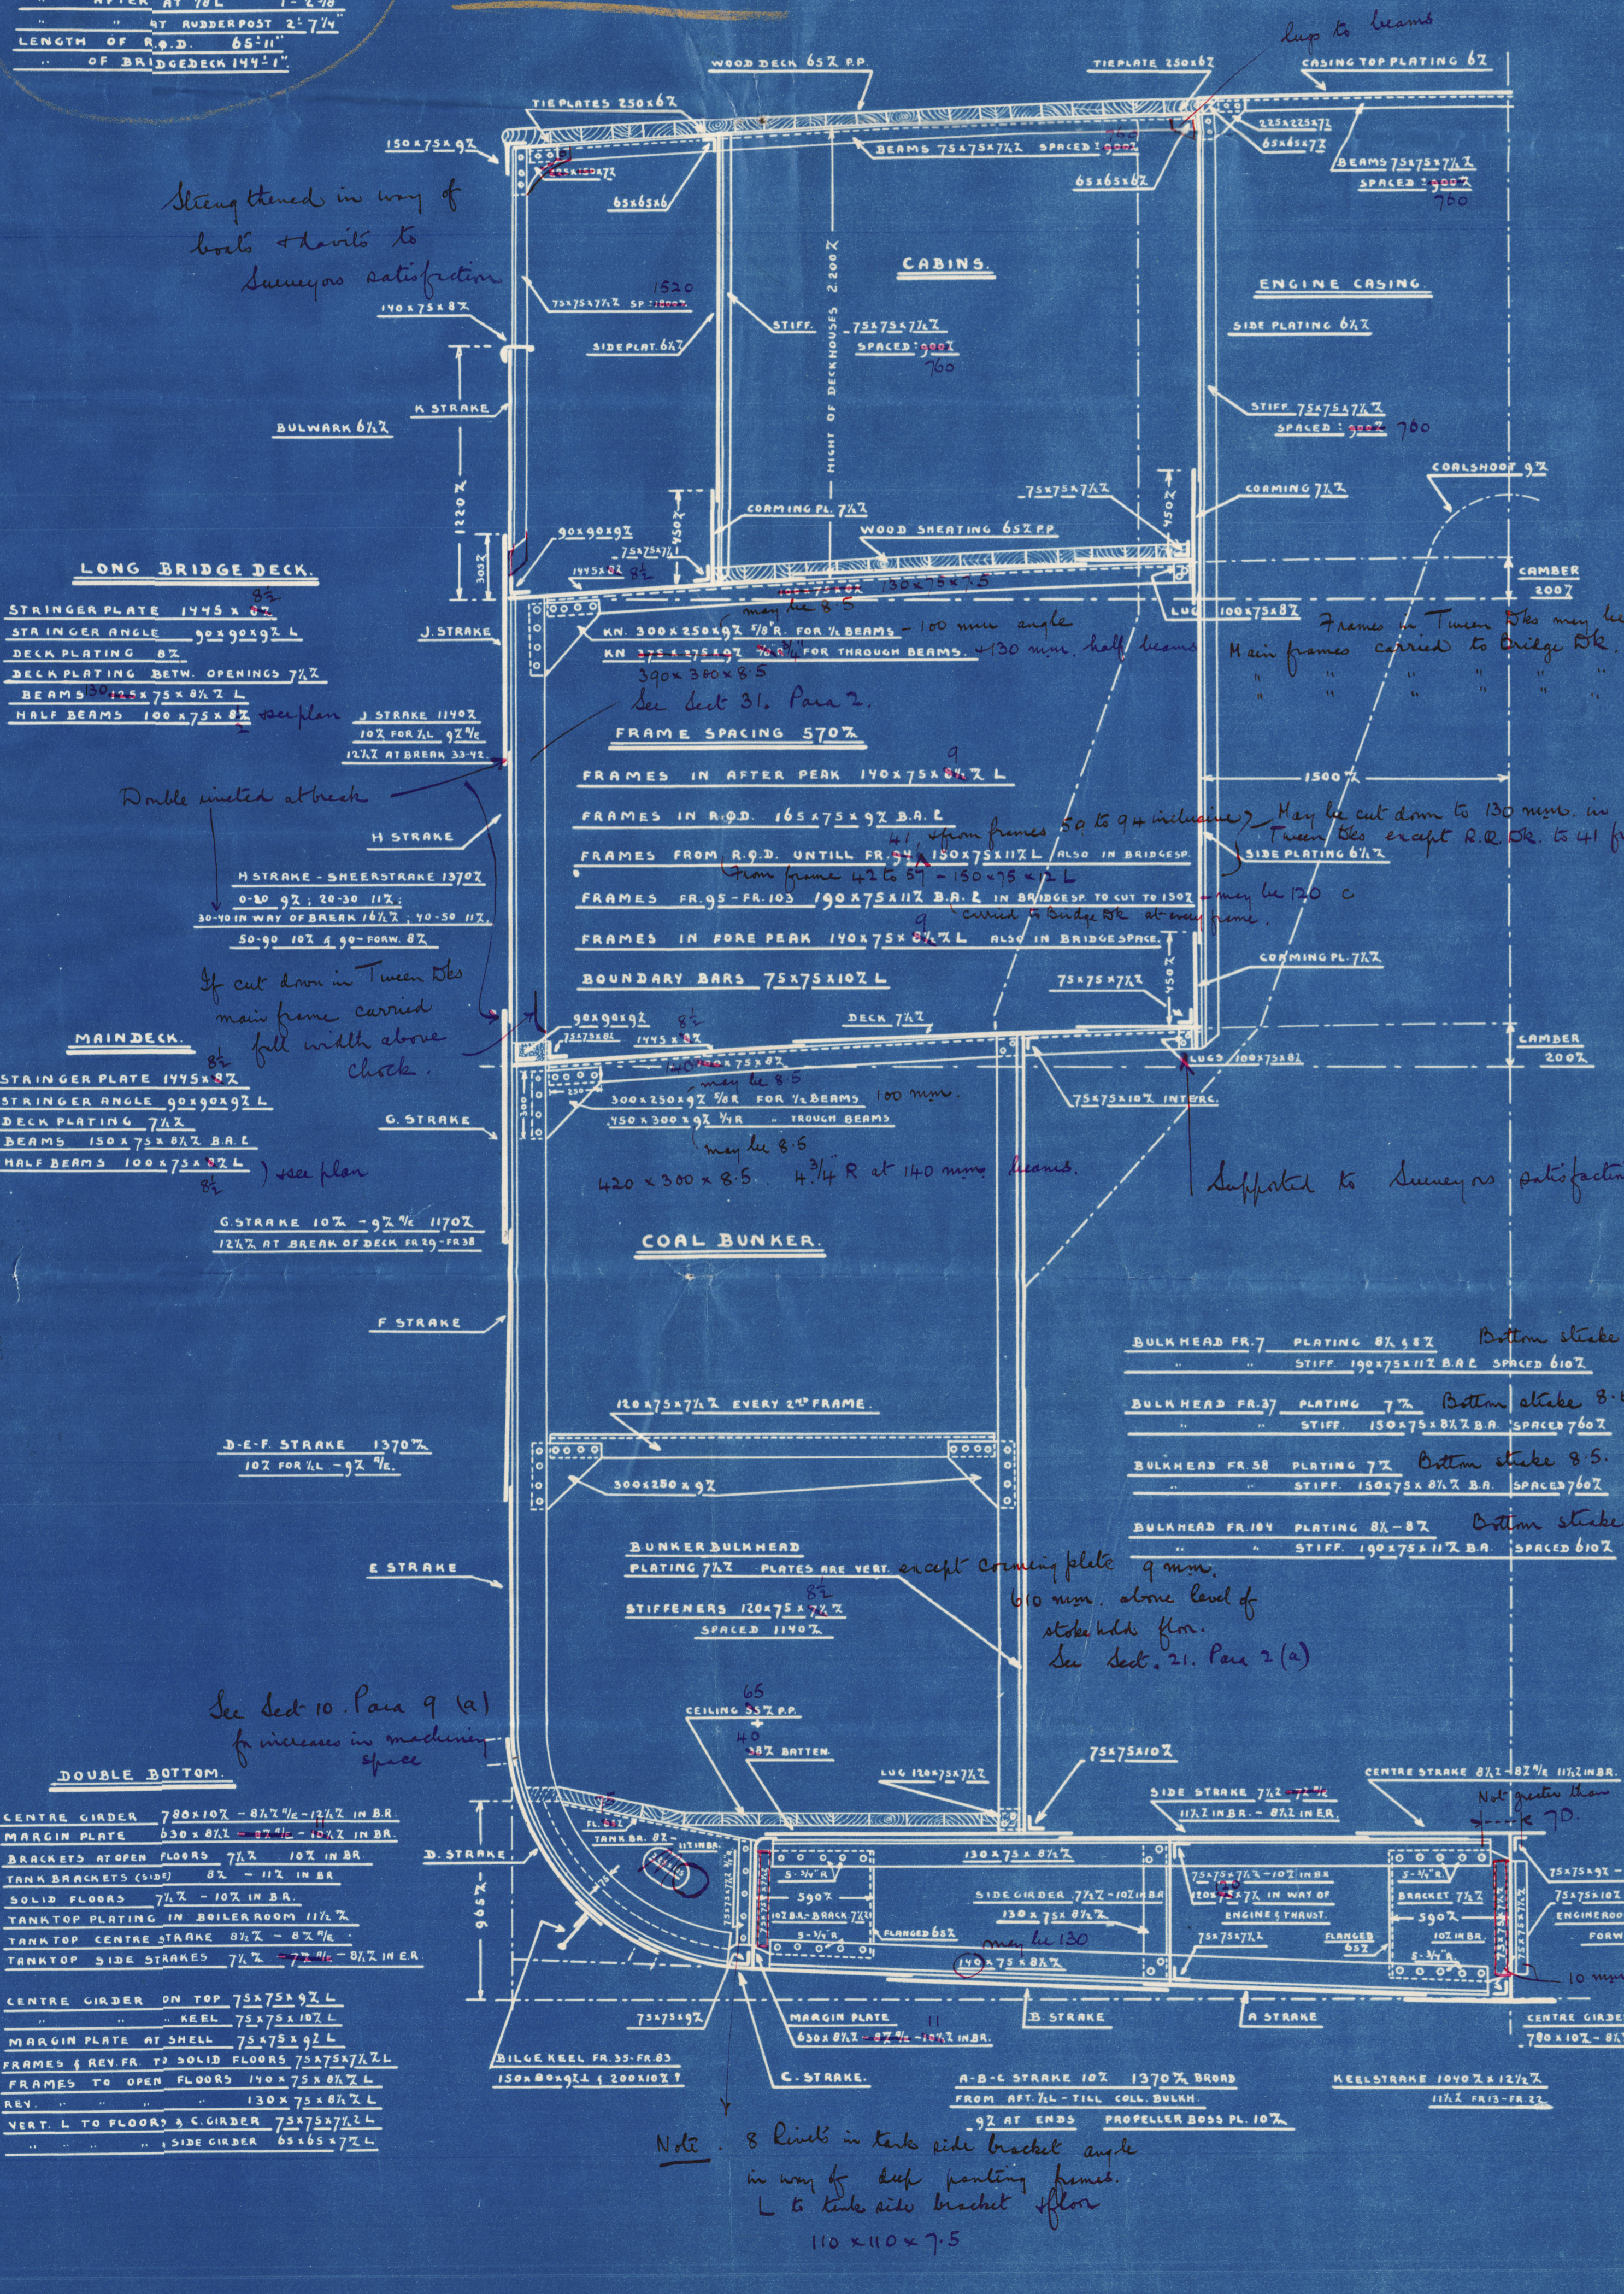

J. MEYERS SHIPBUILDING CO
ZALT-BOMMEL. (HOLLAND)



Meyers
536

Sections


"Vinte e Oito de Maio"

~~GEN. BOX NO. 477~~
ex.

"Westpolder"

Rot. 18109.

A.S. 588

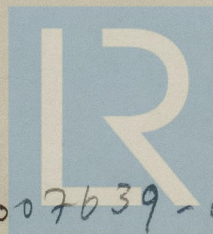

© 2020

Lloyd's Register
Foundation

007639-007646-0245