


M.S. LA PLATA-MARU.


CONSTRUCTION PROFILE & DECK PLAN. (SHEET II.)

SCALE 1/8" TO ONE FOOT.

 

Yn "Kangya Maru"
Wag
1533
Kurofuku

M.S. LA PLATA-MARU
CONSTRUCTION PROFILE & DECK PLAN
(FINISHED PLAN)
SCALE 1/8" TO ONE FT.

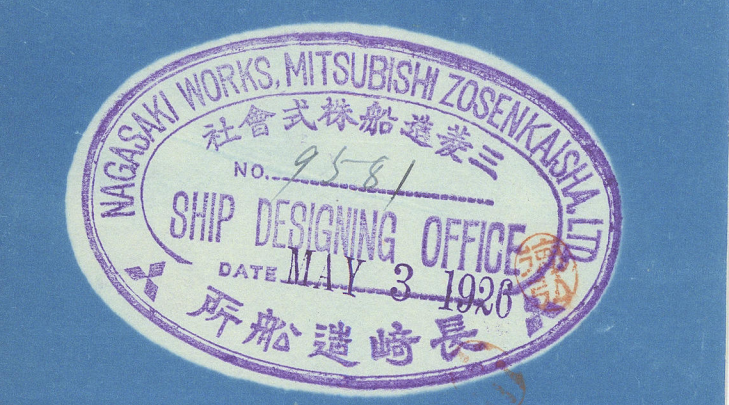

Y. Nakamura
Dec. 1918
Lloyd's Register
Foundation