


船名	9号
竣工	5月4日
造	1
所	4
数	1
機	2
機	2

N2374
440 FT. S.S. MOTOR CARGO SHIP
RUDDER AND STERN FRAME.
SCALE 1/2" TO 1 FT.

DETAIL
SCALE 1" TO 1 FT.

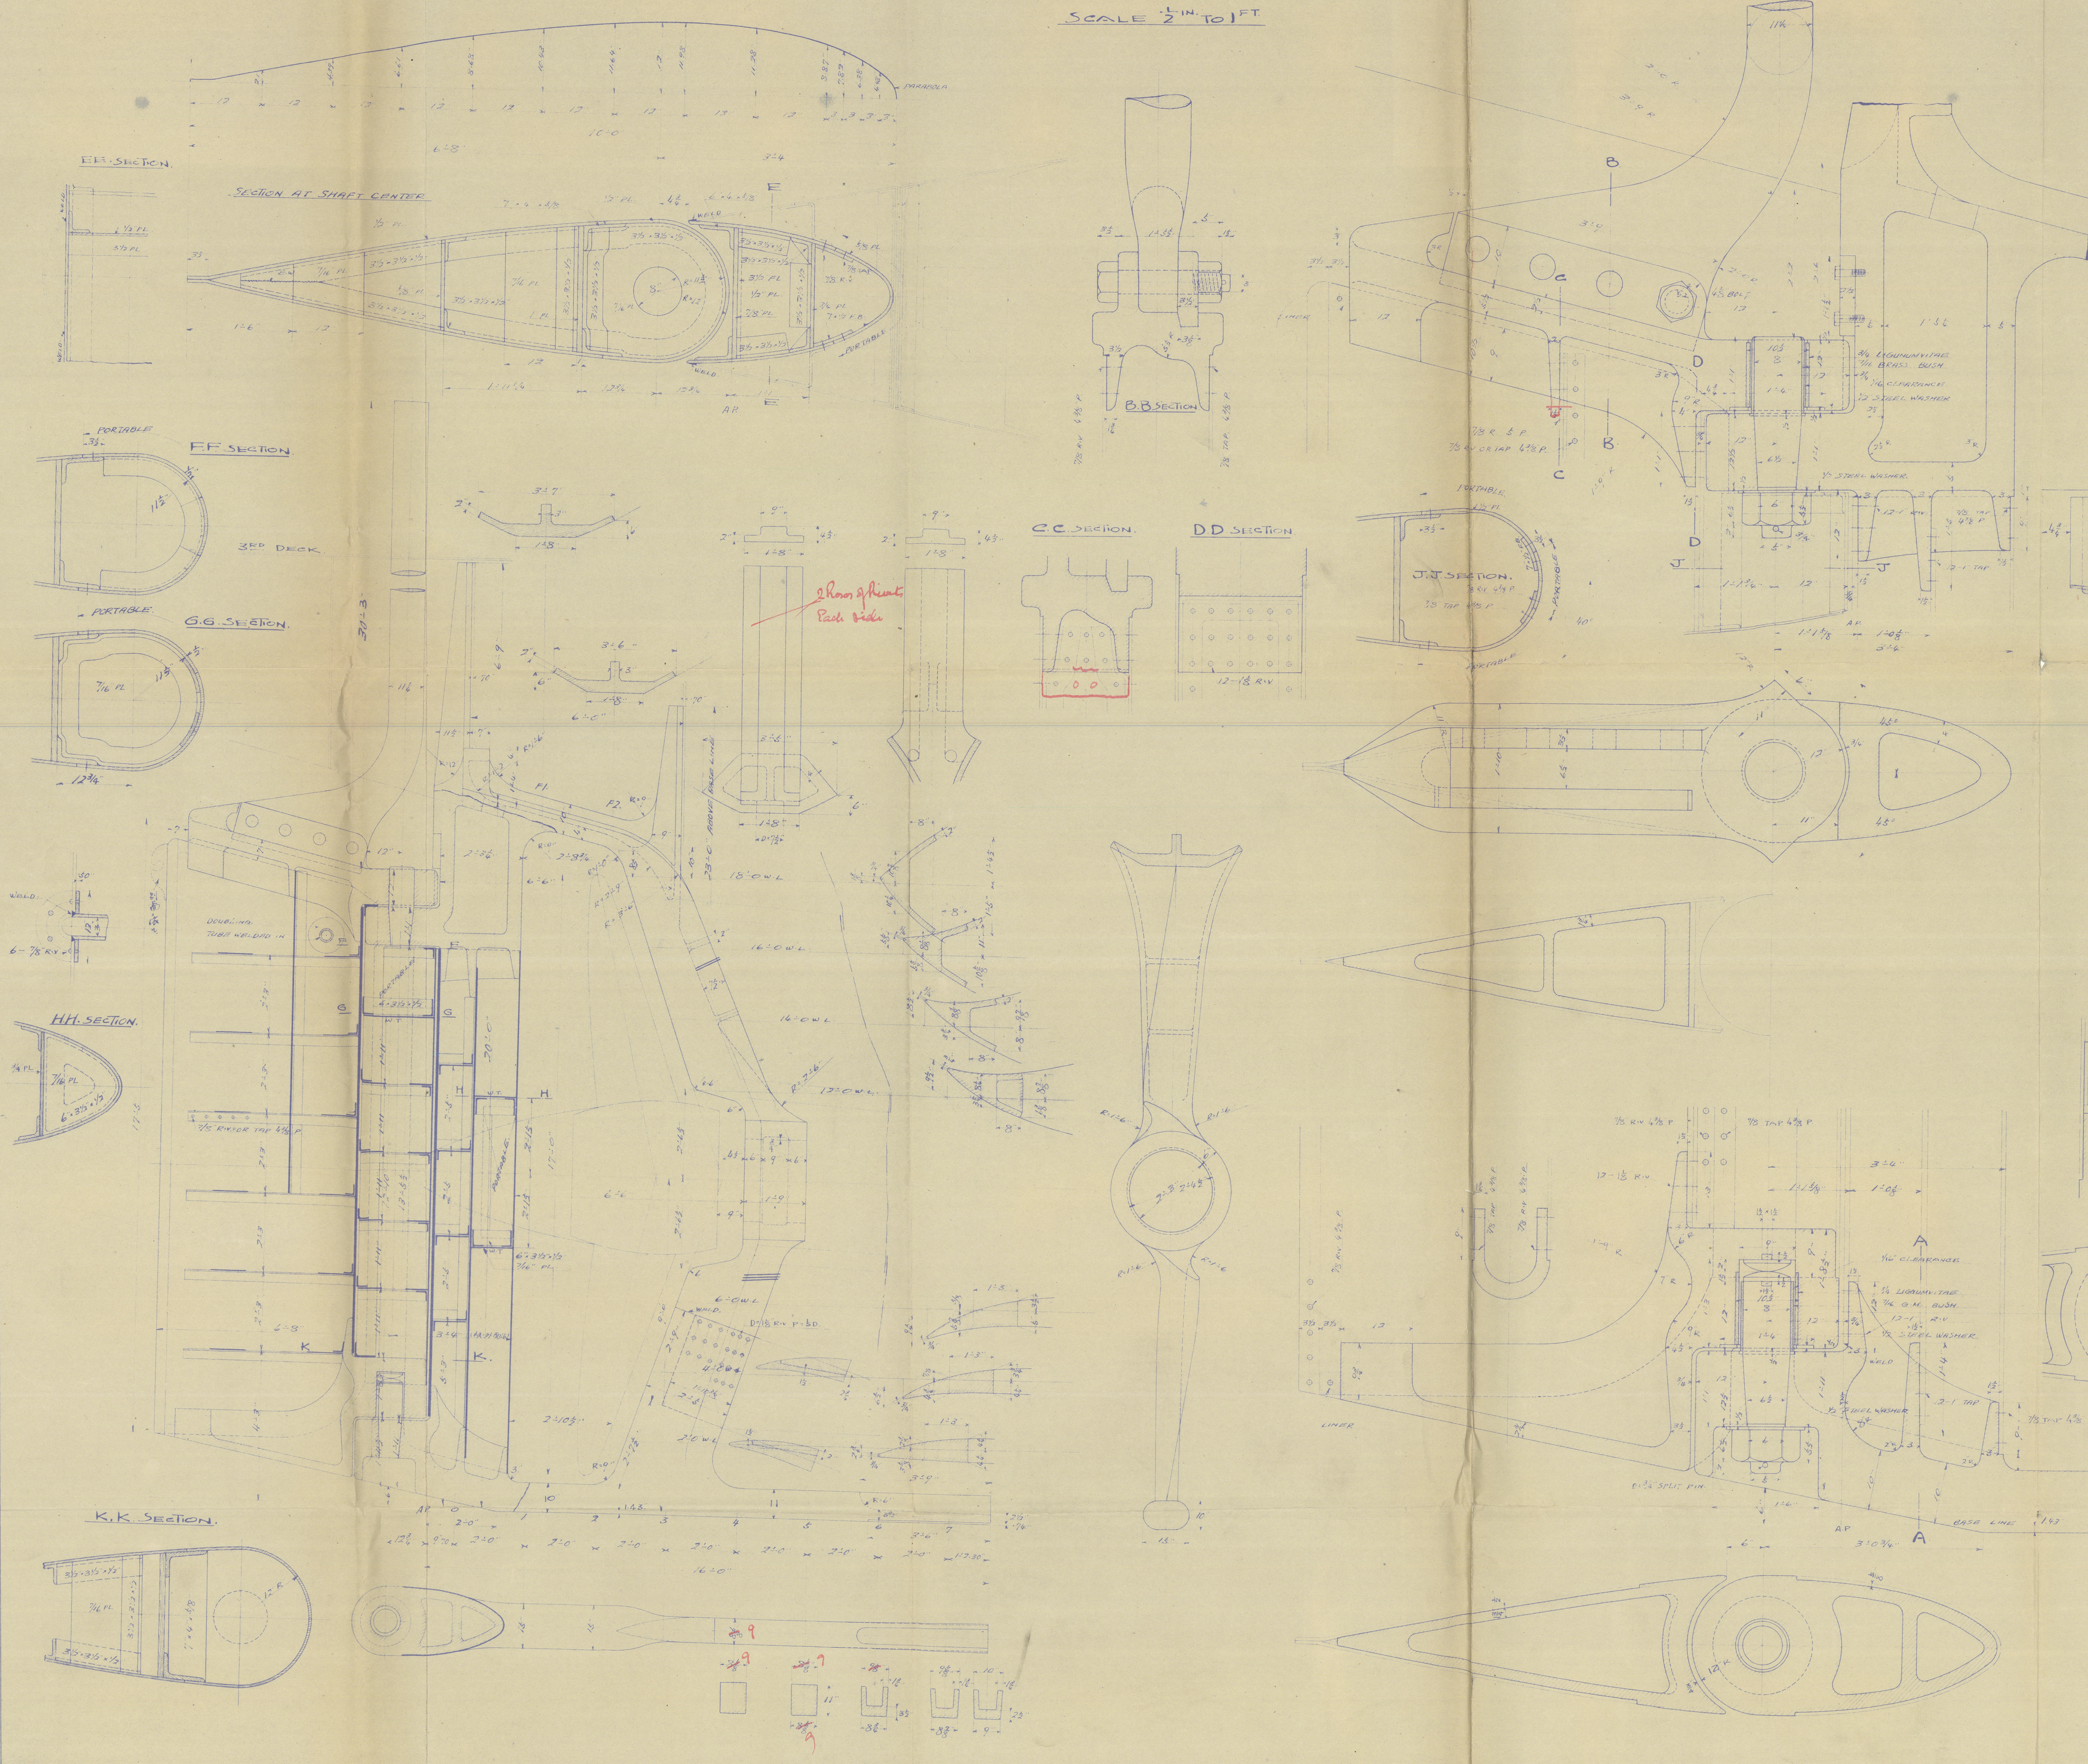

NUMERALS & SPEED.

A	127 1/2
D	319
A x D	405
SPEED	17 KTS. (ALL LIGHT CONDITION)

MATERIALS.

STERN FRAME. CAST STEEL.
RUDDER ARMS. "
RUDDER HEAD. FORGED."
PINTLES. "


APPROVED
MAY 1 1900
KOBÉ

Sketch

Ship's Name or No. 3 7 4.	
Name RUDDER AND STERN FRAME.	
of	
Drawing	
Drawing No.	Sending No.

8/5

"KABURAGI MARU."

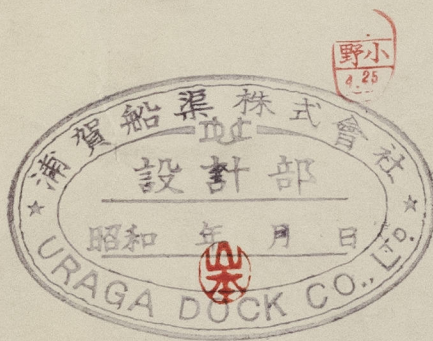

© 2020

Lloyd's Register
Foundation

007658-007667-0243