

For the information of Surveyors and the Committee only.

Received at _____ Office _____ 19

Lloyd's Register of Shipping.

(Report on Vessel No. _____ Port _____)

No. 1660q. SHIP FORGINGS ~~OR CASTINGS~~

I have to report that the undermentioned ~~Iron or Steel Forgings or Castings~~, manufactured by Colcland's Shipway & Graving Dock Co. L.P. of Wilmington Quay for the Vessel No. 1101, being built by Burntisland F.S.L. of Burntisland have been inspected by me as set forth below and found to be, so far as can be seen, Sound

New S.P.R. as per Plan


Mark on Forgings or Castings.

Lloyd's
No. 4182.N.
W.C.

W. Campbell
Newcastle

	STERN FRAME.	RUDDER FRAME.	STEM.
Material*	<u>Scrap Steel</u>	<u>Scrap Steel</u>	
How made	<u>Forged & Smithed</u>	<u>Forged & Machined</u>	
Dimensions	<u>10 1/2 x 9 x 6 1/2</u>	<u>8 1/2</u>	
Progress on Inspection	<u>Forging & Smithing</u>	<u>Machining & Built</u>	
Date when Inspected	<u>September 28, 1918, to April 16-1919.</u>		
CASTINGS.			
Tests on Standard Test Pieces.			
Tensile Test—			
Tons per square inch			
Extension per cent.			
Cold Bending Test—			
Angle before fracture			
Drop Test—			
Height from ground			
Hammering Test—			
If made according to Rules and found satisfactory			

SKETCHES OF FRAMES SHOWING POSITION AND DESCRIPTION OF WELDS OF FORGINGS.

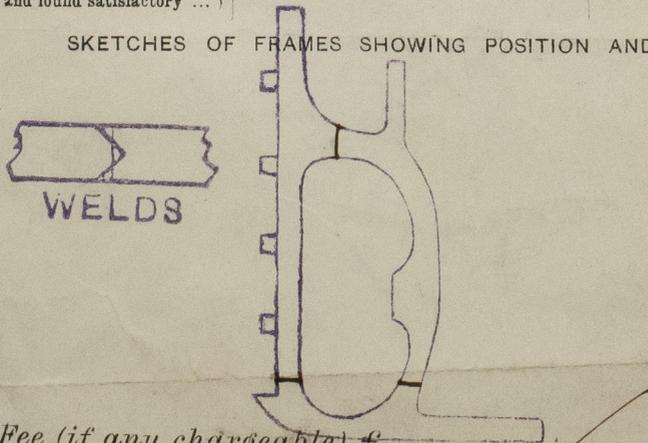

Fee (if any chargeable) £ _____

To be paid at _____

* If of Iron, state whether scrap or puddled Iron. If of Steel, state whether made on the Open Hearth process.

