

TO CLASS 100 A.I.AT LLOYDS



Geo Brown & Co No 92

---


Amended Profile & Dks

---

19.11.14

---

Porto Grande

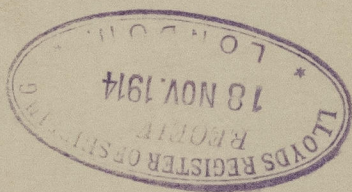

© 2021

Lloyd's Register  
Foundation

8910-F69600-889600