


'PORTO GRANDE'

DECK PLAN.

M. V. ...

No. 5339

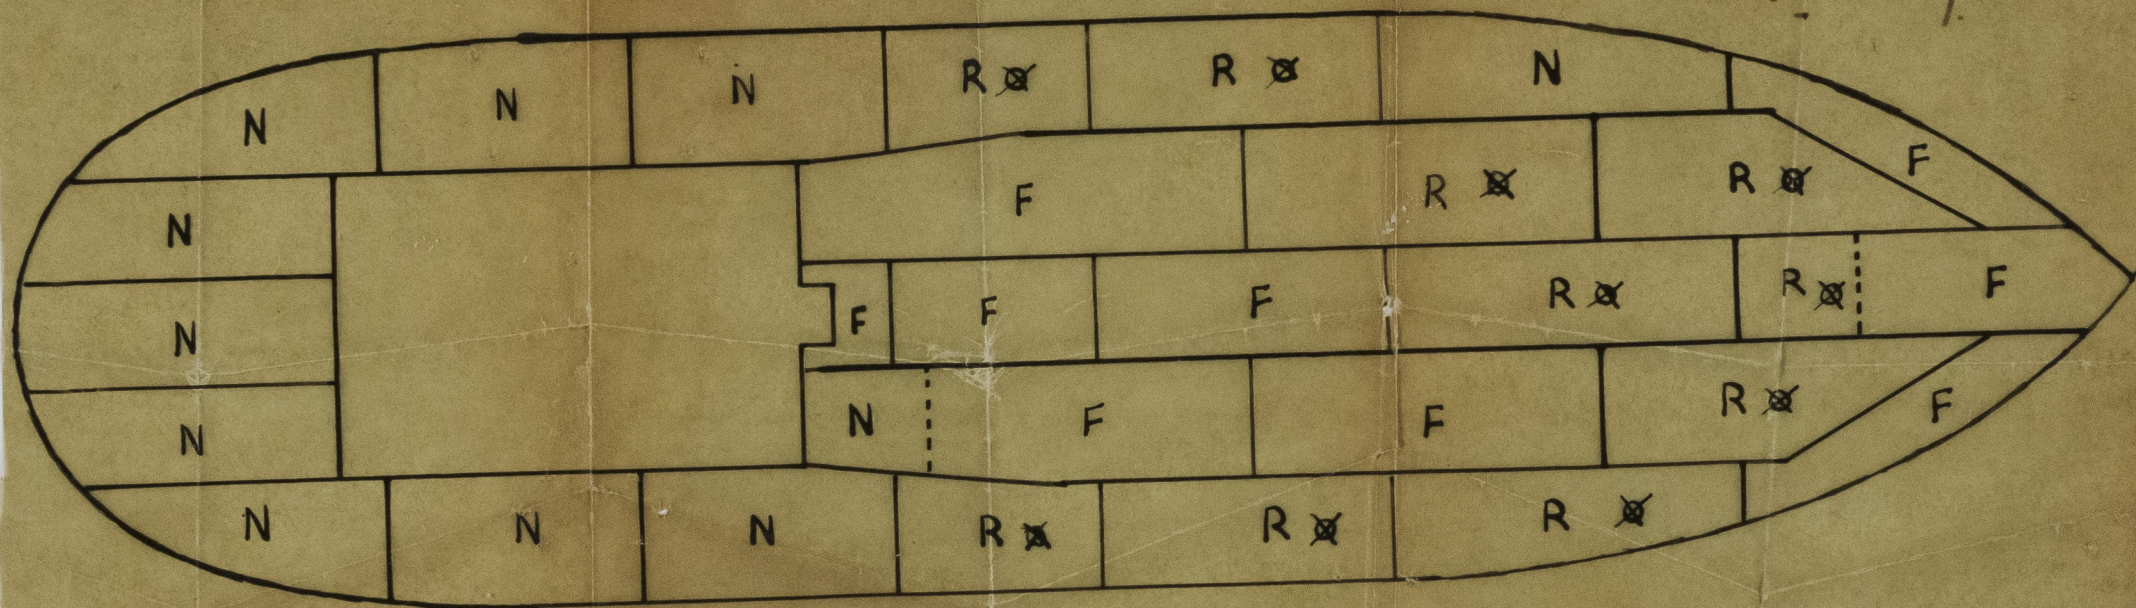

PLATES MARKED N. WERE RENEWED 1933/34 AND ARE IN VERY GOOD CONDITION.
 " " F. ARE STILL IN FAIRLY GOOD CONDITION.
 " " R X HAVE TO BE RENEWED



© 2021

Lloyd's Register
Foundation