

25. 4. 13

### PROFILE & DECK PLAN


STEEL                      SCREW                      TRAWLER

Nº575

DIMENSIONS. 117'-0" B.P. x 22'-0" EXT x 12'-9" MLO

SCALE 1/4 INCH

PLAN No. 2762  
FOR ENCLOSURE TO  
Messrs Lloyd's Surveyors  
Hull FROM  
COSTRANE & CO., LTD  
SHIPBUILDERS, SELBY  
DATE 18/4/13 RK

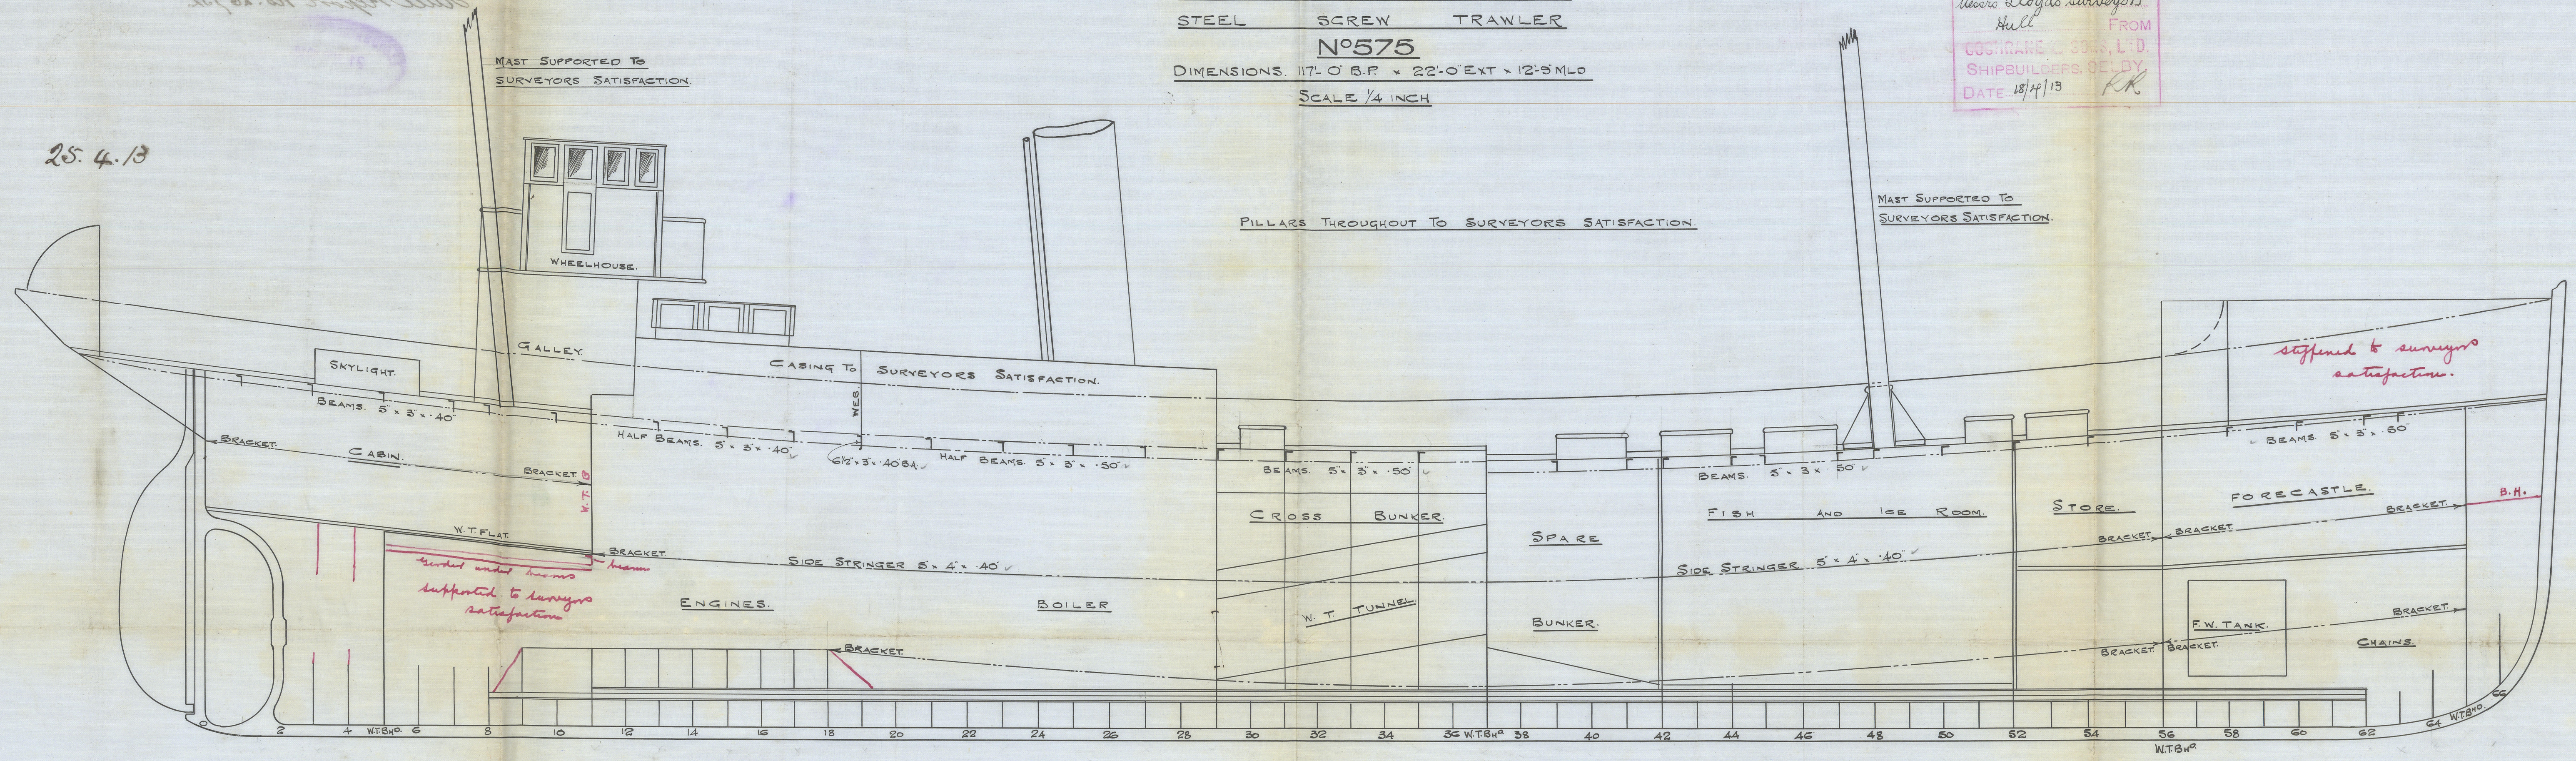

Jan.  
23. 4. 13




Cochran & Sons, Ltd  
No. 575.

Profile and Deck Plan


Dimensions 117-0 x 21-87 x 12-75

1/2 Prince Lea

Hull Report No: 26792.

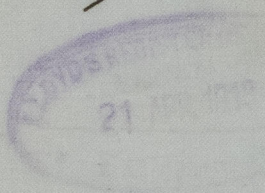

El. 22

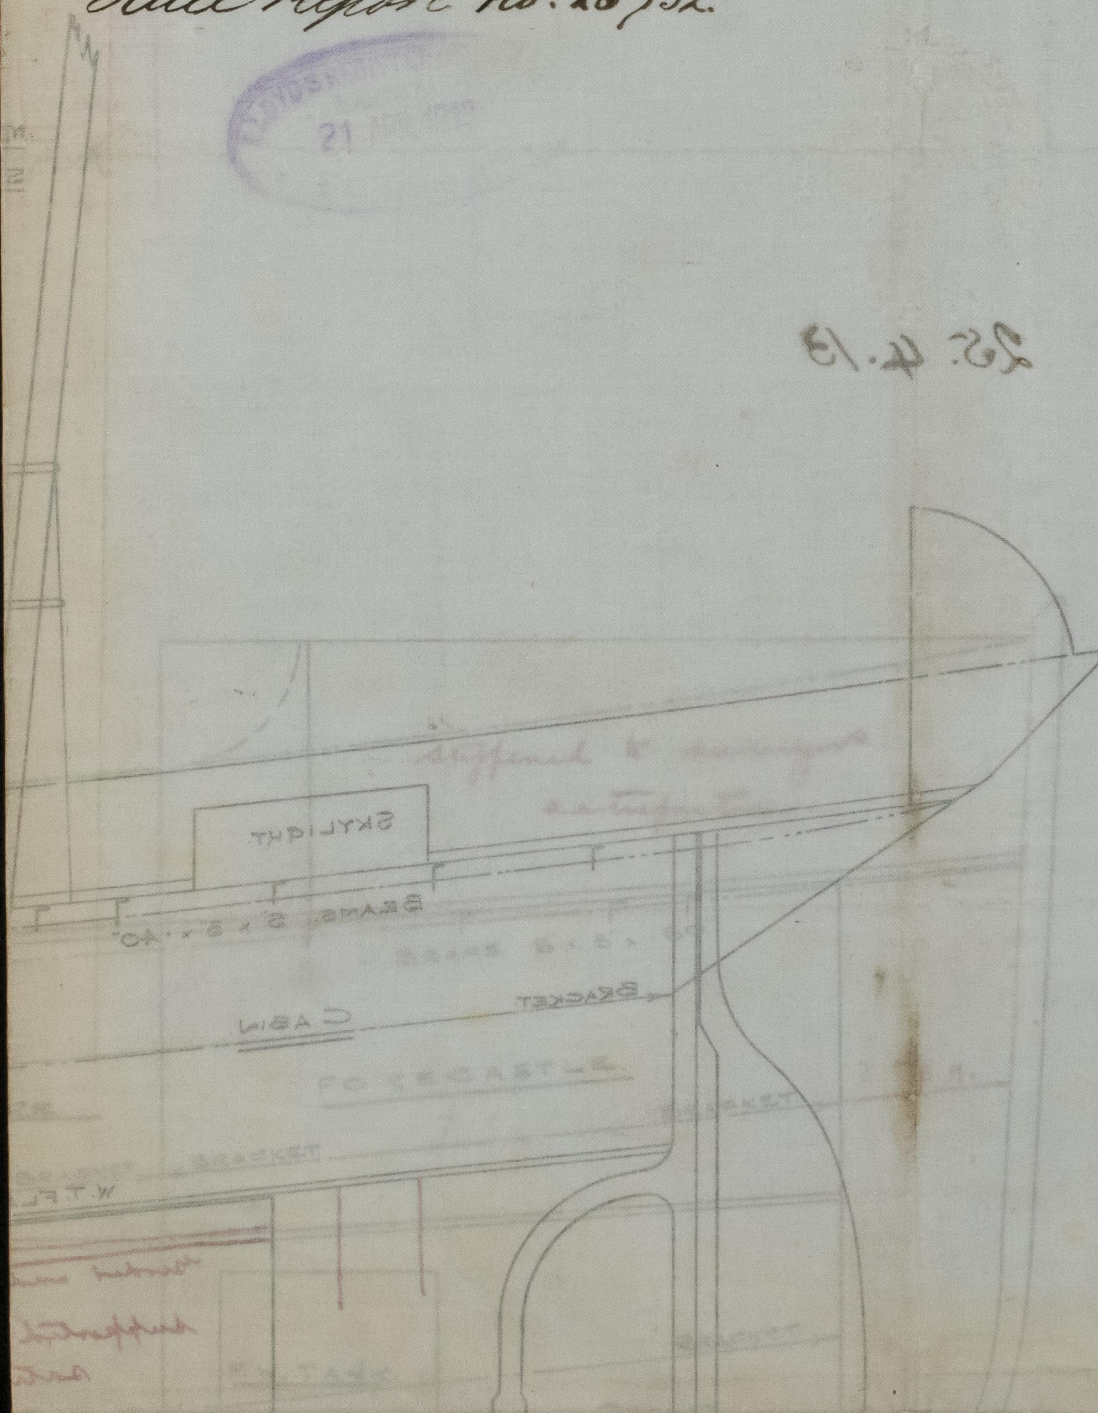

© 2020

Lloyd's Register  
Foundation

007698-007706-0093