

# LONGITUDINAL AND DECK PLANS

S.S. N° 716

DIMENSIONS 383'0" B.P. x 51'9" MLD - 52'0" EXT. x 21'5" MLD  
TO CLASS 100 A.I. AT LLOYD'S SPECIAL SURVEY






SCALE 1/8" = 1'0"

THE SCANTLINGS & DETAILS OF CONSTRUCTION NOTED HEREON ARE SUBMITTED ON THE UNDERSTANDING THAT THEY ARE MINIMUM WHICH WILL BE ACCEPTED FOR CLASS AND IF NOT THEY ARE TO BE AMENDED ERRORS & OMISSIONS EXCEPTED.

*Detail Plan of Hatchways to be submitted*

Scantlings of mast determined on angle  
FORE + MAIN MASTS 2 PLATES IN ROUND  
BUTTS LAPPED + 3R ABOVE DECK  
" " " 2R BELOW  
SEAMS LAPPED + SINGLE RIVETED

SHEER FORWARD 120"  
" " " 66"  
" " " 60"  
" " " 33"  
TONNAGE COEFF 130"  
ROUND OF BEAM 15"

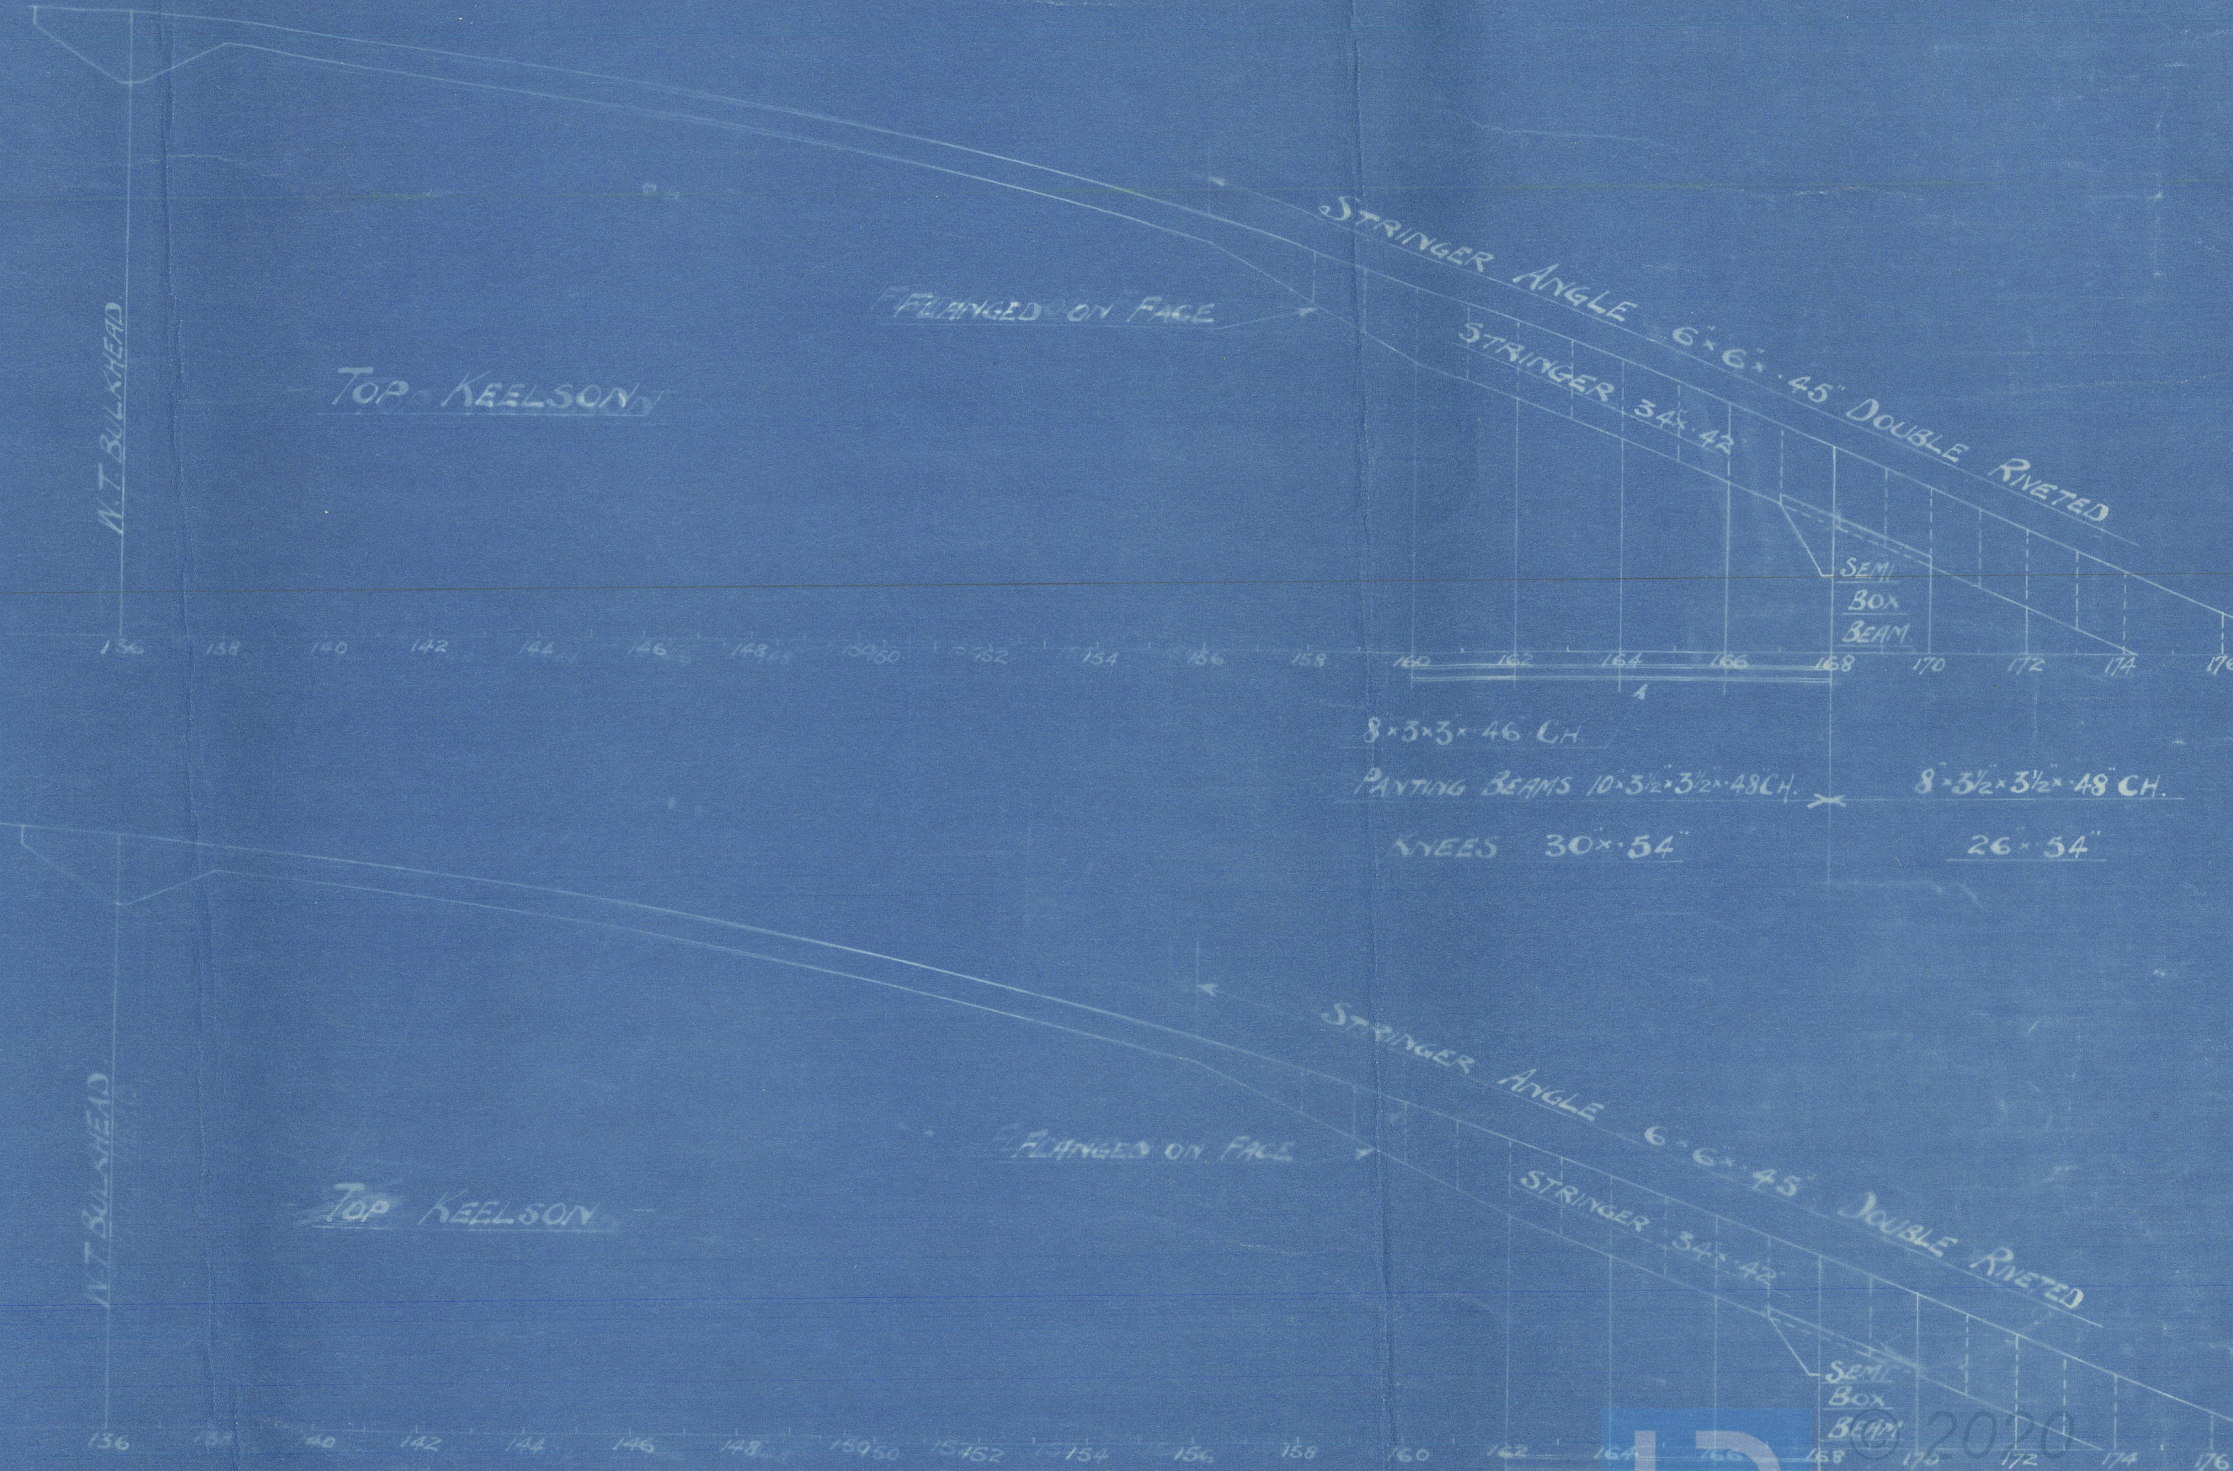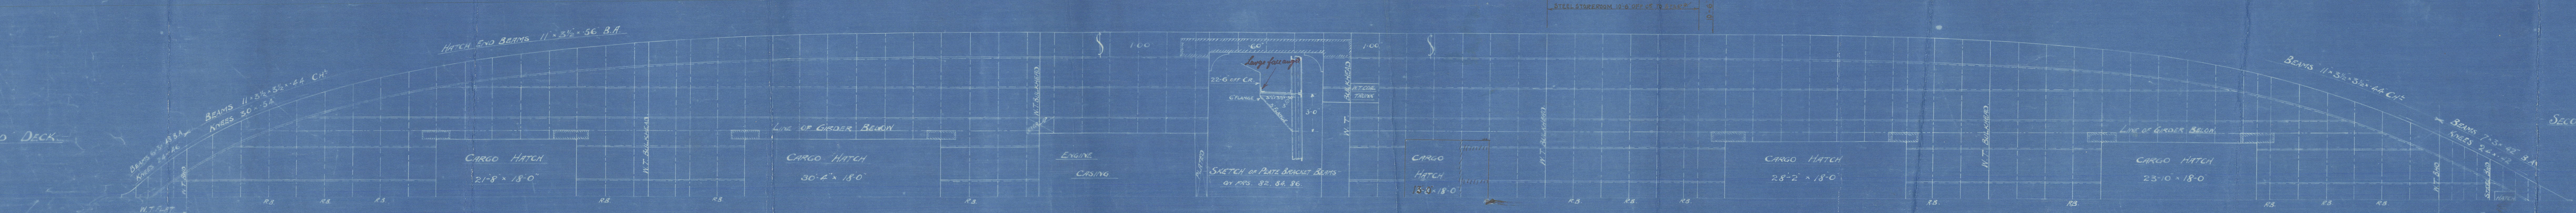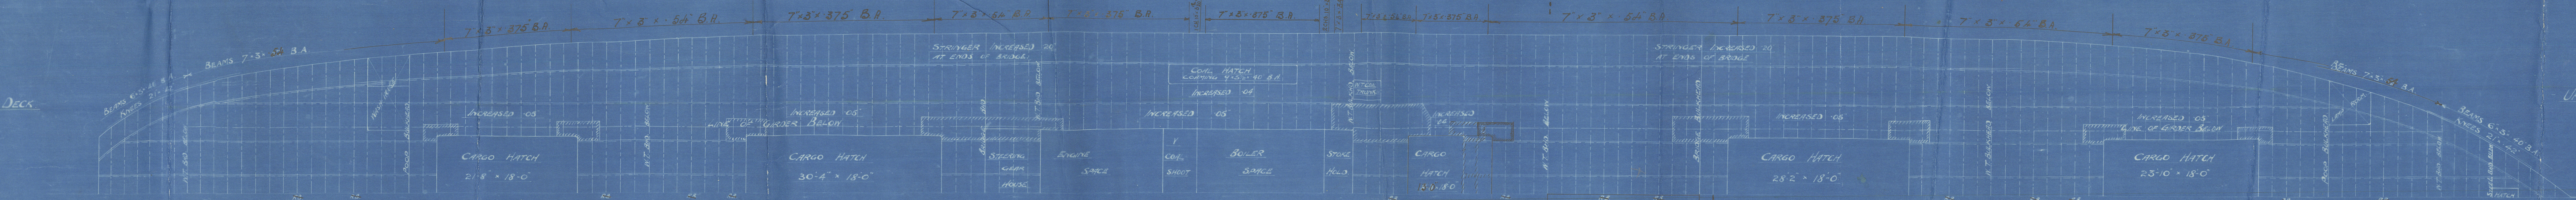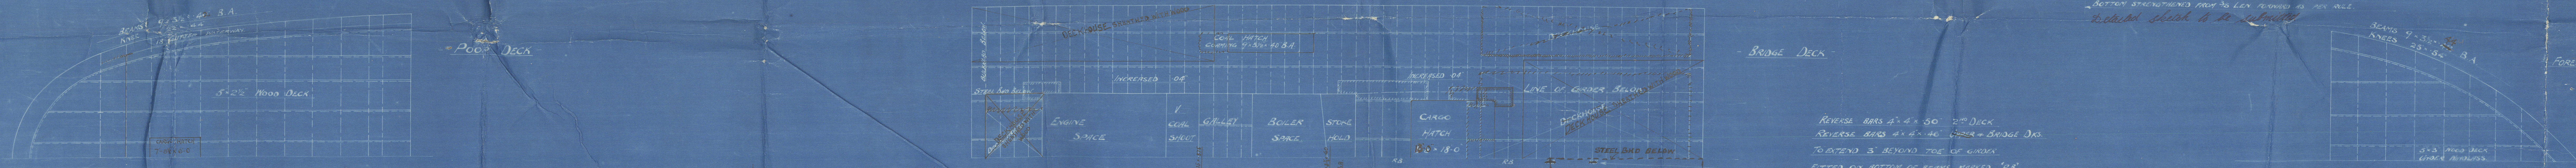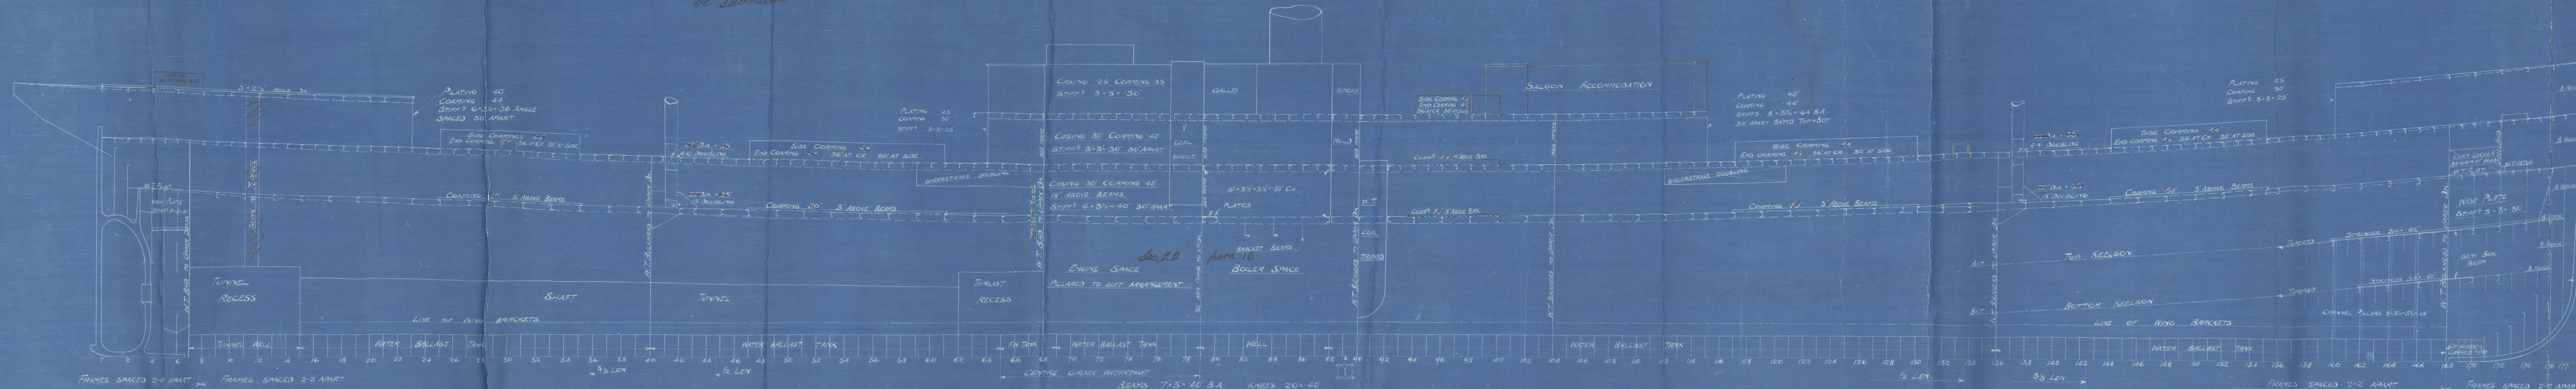



Lithyons Limited

No 723

Longitudinal plan

Saint Nebe

hh R/R R/R No 17493

Russian



Now

Rio Dulce

EX. AFRICAN EXPLORER

D 208 - Sec 2

P/D



© 2020

Lloyd's Register  
Foundation

007698-007706-0151